#324

Plat of Survey No. Miscellaneous Claim No. 50

Section Blk. 25 in County Add. Township 11 Range 5

Scale: 50 Feet Chains to the Inch.

Field Notes recorded at page ....., Vol. ....., Record of Surveys.
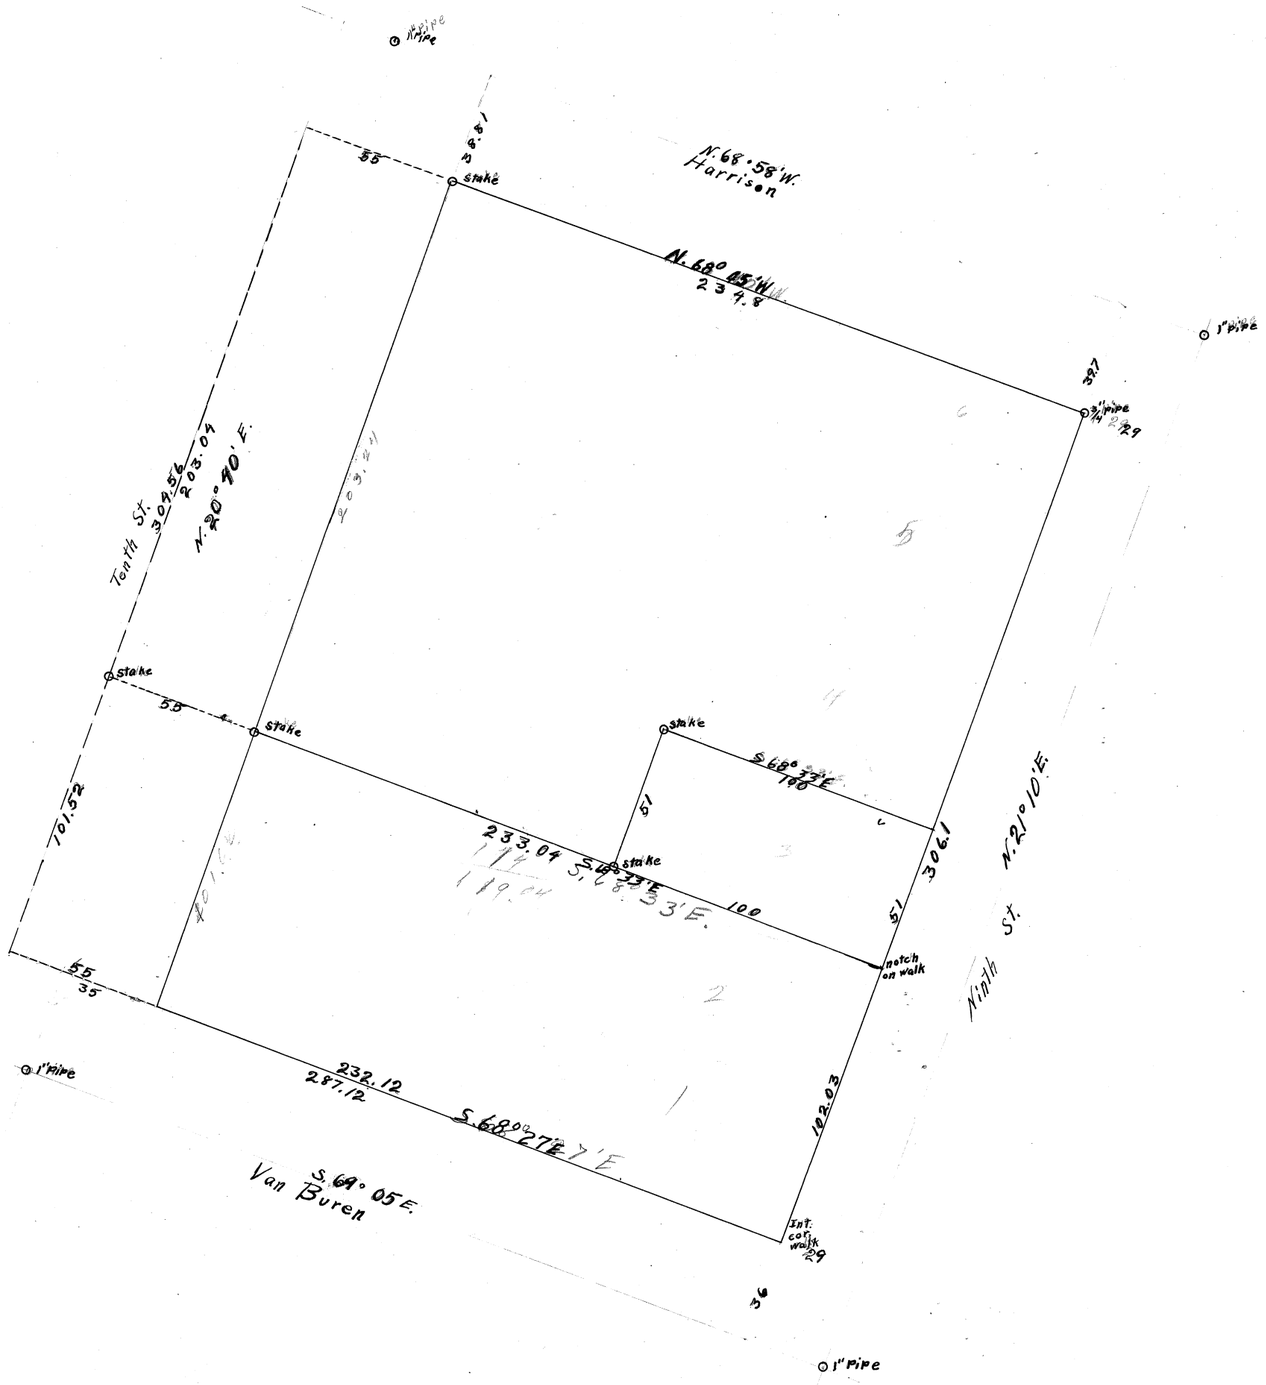
MADE FOR A. J. Johnson