#325

Plat of Survey No. 82 continued Claim No. 57

MADE FOR W. R. Standruf

Section 2 Township 14 Range 6

See Dick Kiger Survey No 82

Scale: 2 Chains to the Inch.

Field Notes recorded at page [illegible], Vol. [illegible], Record of Surveys.

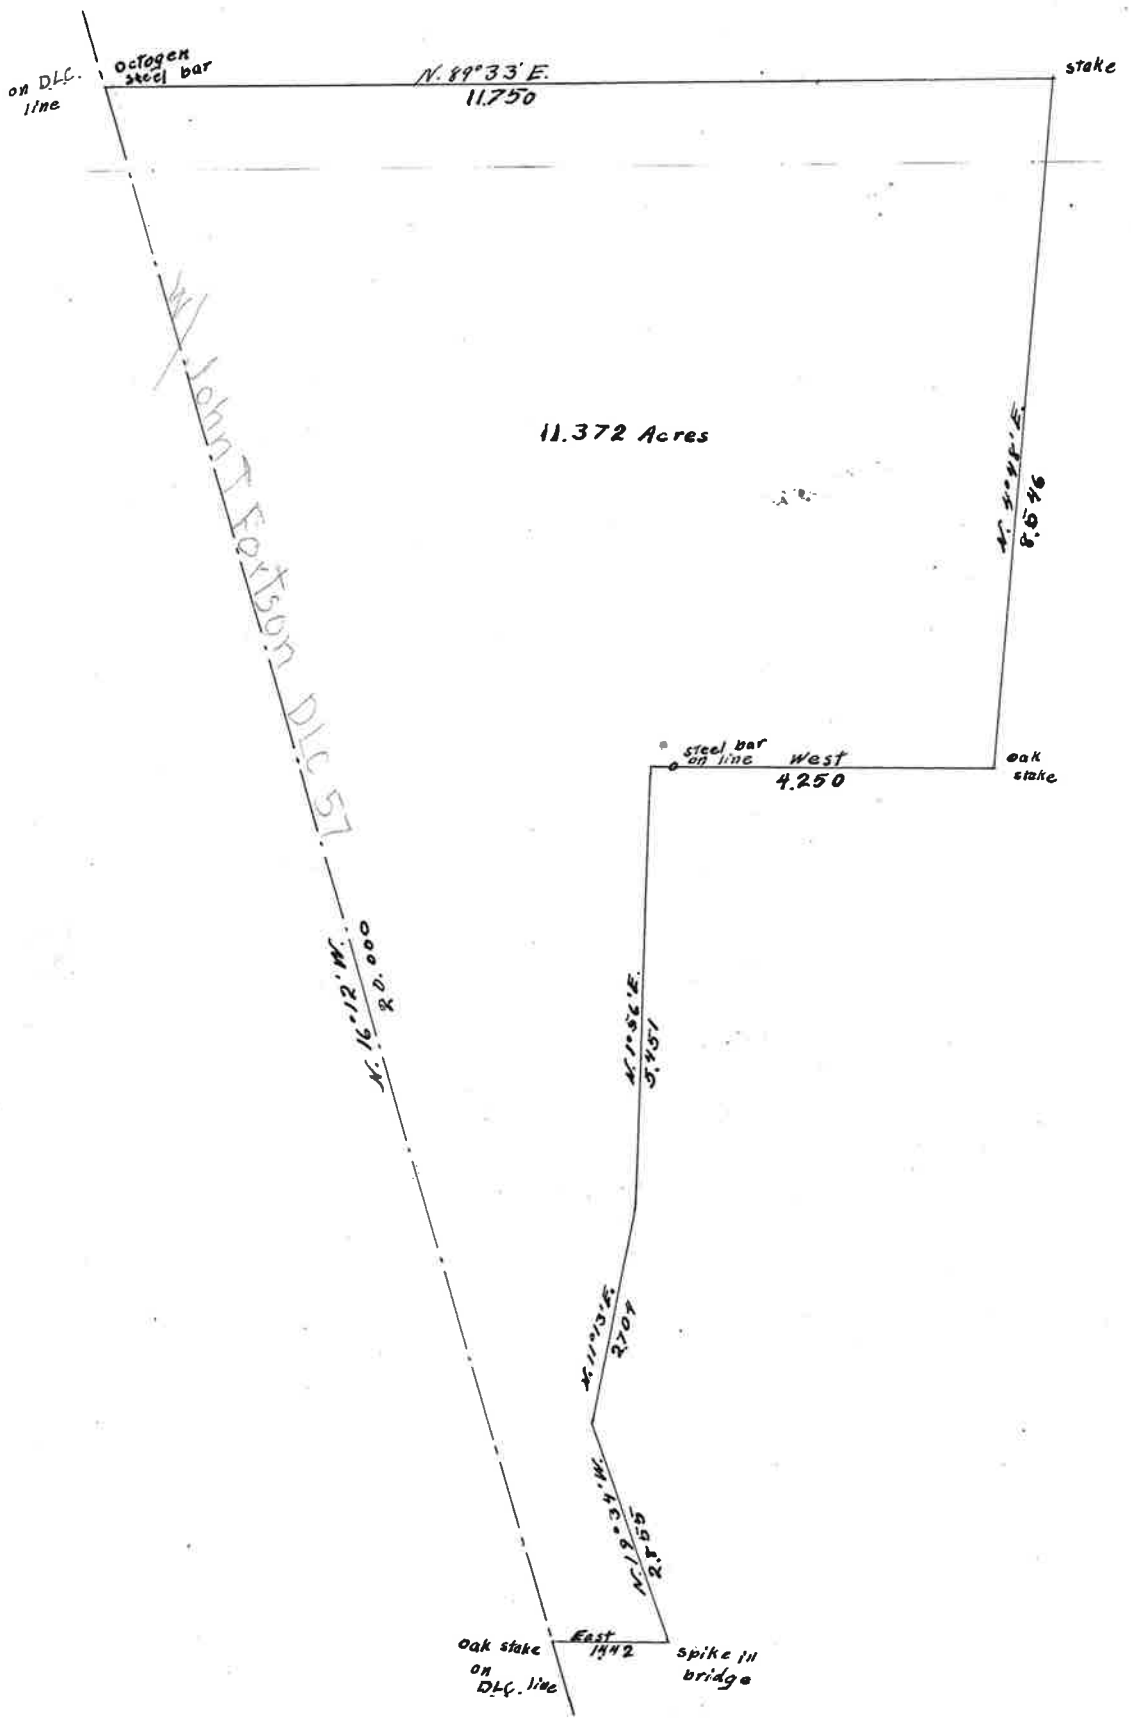

2

14/6