C.S. # 336

Hardcopy City Plat 13

also see notes in file

F. B. 17-37

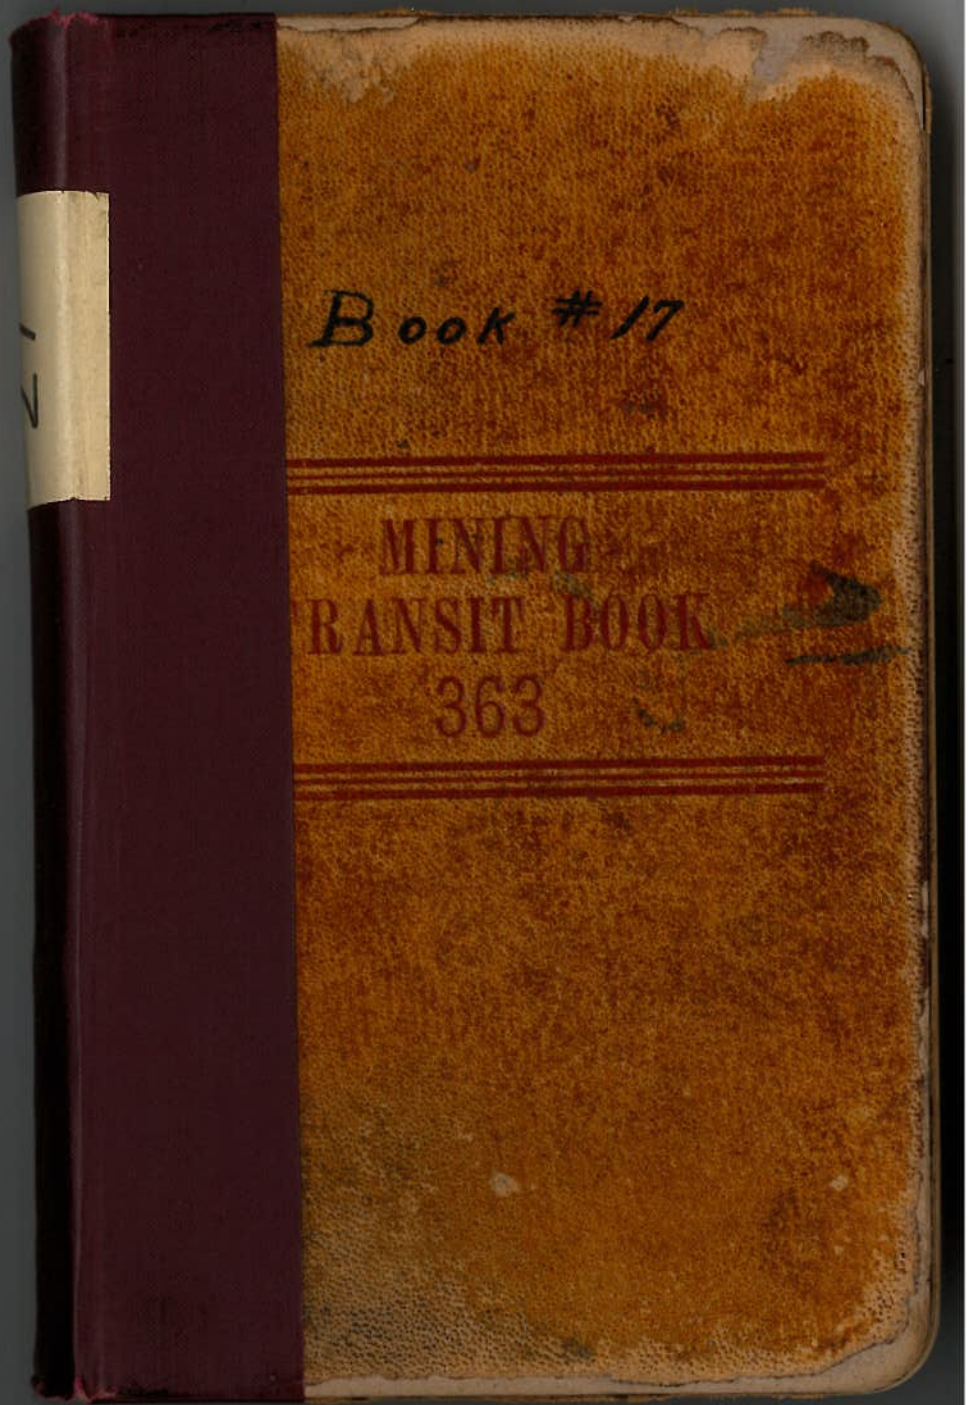
Book #17
MINING
RANSIT BOOK
363

Miscelaneous #458 June 9+10-4
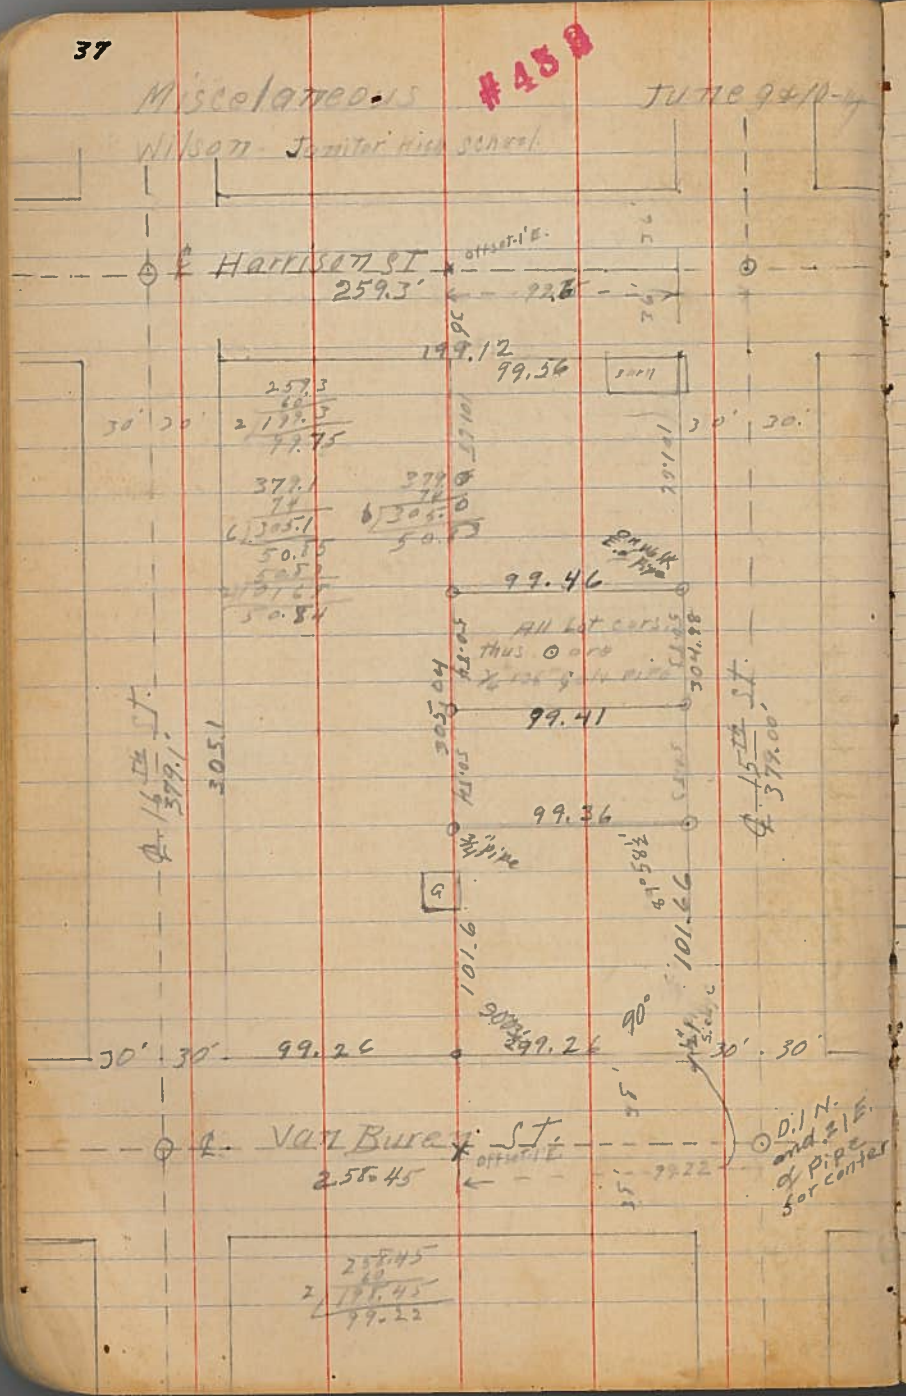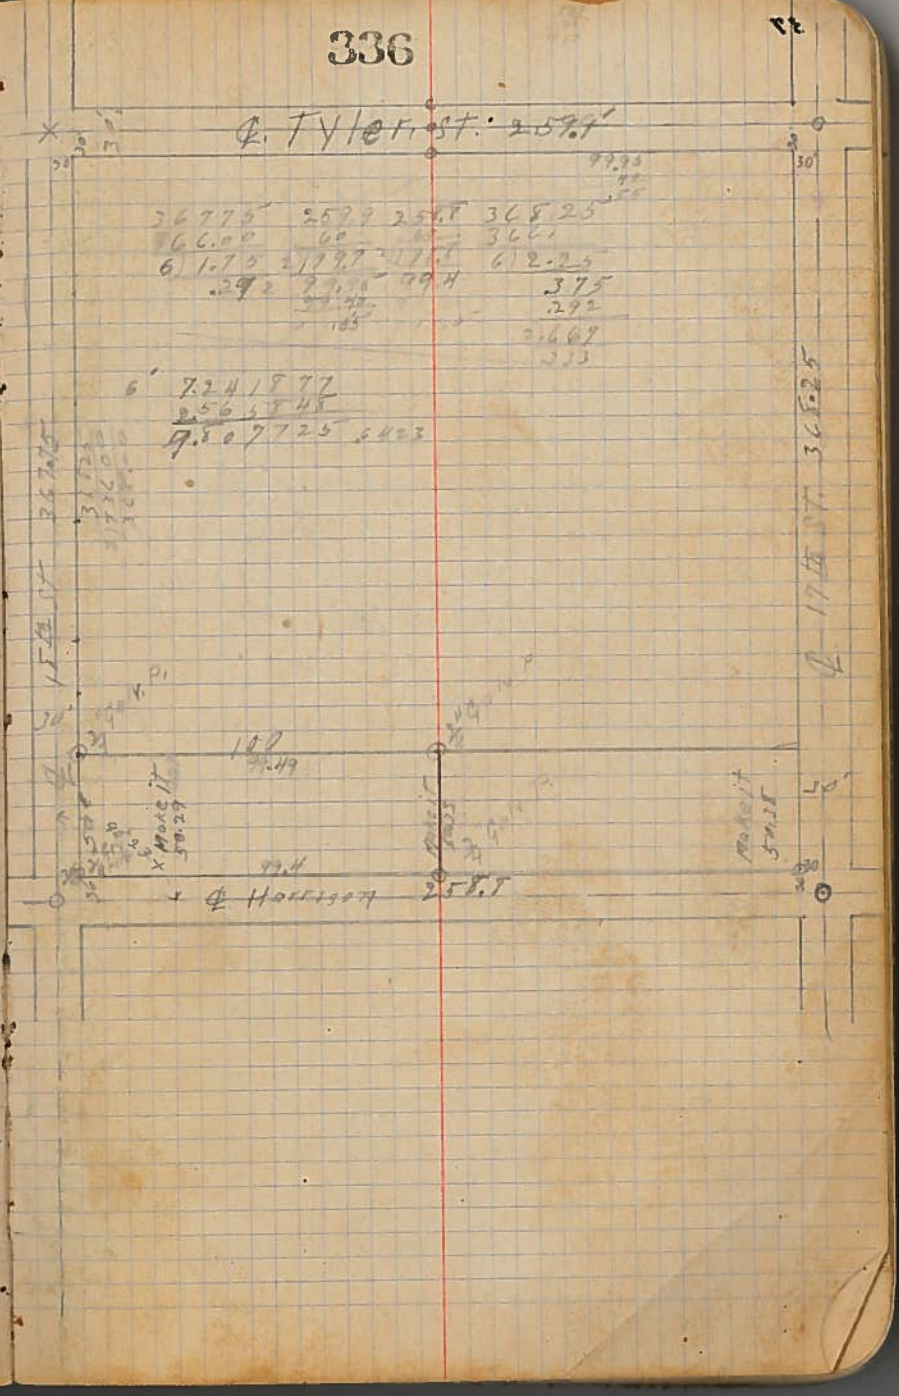
Wilson Jr. Inter. High School