C.S. # 340

See notes in file

F.B. 12-80

6 CHAINS

FIELD BOOK No. 12, PAGE 80

#340

80 Continuation of Survey #129 For J.G. Taylor to Ingle
Beg. at S.E. cor. of S.M. Strouts Cl. #18
Tp. 11 S. R. 5 W.
S. 20' E.
correction E. 3'
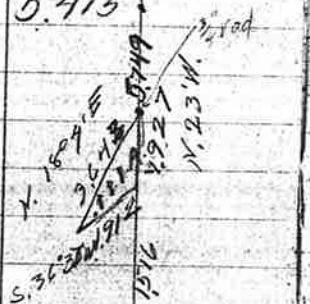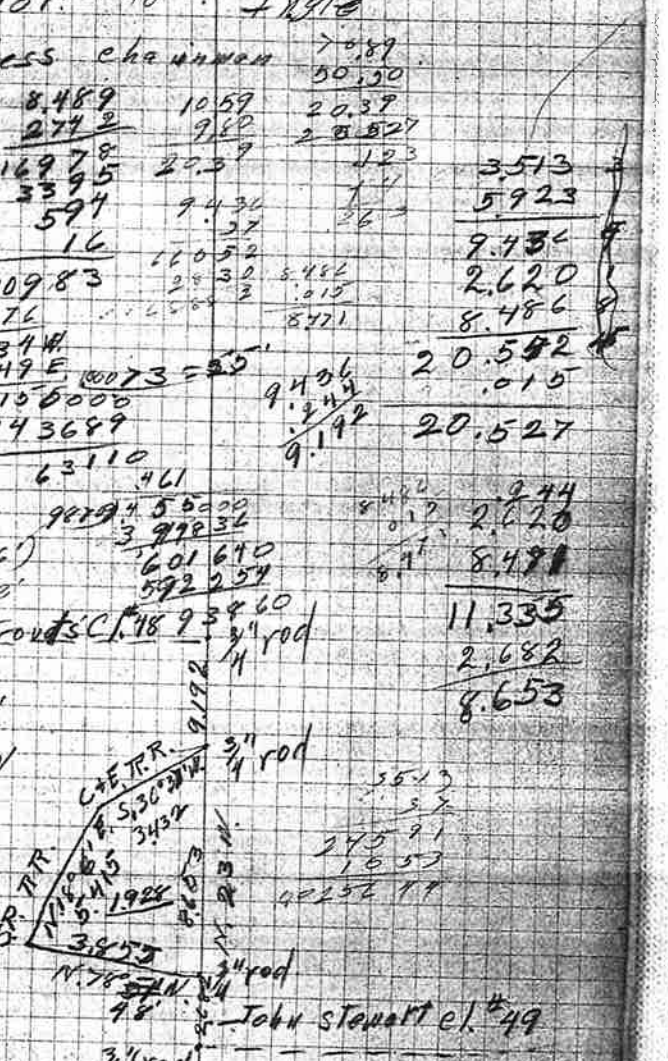
1			3.513	
2			5923	-.244 set 3/8" x 18" rod offset
3	L Left 3°51'	1°30'	2.627	.176 E. offset
4	L Right 1°25'	1°10'	8.491	.210 W.
			<.015	
S.W. Cl. #49			.049	
Striking W. of cor. John Stewart Set 3/4" rod 26" long.			Orig. cor.	2 stumps Std.
From cor. D.L.C.				
5	N. 23' W.		2.682	3/4" x 22" rod
6	N. 78° 28' W.	2°20'	3860	3/4" x 20" "
7	S. 36° 30' W.		3.432	(From Δ 2 +.244)
			0.415