C.S. # 345

F.B. 11-6

6 CHAINS

6

S 89° 45' W — 3.656 ☐ chamfer stk
N 4° 30' E. 5.015
N 89° 45' E 10.170 Stk to

— Description —

Misc. For W.T. W. 1/16 S —
from pt 20 ft S on W line N div.
of Ref W.T. & Edm. mile —
thence East by needle to Cen. of Co Road —
= 48.00
5.14 to Edge

Alternate N 65° E — 16.25 to be calc
from E ast to ℄ Co. Road. 32.000
6.970

Distance bet two Routes 6.852
Bing from ℄ of Paved Road to
S 5° 20' W 26.195

24.58
.913
25.493 N 89° 44' E

25.48' E of N.W. cor. N 89° 44' E 16.185
to Cen State Road —
N 58° 22' E

Direct Nov. 22 -12
Hor ∠ Vert ∠ Time
1 45° 38' 11° 16' 3h 13m
2 45° 51' 11° 8'
1 45° 28' 11° 31' 3h 15m
2 45° 42' 10° 54'

Simon Centre Line

38.97
16.27
55.24
53.08

Road —

Note:— Location unknown
Stated to Strike East 1.505
Chained from Angle pt on 1.505 West of ∠

#344 Survey #130 — A. SW¼ 28/13/7

CS 345
F/B #11, PG 6-8

Beg at 24.28 / 32.33 Run N Alt 28/29.

1	∠ Left	H° 28' W — 3-20	2.982
½		∠ 15° 00	4.421
2 across creek		—	2.732
1	∠ Right	16' — + 5° —	4.819
5		+ 23° 20	4.381

C.S. 345
F/B #11, PG 6-8

O. B. Reed — et all — #345

1-30
2.982
21.899
26838
2673
238
2
29761
409770
208327
26784
119
23.6230

4.819 4.381 4.421
91699 22819 39569
43371
4337
28839
4
8
43004 40823 39789
438 26522
350 2211
39
1
42702

1235 W
2.732
16.13 W

4.800
51.400
19200
2000
20
2.776
4.870
3.732
4.800
0.023
18.801

6		26°20'	5.024 -.213 W
7 —	∠ Right — 12'		4.593
8	∠ Right 1°09' —	15°30'	6.177
			1.740
	Angle R 15°20' to Cor — 14.30		5.110
	Line corrects East 1°48' f = .031301		
	Back to 12 - ∠ Left 50 4 S		1.225
	Set Cor at .405 E =	N49°20' E = 533	= 6.368
	Set S.S. 14 x 10 x 6 -		for Cor.
	Maple 30" S 79°30'	E	.128
	" 24" N 53°30'	W	.470
9	N 49°20' E		1.341
10	"		3.380
11	N 66°26' E —		4.150
12	"		.700
13	"	-23°30'	.671
14	N 78°29' E -		3.564
15	N 76°26 E		2.102
16	N 66° 21' E		4.495
17	N 53°49' E		3.402
18	N 64° 12' E		1.060
19	N 65°33' E	-3°15'	2.191
20	N 76° 26' E		1.642
21	N 56° 17' E		1.284
22	N 43°34' E		1.593
23	N 87°33' E		1.819
24	N 68°25' E		2.260

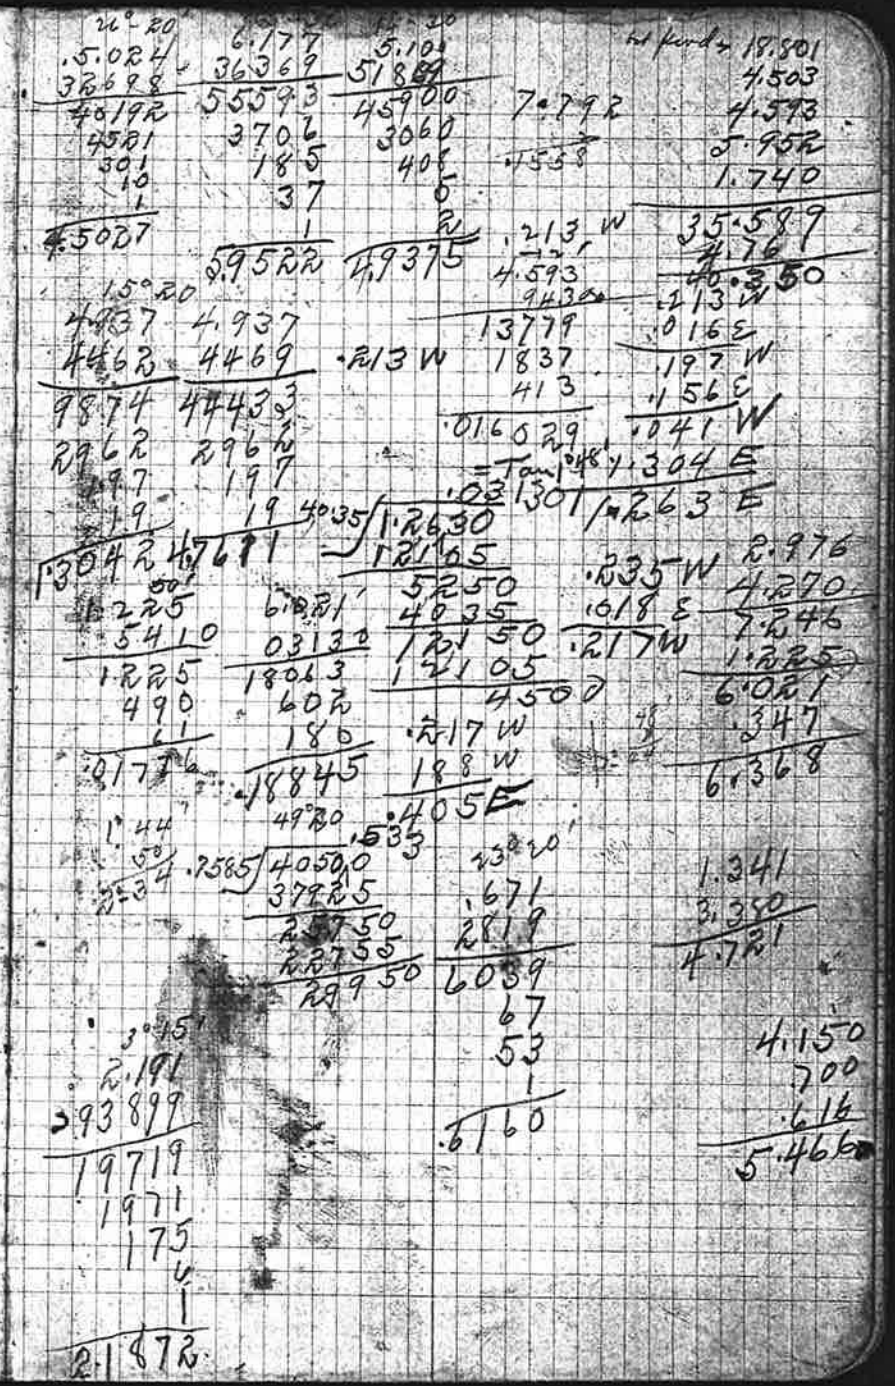

8

25	N 38° 30' E -		1.531
16	N 74° 37' E -		1.933
17 -	" "		1.605
28	N 72° 15' E -		2.088
29	N 65° 22' E -		2.063
to ℄ sec	N 62° 38' E		1.785 ±
			0
Begin at 1 28/33	stake orig.		
North by needle.	- 17-15		2.348
"	- 17-10		1.063
"	- 20° 30'		2.133
	- 16° 10'		1.138
	- 26° 55'		2.599
	- 26° 40'		3.581
	+ 8° 50		2.081
	- 5° 20'		7.058
	- 14° 55		1.998
	- 29 -		1.789
30 at Creek - →	- 27° 50		2.819
	+ 13° 50		5.000
	+ 18° 30'		2.225
to fence	+ 12° 10'		3.223
+ △ 30	mad back		.74

17-15 — 2.348 — 20559 — 21132 — 1174 — 117 — 23423

17-10 — 1.063 — 54559 — 95622 — 531 — 53 — 4 — 2.0155

20° 30' — 2.133 — 76439 — 191977 — 6397 — 1279 — 12 — 1.9976

16° 10' — 1.138 — 4069 — 10243 — 683 — 4 — 1.0928

26° 55' — 2.599 — 76198 — 207922 — 23392 — 25 — 15 — 2.3172

26° 40' — 3.581 — 36398 — 286482 — 32222 — 107 — 21 — 1 — 3.1999

8° 50' — 2.081 — 41889 — 187297 — 16647 — 166 — 2 — 2.0561

5° 20' — 7.058 — 76599 — 635222 — 63522 — 352 — 48 — 4 — 7.0227

14° 55' — 1.998 — 3669 — 17982 — 1198 — 119 — 5 — 1.9304

29° — 1.789 — 6478 — 14312 — 1252 — 71 — 10 — 1.5645

(30) 27° 30 — 2.819 — 3488 — 22552 — 2255 — 112 — 8 — 2.4927

13° 50 — 5.000 — 0179 — 12000 — 5400 — 1 — 1.7180

18° 30' — 2.225 — 3849 — 20475 — 9110 — 181 — 6 — 2.1572

15° 10' — 3.223 — 17379 — 270702 — 22611 — 96 — 3.1449

26.939 — 14° 0 — 1.99 — N 0