C.S. 346

COUNTY SURVEY Nº132

Thos. G. Hogue D.L.C. 77.

Sec. 13 T. 12 S.R. 5 W. Will. Mer.

Scale 1" = 4 chs.

W. C. Galloway C.S.

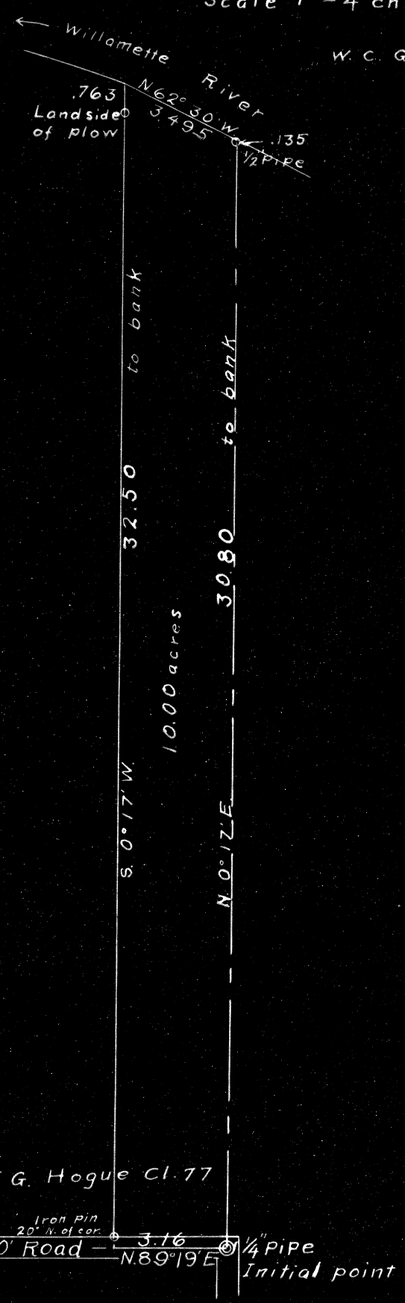

State of Oregon } SS.
County of Benton }

This is to Certify, That I, W. C. Galloway County Surveyor of Benton County, Oregon, have surveyed the following described tract of land to-wit:- Beginning at a 1¼" pipe, the S.E. corner of Thos. G. Hogue D.L.C. 77, T.12 S.R.5 W. of the Will. Mer. in Benton County, Oregon; and running thence N.0°17'E. along the east line of said claim 30.80 chs. to the south bank of the Willamette River; thence N.62°30'W. 3.495 chs. along the south bank of said river to a point .763 chs. N.0°17'E. of an iron, thence S.0°17'W. 32.50 chs. to the south line of said claim, thence N.89°19'E. 3.16 chs. to the place of beginning, containing 10.00 acres.

That the plat hereto annexed and the distances and angles marked thereon are a true representation of such survey and of the land so surveyed.

That said survey was begun from a definite and certain monument which can be located by any competent Surveyor to-wit: A 1¼" pipe the S.E. corner of Thos. G. Hogue D.L.C. 77, T.12 S.R.5 W. of the Will. Mer.

W. C. Galloway.

State of Oregon } SS.
County of Benton }

I, W. C. Galloway, being first duly sworn, say: that I am the surveyor above named; that I have read the foregoing certificate and the same is true as I verily believe.

W. C. Galloway

Subscribed and sworn to before me this 13th day of Nov. 1922.

Notary Public for Oregon
My comm. expires Apr. 3 1923.