C.S. # 348

Hardcopy 14-6 #17

also see notes in file

F. B. 14-19

F/B #14, Pg 19

19 #34 Cont Survey 103 FB 8 Pg 39

Cont. From Book 8 Page 32

Cameto + Set △ 55	103 E. 10	East	4.798	Set E. .147 for 1/4
	9.03' W. correction E. 13' (S. 11 E.)	12°51'	+.016	
S.W. of Chateau Hawley			.164	
1/2" galv. pipe		stump and hole		
Bl Oak 4" N. 9° E. .328 chs.				
" 4" N. 70° W. .090 "				
	S. 03' W. correction 20' E. (S. 17' E.)	4°30'	7.403	Offset E. .143 Offs
Left	3°40'	8°35'	2.261	
			+.154	
Striking W. of cor.			.077	
S. 87° 30' W.			Minor .154 +.077	
correction N. 10'			5.545	
			5.416	
		19°35'	2.596	Sets .113
Set South 20' E. .113 — Inc. 1140				
S. 89° 40' W.			7.540	
			.826	
			N. 140	
W.C. cor. Set 1/2" galv. pipe				
~~Oak 28" S. 79° E. .187 chs.~~				
S. 89° 40' W.			1.938	
Oak 26" S. 88° 45' E. 2.125				

Continued on Pg 33 2
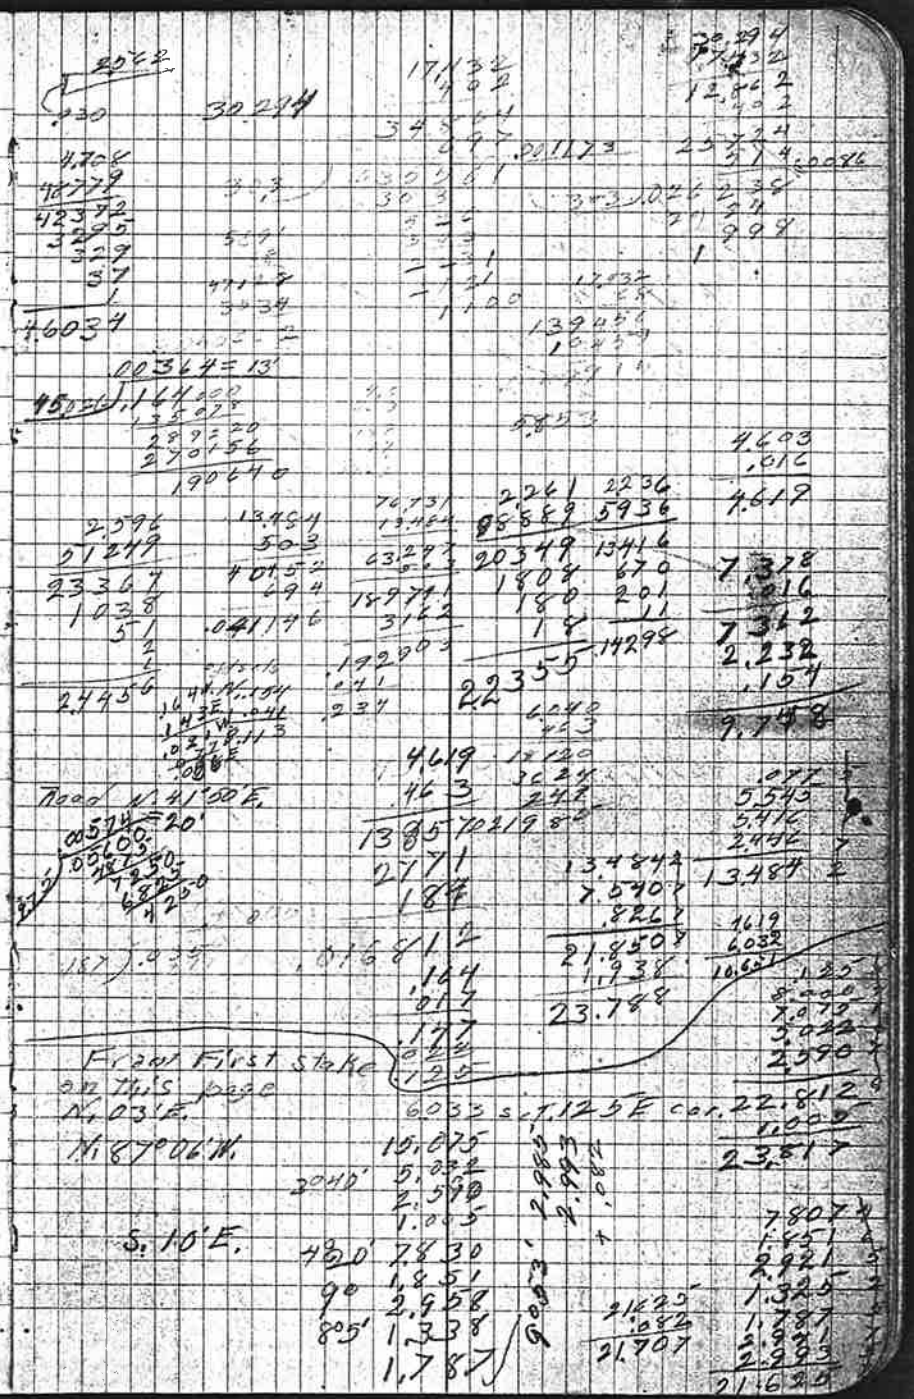
N. 87° 54' W. △