Plat of Survey No. 133 #351 Claim No. 47

Section Township 11.5, Range 4 W.

Scale: Chains to the Inch.

Field Notes recorded at page , Vol. , Record of Surveys.

Fieldbook 11 - pages 3-

MADE FOR John Rogers, Union Iron Reynolds & J. H. Hill

- 1222 -

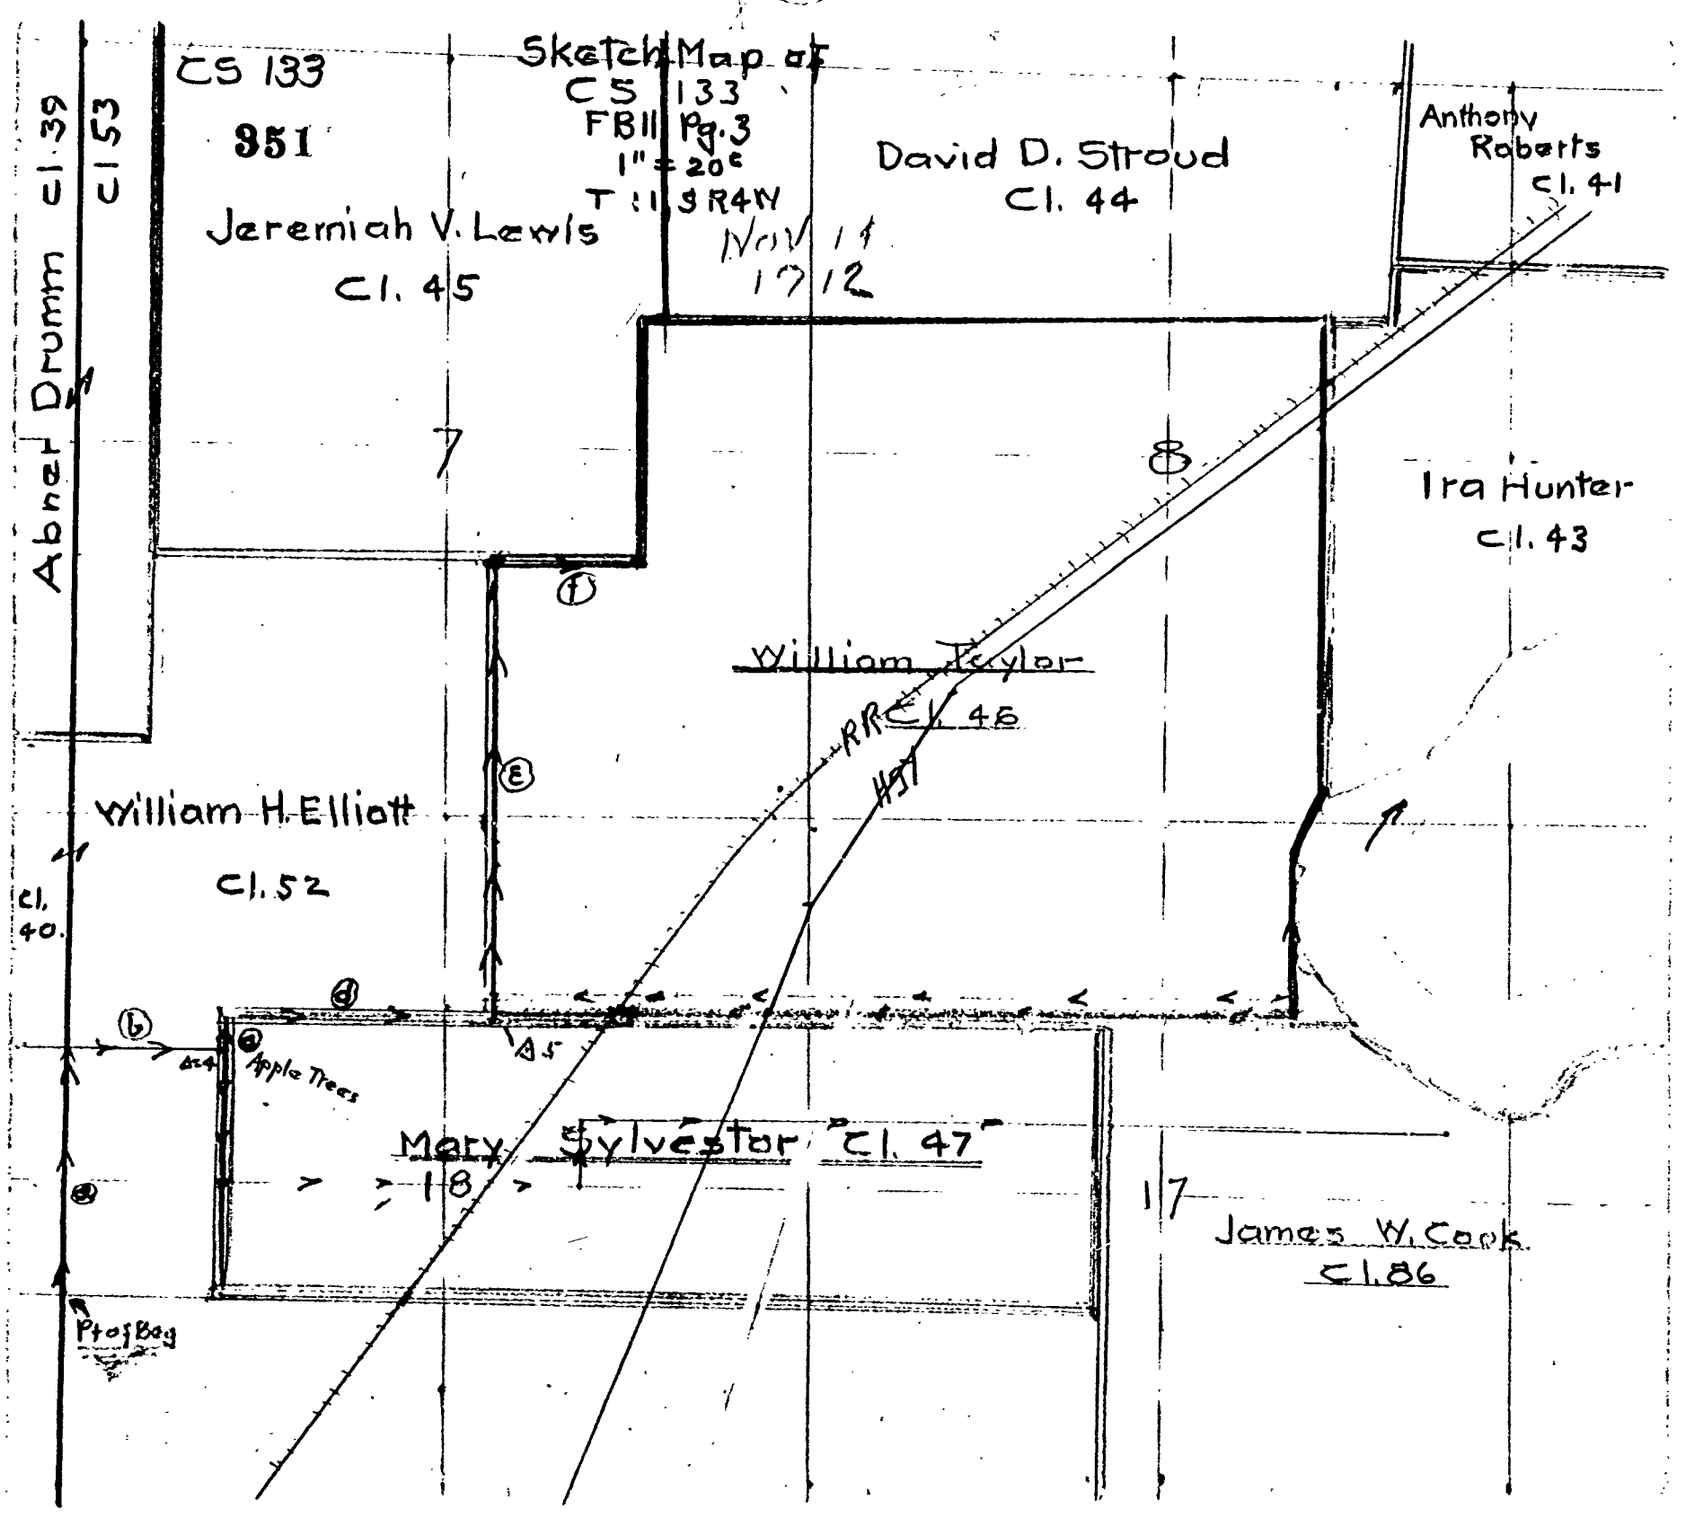

CS. # 351
F/B # 11, Pg. 3-5

3 #351 Survey No 133 { John Kiger / J. N. Maragden / Reynolds-

Beg at AP. = .053 out from Tree

0 Thence Nov. S Line of Sylvas base

1 Near div- 17.462

2 Near ⌐ 10.860 = 28.398

3 Striking E .236+ of Stone.

Thence East N 89° 45' E = 5.074

= + .236

4 Near ⌐ Set 3/4 X 30" blk pipe 11.973 = + .092 To N. 060 To Rail Co

Mkd Apple Trees 18" N 52° W 15' W 30°

5 Thence North- Near ⌐ 4.103

⊕ found stone at + East

Set 3/4 X 24" blk pipe at Cor-

Mkd. chiseled N 89° 25' E. 580 16.100

6 Thence N 89° 40' E - Near - Elliot 6.983 = 30.983

no find Set 3/4" x 40" blk pipe at — .181 + N. 182

Bng line = N 84° 00' E - 30.710

7 Thence N 20° E - 18.679

24.00

9 4.558

N 44° 22' W .650 To 3/4 pipe at D.L.O

= + .465

Thence N 80° 45' E - To pipe 16.460 Lewis

Of D.L.C. Striking S .409

Back to Rear at Δ 5. = 3/4" pipe - Thence South-

10 14.257 = 14.692

10 at Div pt + .435

Thence East 32.000

11 Cen R.R. Track 2.368

12 Cor No E 5.132

T 10 S R 4 W WM Nov 14-12

Chain: Elmer Mc

John Reynolds - my Field

Bng. of S. Line S 89° 59' E 16.903 bet

pipes - S and Log Stones -

.236 / .053 = Tan - 18° 00' 00" 537

34.07 / 18.30 / 17065 / 12450

N 90° 24' E = 10221 Keep 360 South

CT 9-5 24290

N 1° 16' E - 4.191

1.0049 11301 / 90310

32.50 / 32.66 / 32.50 / 11301 / 3390 / 101

16000 / 13000 / 30000 / 14791

30.710 / 24510 / 39500 / 34368 / 5132

44° 22' 30" / 45° 00' 00"

.650 / .650

3996 9417

3900 4550

585 65

58 26

1 5

4544 4611

17.8800 / 9.4001 / 17.9800 / 715 / 160 / 17.9675

H 076

1 17.462

2 10.860

28.322

28.398

076

28.322

.048

.020

28 - 3 11.973

236

092

11.301

28.590

.130

32.660

24.000

6.983

30.983

18.679

Rail 1.000

4.558

17.237

47.2 37

47.2 46.2 70.2

47.2 1.19

47.2 1.13 1.20

14.25 4.43 5

14.25 4.43 5

14.25 4.43 5

4 |

Set 3/4 x 30" b/k pipe at N. 376

13 Thence North. 7.81
at N.403 → Set 3/4 x 24" b/k pipe + 1.00 6 dec. NE.

14. Thence East. 17.105

15 Angle Left 8°34' 5.317

7.992

7.275 = 15.097

16 Angle Right 21°-12' 6.297 = 5.971

3.247

A17 5.677

A18 Near D & C line 6.569
Set Stub back 1.503

24.000
1.646

Thence South.

A19 on top of bank. .429

24.000

5.824

A20

To Cor. of ✓ Taylor & Pleasant Set 3/4 x 30" b/k pipe

fir 14" N 22° 30' E .170
" 26" S 47° 45' E .394
" 11" S 46° 30' W .625
" 14" N 43° W .309

witness Elmer Mayfield John Reynolds

Set Stub on A 19 20 Rad at 24.00 — 2.086

N 0° 3' W 8.149

Correction is 1.148 in 119. 1.726

= Tan 33' ∴ = .0095

8.34
7.992
7.275
15.267
48.889
137.903
13.6
12
1.221
122
4
150965

6.297
R 3239
56673
1889
125
18
1
5.8706
1.932
1.503
.429

17.971
7.810
5.778

7.810
63001
7810
23
4
7537
.027

21°-12'
58.50
52.31
6.49

17.971
7.519
25.788

3.950
63001
6950
20
6.974
2.974

17.105
5.317
15.097
5.971
43.390
3.247
5.677
52.394
6.569
58.883

8.149
6.974
1.175
.027
1148

58.883
429
59.312
24.000
5.824
5.423
2.553
97.112

403
92
1323 MM

5 N1 Court E from 420 5.433

A22 N at ∠ of 27°-00' to N 2.865 = on line

Court E to River .78 to W edge

S. to River .61. Ms to Old Channel 1.40

back to D.L.C. Cor N 1465 - S 1/4 3/4 x 24" Blk pipe

23. Thence S 89°-35' W- 7.961 5 set below.

Meas. to 12"10' 1.121

8.900

.528

9.873

24.00

A26 +6°- 4.272

25 16.000

1.808

A27 7.427

A28 near D.L.C. line

to 3/4 x 24" blk pipe +.174

119 East to N

Back to N cor S 88°27' W. 8.000

to 3/4 x 24" Blk pipe in Mound 4.226

Starting N from A1 — .406

#352 From FB 3 Pg 29

Continuation of Survey #16

Beg at 1 1/4" pipe at 7 cor Brown-

S 4° 30' W 5.015 Chapman Tuttle 5 Ms

S 4° 30' W 3.172 For Highway

S 89-45 W. 6.344 Chapman Tuttle

Chas. H. Brown

By deed 208.70 x 4/17.4'