359

359

152 5

359

SURVEY #152

Tp. 11 S. R 4 W. W. M.

Scale 1" = 5 chs

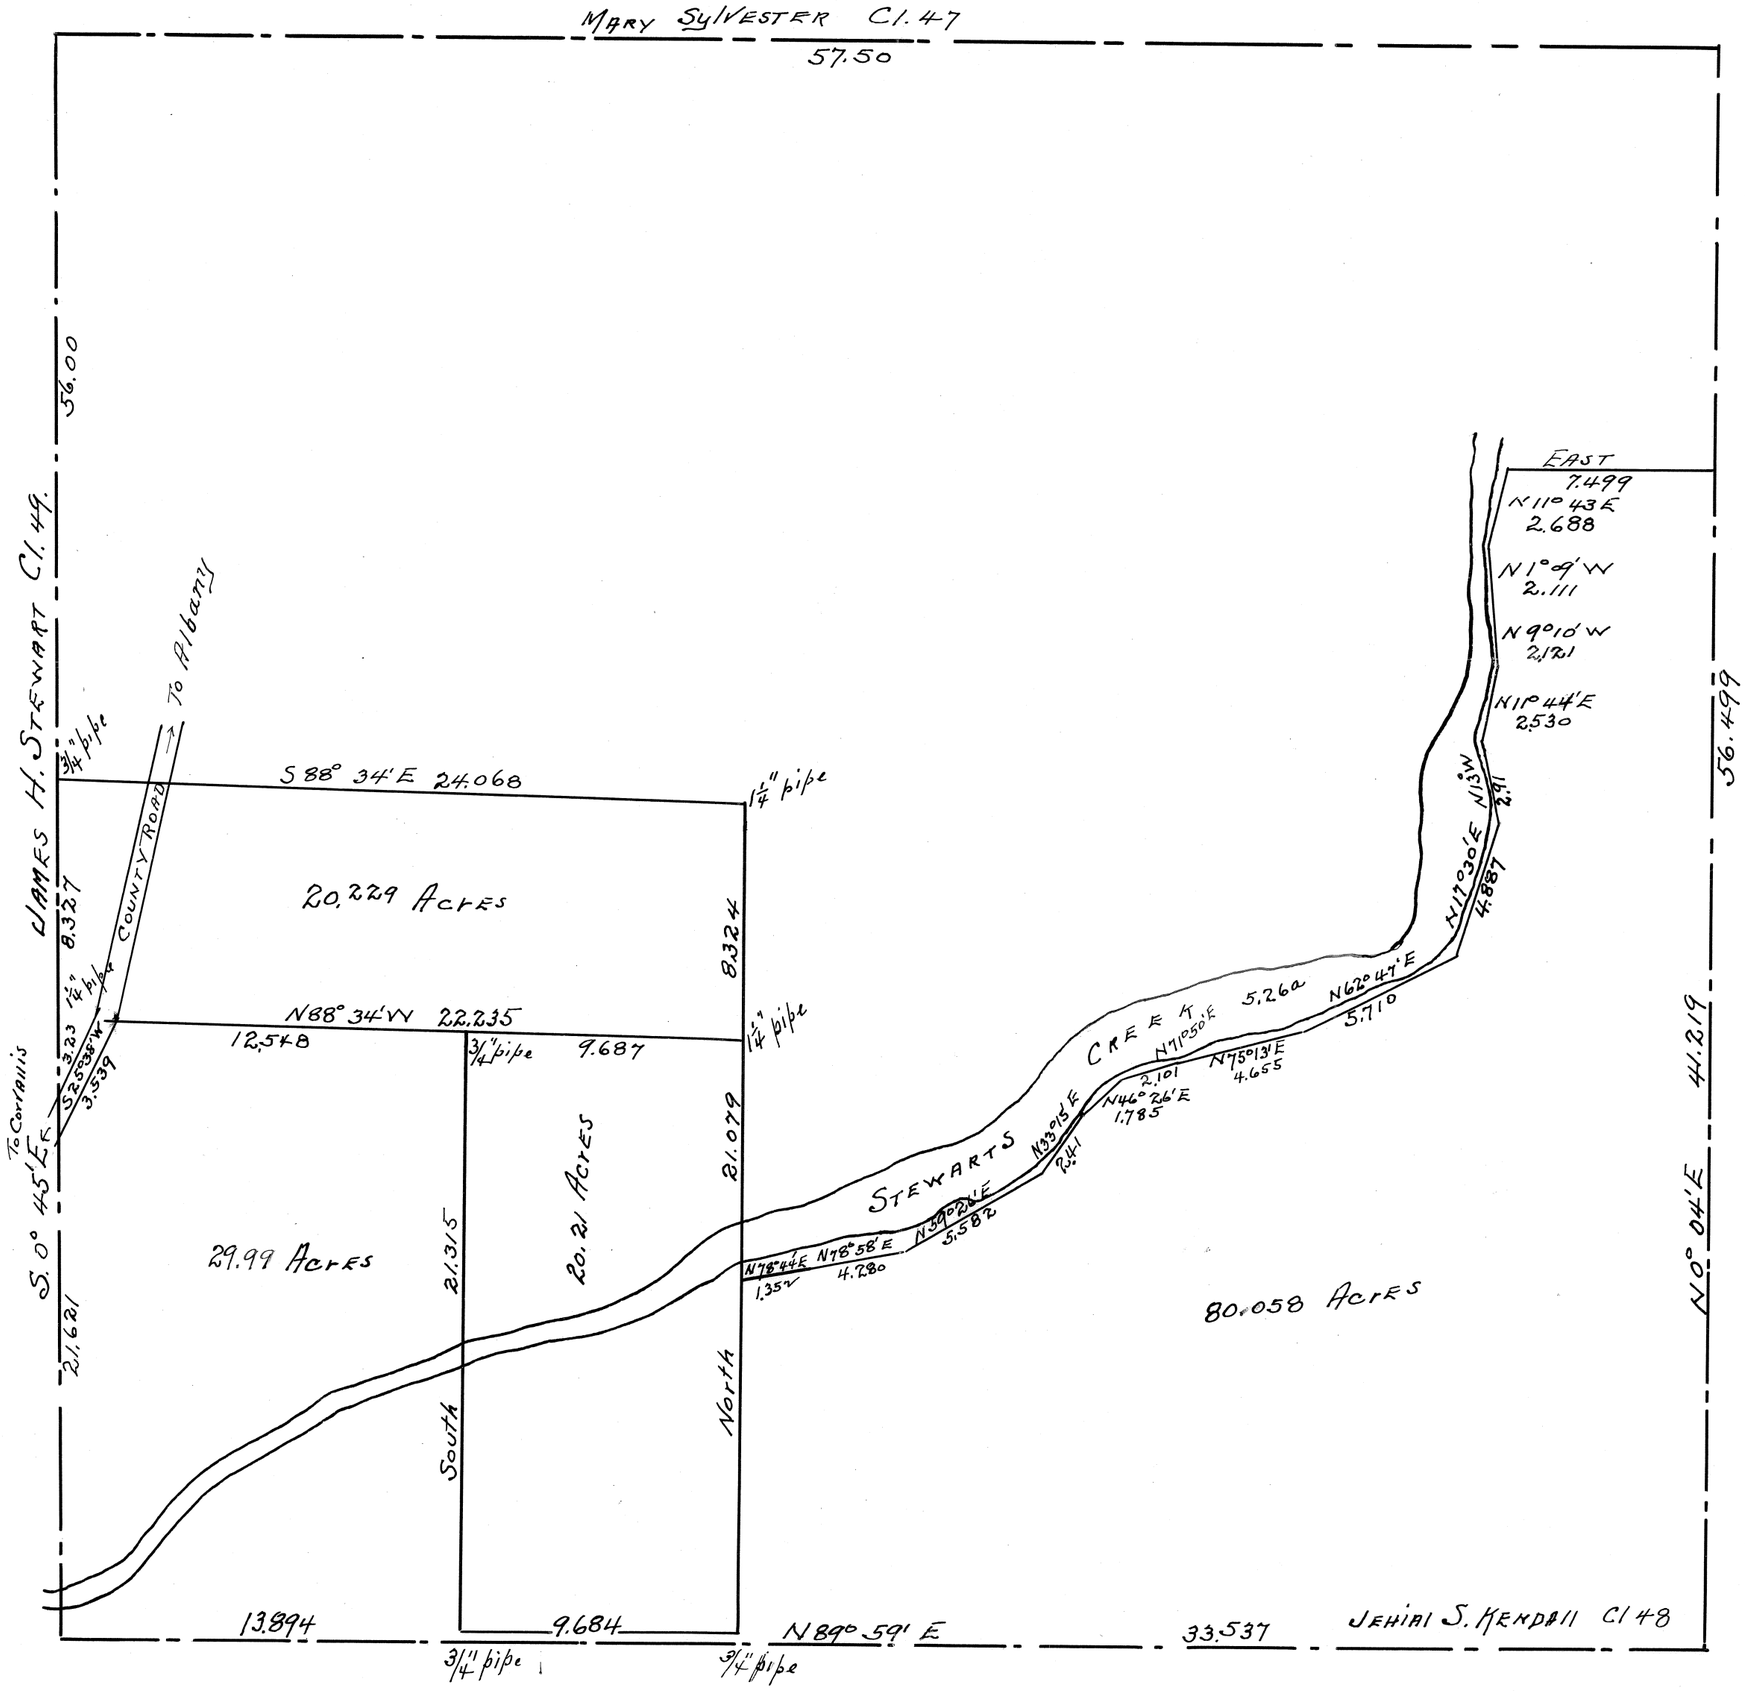

Book #13.

MINING
TRANSIT BOOK
363

34

C.S. #152 Burnap & Williams

Page 29

Beg. at Sta #6 on South line of Tundall					
Cabin and runs					
7	East.	∠R 1°-25'	—	7.499	.185 S
8		∠R 54'	—	7.968	.207 S
		"	—	5.189	
9		∠L 1°-15'	—	7.976	.213
		"	—	1.784	.185 N
Striking N. of S.E. cor. Cl 48:-				S. 035	
Back to Beginning and runs:					
10	West	∠L 1°-13'	—	3.849	.082 N
11		∠R-16'	—	6.820	.032 S
12	corrects 5.1'	∠L 22'	—	7.980	.103 N
2 S.W. cor.		"	—	8.054	
Recot. S.E. cor. of Cl.				Recorded	
Set Oak post 8"x14"x12"					
F in 28"	S 54-45 E			2.24	
Oak 26"	S 21-35 W			3.67	
Thence	North	∠L 3°-05'	—	2.055	.110 W
13		∠R 27'	—	7.972	
			—	7.980	
			—	7.983	
			—	4.773	.239 E
			—	1.745	
14		"	—	1.745	
15			-3-40	3.059	
16			—	5.667	
17		∠R 04'	—	6.844	.005 E

359

Set stone at corner most from which is Elm N. 7° W.

Sta 10.

16.034	6.820	3.849	9.759
04600	56400	32120	18120
96204	27280	7698	19518
6413	4092	384	975
.102617	341	76	780
	.091713	11	9
		.08169	.21282

13.156	7.499	.185	.185
17510	27420	.207	.082
13156	14994	.032	.103
6578	2998	.424	.370
920	524	4	
13	14	.384	
.20667	.18530	.370	1.00024
185	57115	.014	40000
37		11	4230
.153	.192	257	700
6	.032		
.147	S. 070		
	E. 724		

Sta 11

E. 2.140
S. 100

99969

9.687	16.034	26.693	16.034
96844	6.820	5	6.820
899721	3.849	26.743	3.849
686790	26.693	342	26.693
599814	5	27.135	5
869760	26.743	27.085	26.743
799752	342	.050	342
70008	27.135	26.693	27.135
27.085	27.085	.382	27.085
8.054	.050	27.085	.035
7980	26.693		2.050
16.034	.382		30.453
294	27.085		3.053
13.894			5.667
6844			41.258
61100			
6644			
644			
410			
.007938			

8.927	27.085	7.972	7.972
2445	24.068	7.980	7.980
.912	3.017	7.983	7.983
2450	6.820	4.773	4.773
3350	724	1.745	1.745
10256	7.544	30.453	3.059
615	9.684	58300	5.667
143	1.140	213171	6.844
15	.3057	24362	6644
.11026	57799	1522	644
	27531	239055	410
	27530		30525
	213		
	28		
	30525		

35

18		∠L 2°-23'	42 — 50	3.222	.133 W
19		∠L 05'	—	4.993	.007 W
To NE cor.	N 17°-02' E		—	.288	.069 E
				-.004	
Set cor. at Sta #16				W. 175	.099
Fir 60.	N 5° — W			.150	
Ash 14	S 88°-30 W			.390	
Thence	~~East~~ West.		—	2.614	
20			—	1.715	
21			—	3.253	
	To center of slough.			+.730	
	S 11°-43' W		—	2.692	E. .350 ✓ @ Slough.
	S 1°-09' E		—	2.111	E. .505 ✓ @ Slough
	S 9°-10' E		—	2.121	E. .700 ✓ @ Slough.
	S 11°-44' W		—	2.530	E. 1.145 ✓ @ Slough.
	S 13° — E		—	2.910	E. 1.08 ✓ @ Slough
	S 17°-30' W		—	4.887	E. .940 ✓ N. .960 ✓
	S 62°-47' W		—	5.710	N. 1.560 ✓
	S 75°-13' W		—	4.655	N. 1.140 ✓
	S 71°-50' W		—	2.101	N. 1.30 ✓
	S 46°-26' W		—	1.785	N. 1.48 ✓
	S 33°-15' W		—	2.410	N. 1.54 ✓
	S 59°-26' W		—	5.582	N. 2.160 ✓
	S 78°-58' W		—	4.280	N. 1.660 ✓
	S 78°-44' W		—	1.352	N. 1.540 ✓
	S 2°-08' W		—	2.888	
	S 0°-11' W		—	7.940	
			—	1.918	
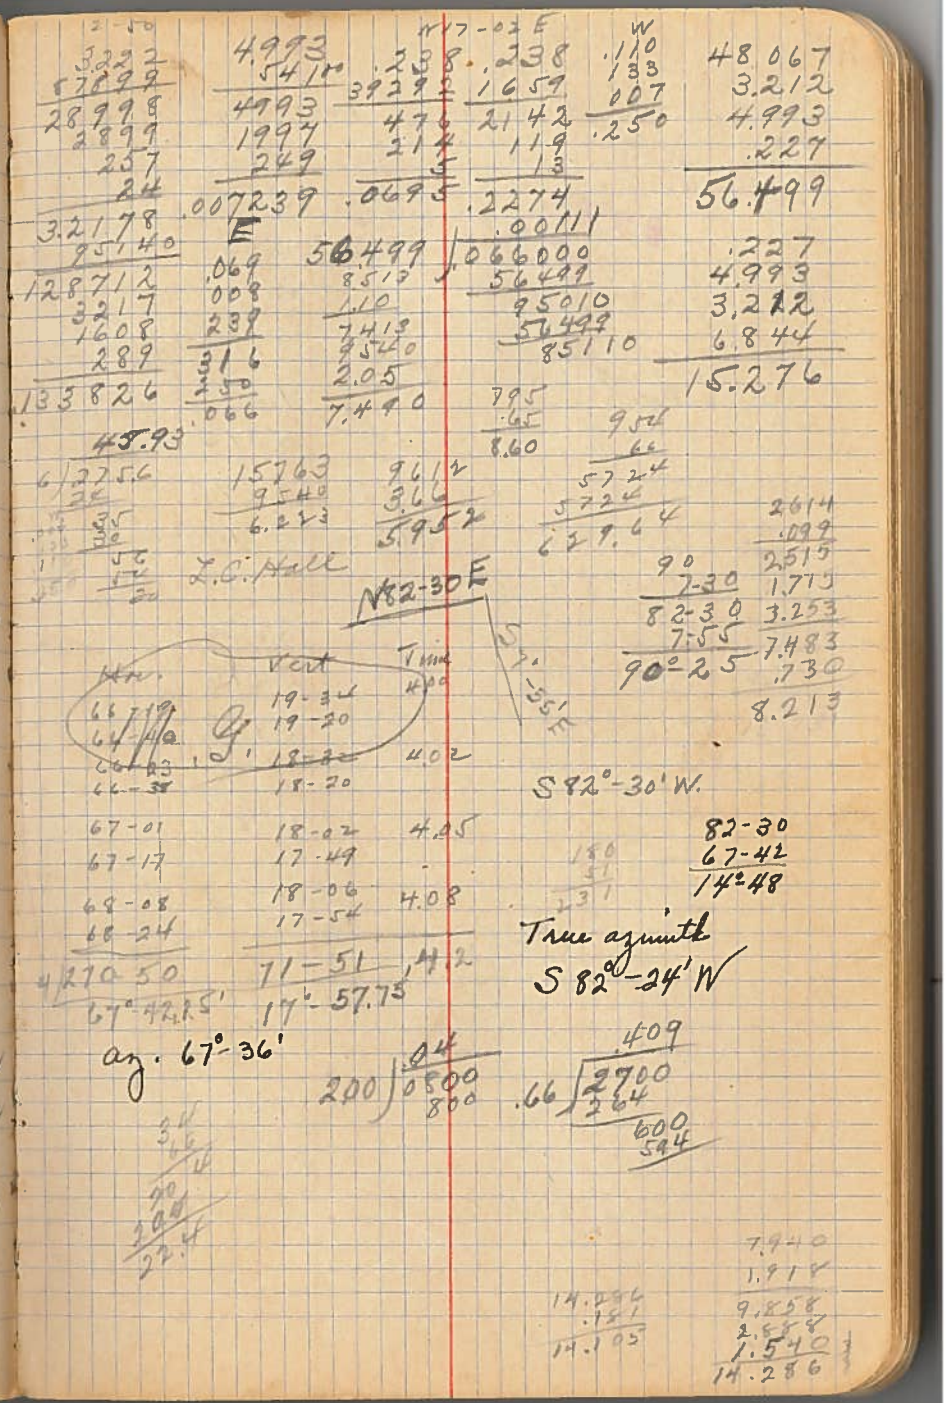
Sline to S 89-46 W straight from SE. cor. to S.W. cor. ∠ of 19 TO most E. N.E. of Stewart Cl. #9