363

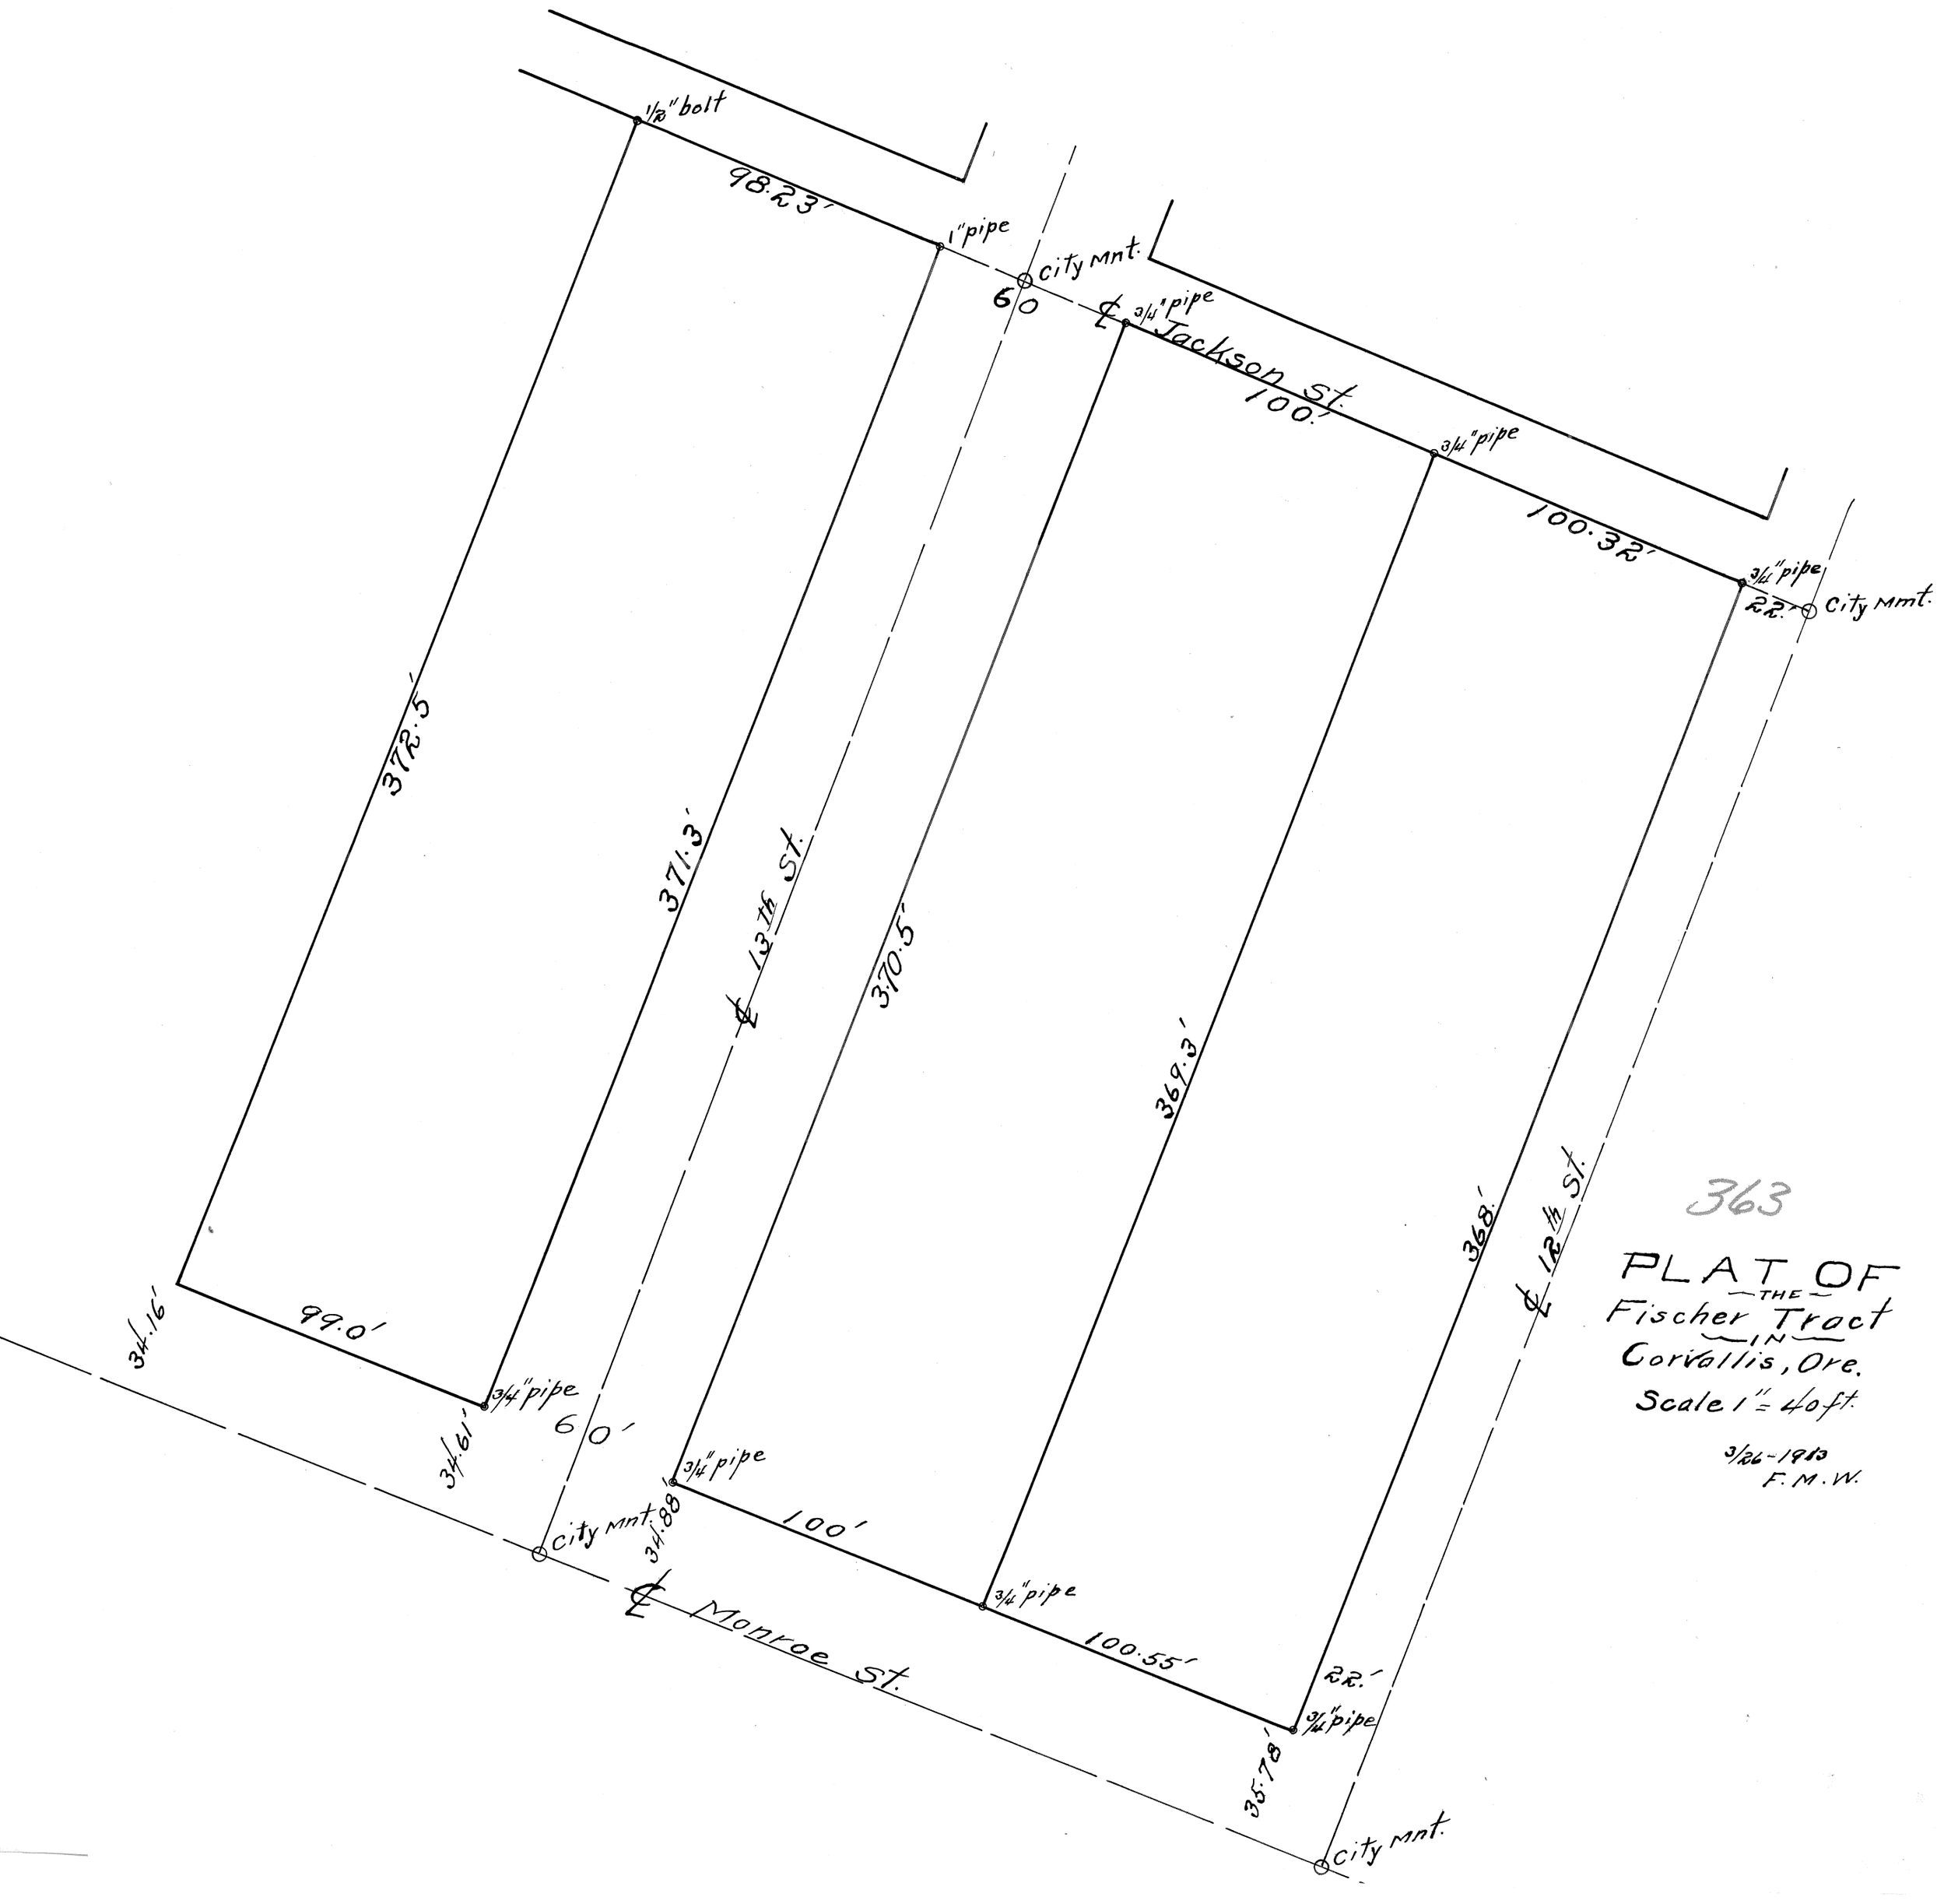

363

PLAT OF THE Fischer Tract IN Corvallis, Ore.

Scale 1" = 40 ft.

3/26-1913
F. M. W.

17

Δ15 S 61°30' W. 8.30

to Δ 16 N 39°45' E. 7.40

Δ16 Δ15 S 49° 52' E 6.88

Elm on East Side 3.43 under N

N 67°30 E 2.84 ± fence

#363

363 Survey for Raber — Fisher

of Mixon ILCS C. Minnie & Wife Rd.

City Monument. B.S. of K.R. N 1°W

Ties to Δ Sig S 3°41' E — 9.165 9.527

ΔB S 3°06' E — 9.527

Δ2 S 1°38' E — 2°30' 4.455

ILC S 8°56' W — 1.957 To ILC

back to Δ0. N 1° W — 1° 6.651 21.561 -.016

Δ4 S 70° 45' E 21.561

Move South.

25 ± Mon. at S 19°30' W — 6.206 +.001 — Mon. S 6.7 E

Δ N 70° 51' W to Manmt — 19.234 5-23A

N 70° 51' W. 5. Mon. ± 4.9'

364

#364 Survey for Morgan. Howells property.

Tie to ILCS line.

Beg at SW. Cor fence Bs on NW. Angle 90.

Lat by Needle on Sun Mar 10 1918.

N 1° W 6.651

S 70° 45' E 13' pr 6.20

71° 45'

250 / 19.234 / .016

16.344 / .045 / 16.299

R156' / 5.R17 / 16.234 / 66 / 48.02 / 64.66 / 1078.60

6.20 / 173.00 / 1860 / 43 4 / 49 / .023 43

Tied. 177.94 / 955.94 / 1075.73 / 1.

30° 50'

1.455

87.599

40095

4009

356

31

3

21.561 / 4494

Time.

Sat 7 hr

Mon 5

12 hr.

Sun 4 pm 16 hr

18 ± 45 = 9.00

3.00

12 00