C.S. # 367

Hardcopy 11-7 # 11

also see notes in file

F. B. 14-56

F/B #14, Pg 56

56 Miscellaneous C.S. #265 For Plunket + Thompson

Beg. at a stone 5"x8"x2" 5.90 c.l.s. S.4536W. of N.W. cor. W½ Wood's C/ #38 Tp. 11 R 7

N. 64° 30' W.
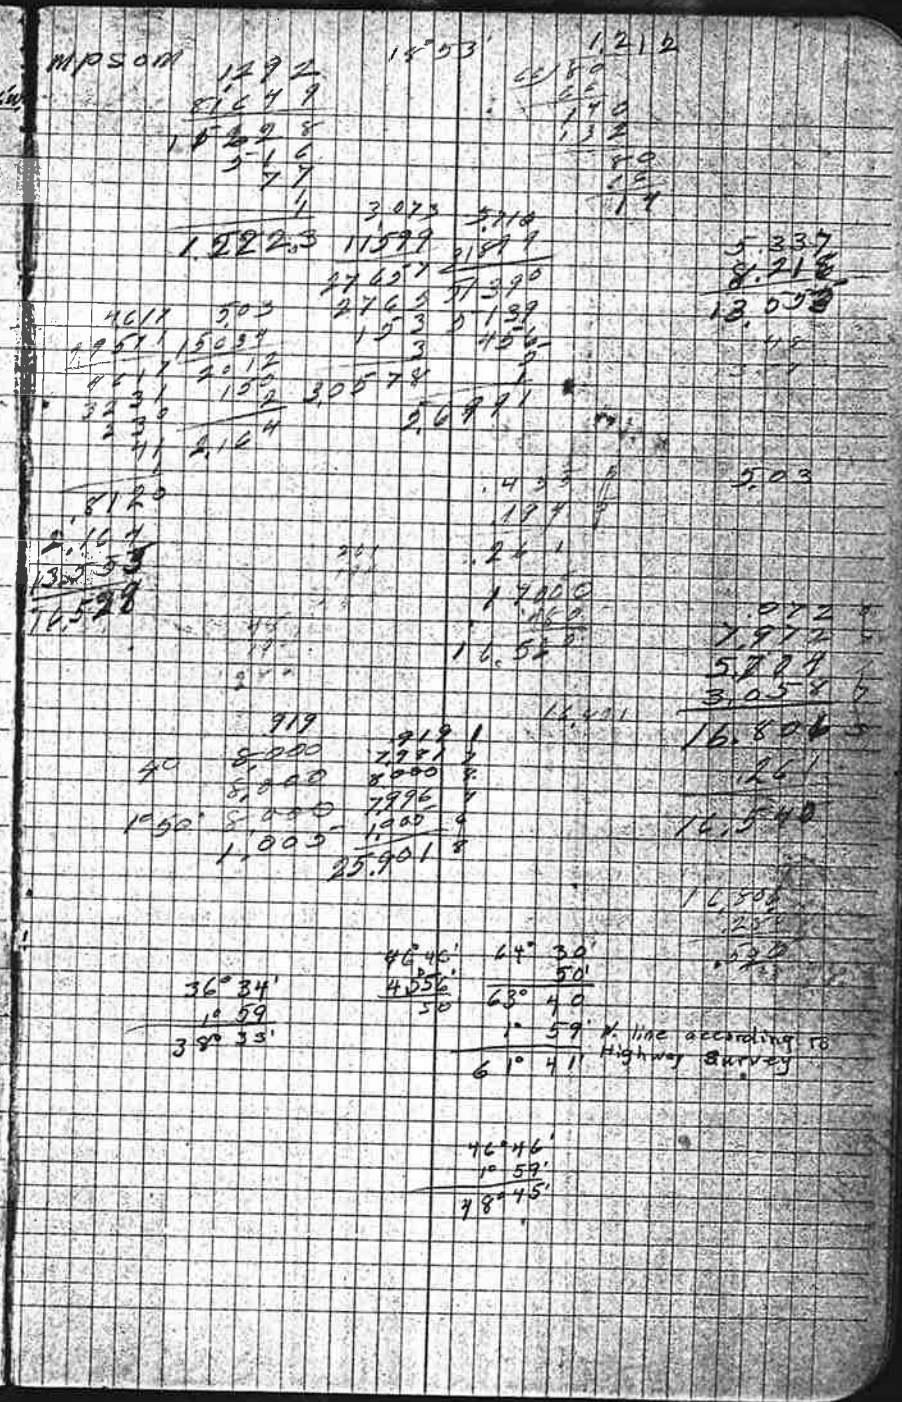
1	2° 45'	5.343	
	1° 10'	8.220	
#1367 Stone #"X6"X32"			
		-.072	
North			
4B	5° 40'	5.055	.072 W.
5	4° 45'	8.000	
5	2° 30'	5.710	
6	5° 40'	3.073	
		-.261	
S. 35° 38' W.		4617	Beg.