C.S. # 370

Hardcopy 11-7 #1

also see notes in file

F. B. 14-58

58 Rel. F/B #14, R 58 370

Survey #172 For F. W Barnard

| | | | | | |
|---|---|---|---|---|---|
| | Beginning at sec. cor. To secs. | | | | |
| 5/4 8/9 | Tp. 17. | orig. cor. | | | |
| | Set ¾" X 20" bolt | | | stamped | W.M. |
| | Fir 36" | S. 30° E. | | 2.52 | chs. std. |
| | " 12" | S. 66° W. | | 1.53 | " " |
| | " 17" | N. 43° 30' W. | | .587 | " |
| | S. 89° 23' E. | | on S. line of Sec. 4 | | |
| | correction N. 43' (N. 89° 54' E.) | | | | |
| 1 | | | 11° 47' | 1.425 | |
| | | | 2° 45' | 8000 | |
| 2 | | | | 3.244 | |
| 3 | | | 20° 43' | 1.494 | |
| 4 | L Left 2' | | 23° 57' | 4.978 | offset .003 N. |
| 5 | | | 6° 25' | 861 | |
| | | | | +.529 | |
| | | | | N. 239 | |
| | Set a stone | | | | |
| | Fir 20" | S. 44° 30' W. | .128 chs. | | |
| 6 | | | | .756 | .227 .248 |
| 7 | | | 10° 11' | 4.515 | |
| 8 | | | 6° 25' | 2.473 | |
| 9 | | | 10° | 3.961 | |
| 10 | L Left | 1° 20' | 1° 10' | 5.335 | offset .124 N. |
| 11 | | | 5° 20' | 2.249 | |

Apr. 14, 1913.

Jasper Miller

Era Young

Guy Gabel

E. Perry chainman

N. 89° 54' W.

S. 89° 17' E.

S. 89° 23' E.

59

| | | | | | |
|---|---|---|---|---|---|
| 12 | | | 11°45' | 1,304 | |
| | Rest. | | | +.083 | |
| 1/4 | | | | .371 | |
| 1/4 9 | Set ½" pipe | orig. cor. | | 2 stamps | Apr. 15'13. |
| | Fir stump | 24" S. | 70° E. | .78' | std. |
| | " | 19" N. | 47° W. | .518 cls. | |
| | Back to Δ O | | | | |
| | N. 1° 16' E. | | | | |
| 13 | correction E. 29' | | 6°25' | 5.078 | |
| | (N. 1° 45' E.) | | 10°28' | 3.021 | |
| 14 | | | 6°55' | 5.739 | |
| 15 | L Right | 2°33' | | 1.035 | offset .047 E |
| 16 | | | 5°40' | 3.459 | |
| 17 Not in total. | | | 10°31' | 1.548 | |
| | | | | +.257 = 20,010 | |
| | Set ½" galv. pipe. | | | .120 | without ⊙ correction |
| | Fir 20" N. | 28° E. | .146 | cls. | |
| | " 18 S. | 85°30' E. | .176 | " | |
| 18 | L Right | +4' | | 4.575 | offset .005 E. |
| 19 | L Right | +42" | 7° | 4.972 | offset .060 E. |
| 20 | L Left | 3°15' | 10°25' | 4.644 | offset .259 W. |
| 21 | L " | 1°3' | 4°50' | 4.950 | offset .090 |
| 22 | . | | 18°53' | 1.402 | |
| 23 | | | 14°51' | 1.551 | |

1.304
5.097
11.736
9.12
1.17
12.765

1°37'
1°52'

3.021 1.035 1.548
6.344 9.444 0.238
27.187 4.220 13.932
24.16 4.22 1.238
9.90 .42 .046
.1 .9 .003
29.705 .046 93 15.219

4.575 4.935 4.459 4.548 18.231
.411 2.221 2.589 .462 1.522
4.986 4.935 4.179 4.086 19.753
4.57 4.935 3.715 4.086 20.010
.274 .987 .371 .274 19.753
.206 .2 .23 .41 .257
.0033 .0602 4.267 3 .490

4.934 1.402 1.551 .00834 = 29'
.238 .995 5.166 40.020 .33400
5.172 12.418 13.959 .32016
3.948 5.60 9.30 1.340
1.18 .70 .93 1.004
.02 .12 .1 18.340

.09038 1.4983
1.326 .571 E.
.237 W.
.334 E.

.041 E.
.005 E.
.060 E.
.112 E.
.259 W.
.147 W.
.090 W.
.237 W.

40.333
39.92
.413 .01038
40
1.30
1.40
.100

38.560 6
1.277 7
.083 7
2 39.920 5
19.960

5.077 8
2.971 1
5.717 4
1.054
3.442 7
18.231 1
4.575 3
4.935 3
4.560 5
4.933 1
1.324 4
1.798 8
40.038
.038
2 40.020
20.010

60 Reest.

| | | | | | |
|---|---|---|---|---|---|
| 5/4 | | | | -.038 | =40.020 |
| | Striking W. of cor. | | | .571 | |
| | Set 1"x1" pin | orig. cor. | | | 2 stones s/d stone |
| | Fir 36" S 12°55' W. | 1.023 | chs. | 12°13' | |
| | " 32" S. 88°40' W. | 1.802 | " | | |
| | Through Sec. 4 | cor. | | .052 | offset N. N. of cor. |
| 24 | East | 8°56' | | 5.095 | |
| 25 | correction N. 7' N. 89°53' E. | 3°15' | | 2.313 | |
| | | 2°10' | | 4.418 | |
| 26 | | 10 5' | | 5.196 | |
| 27 | L Right 44' | 2°25' | | 4.536 | offset .058 S. |
| | | | | -.907 | |
| | set 1" pipe | | | N.046 | .092 |
| | Fir 11" N. 57°45' W. | .071 | chs. | | |
| | " 11" N. 56°30' E. | .168 | " | | |
| | L Left 22' | 1°25' | | 8.000 | |
| 28 | | | | 1.070 | offset .058 N. |
| | L Left 1°20' | 5°45' | | 4.345 | |
| 29 | | 16°43' | | .808 | offset .119 N. |
| 30 | | 11°45' | | 4.464 | |
| | | | | +.565 | (6.13 F.) =40.012 |
| | Set 12 gague gun bbl. | | | S.094 | |
| | Fir 6" S. 35°20' E. | .241 | chs. | | |
| | " 30" S. 41°40' W. | .659 | " | | |
| 31 | | 17°28' | | 3.739 | |

5.095 4.531 .9067 .805
.78789 .0821 .04 4.7259
4.5853 4.531 5.4402 .7272
.4076 .906 .3624 .4044
.356 .362 .05802 .054
.40 .3 .7737 .005
3.5799
5.0330 4.464 offset
5.0972 5.0972 .052 N.
.132 .119 N 20.913
.10194 .40176 .032 N. 20.006
.1329 .3124 .907
.1345 .4012 .203 N.
.1185 7.3703 .022 S.
.161 W.
.1061 S. 19.947
.553
.3739 .120 N. 39.447
.98357 .037 N. .565
.33451 .080 N. 2 40.012
.1842 .237 N. 20.006
.112 .061 S. .00195=1'
.29 .156 N.
.3 80.036 80.036
3.5664 7.99140
.72032
3.93160

.013 E
.552
.565

7
5.833
.570
7.403
2.307
1.415
5.193
4.531
20.913
7.997
1.070
4.328
.774
4.370
39.447
3.564
3 3.013

61

| | | | | | |
|---|---|---|---|---|---|
| 32 | | | 10°10' | 1.016 | |
| 33 | | | 4°55' | 1.472 | |
| 34 | | | 1°30' | 1.266 | |
| 35 | | | 13°12' | .840 | |
| 36 | L Left 28' | | 15°52' | 4.078 | offset .032 N. |
| 37 | | | 11°47' | 5.688 | |
| 38 | L Right 30" | | 5°30' | 2.528 | offset .022 S. |
| 39 | L " 34' | | 6°25' | 6.171 | offset .041 S |
| 40 | L Left 35' | | 5°40' | 3.700 | offset .037 N. |
| 41 | L Left 1°12' | | | 2.886 | offset .080 N. |
| 42 | | | 11°36' | 3.882 | |
| 43 | Reset This Sta cor again Reset FB 26 Pg 79 Right | | 14°19' | 3.995 | |
| | | | | +.044 | |
| 4/3 | Striking N. of cor. | | | +.081 | |
| | Set a ½ galv. pipe | | orig. cor. | | Apr. 16 B Davis |
| | Fir 12" S. 20° E. .58' | | std. | | |
| | " 24" N. 27° W. .46' | | " | | |
| | Back to Δ 30 | | | + .552 E. | |
| | N. 1° 15' E. | | 1°20' | 3.156 | |
| 44 | correction E 39' (N. 1° 54 E.) | | 1°55' | 6.675 | |
| 45 | | | 4°35' | 3.673 | |
| 46 | | | 10°50' | 4.909 | |
| | | | 10°22' | 4.904 | |
| | | | | .675 | |
| 47 | | | | | |
| 48 | L Right 31' | | 7°30' | 7.160 | offset .064 E. |

1.016 1.472 .840 4.078
03489 23699 53779 09169
9144 13248 75160 36702
612 13244 5588 2446
40 88 525 40
3 4 4 36
9999 4.8177 39224
1.4464 41.8
5.688 2.517 6.171 313774
39879 37847399 392
51192 20136 55553 156
39814 1761 5555 4
455 75 145 .03192
51 1.021972 2
5.5680 2886 6.1322 3882 3995
3.481 4902 4989 65979 4986
8101 4773 551848 34938 35955
3491 259 11 4905 27 17 2397
36 551 349 345
3.908042 .060644 19 1
.03746 3.8026 3.8707
4.909 4.904 7.160
81289 86389 44199
44154 44136 67440
3927 3927 64444
98 147 71
4 29 28
3 3 2
4.8213 4.8236 1.0485
209
63882
1.41
.064023

43.013
1.000
1.466
1.265
.818
3.922
5.568
2.517
6.132
3.481
2.886
3.803
3.871
.094
80.036

3.155
6.671
3.661
4.821
4.824
.645
23.777
7.058
30.835

62

| | | | | | |
|---|---|---|---|---|---|
| 49 | L 9 | | | offset West | .070 |
| 50 | N. 1° | | 3°50' | 1.110 | |
| 51 | | | 8°15' | 2.879 | |
| 52 | | | | .198 | |
| 53 | L Right | 11°20' | 21°13' | 3.218 | offset .590 E. offset .142 W. |
| cor. | L Left | 28°2' | 39°14' | .392 | |
| sct. | Reest. | | | | |
| | Set ½" pipe | | | | |
| | Fir 36" N. 18° E. .95 stol. | | | | |
| | ~~Maple 15" 4.75° E. .240 cts.~~ | | | | |
| | Burnt Fir 48" S. 40° E. .55 stol. (57) | | | | |
| | Back to Δ .552 E. of Δ 30 | | | | |
| | S. 1° 52' W. correction W. 2' (S. 1° 54' W.) | | | | |
| 54 | | | 10° | 2.596 | |
| 55 | | | 11° | 7.687 | |
| | | | 3°5' | 8000 - 1 | |
| | | | 23°20' | 6.501 | |
| 56 | | | 14°2' | 1.170 | |
| 57 | | | | 1.010 | |
| | | | 11°20' | 3.233 | |
| | | | 11°55' | 7.994 - .006 | |
| | | | 9°48' | 2.978 | |
| | Striking E. of cor. | | | .007 | |
| | Back to Δ 17+.257 | | | | |
| 58 | N. 89° 53½ E. | | | 4.424 | |
| 59 | | | 40°5' | 4.933 | |

2.879 3.218 .19653 .98050 3

30.785 5
1.108 5
2.849 5
.198 5
2.942 5
.267 5
38.149 5
2.556 1
7.546 1
7.988 5
7.969 2
5.135 1
3.170 2
7.822 4
2.934 9
77.268 4
1.010
78.279
38.243
40.036

324
921
5.245

63
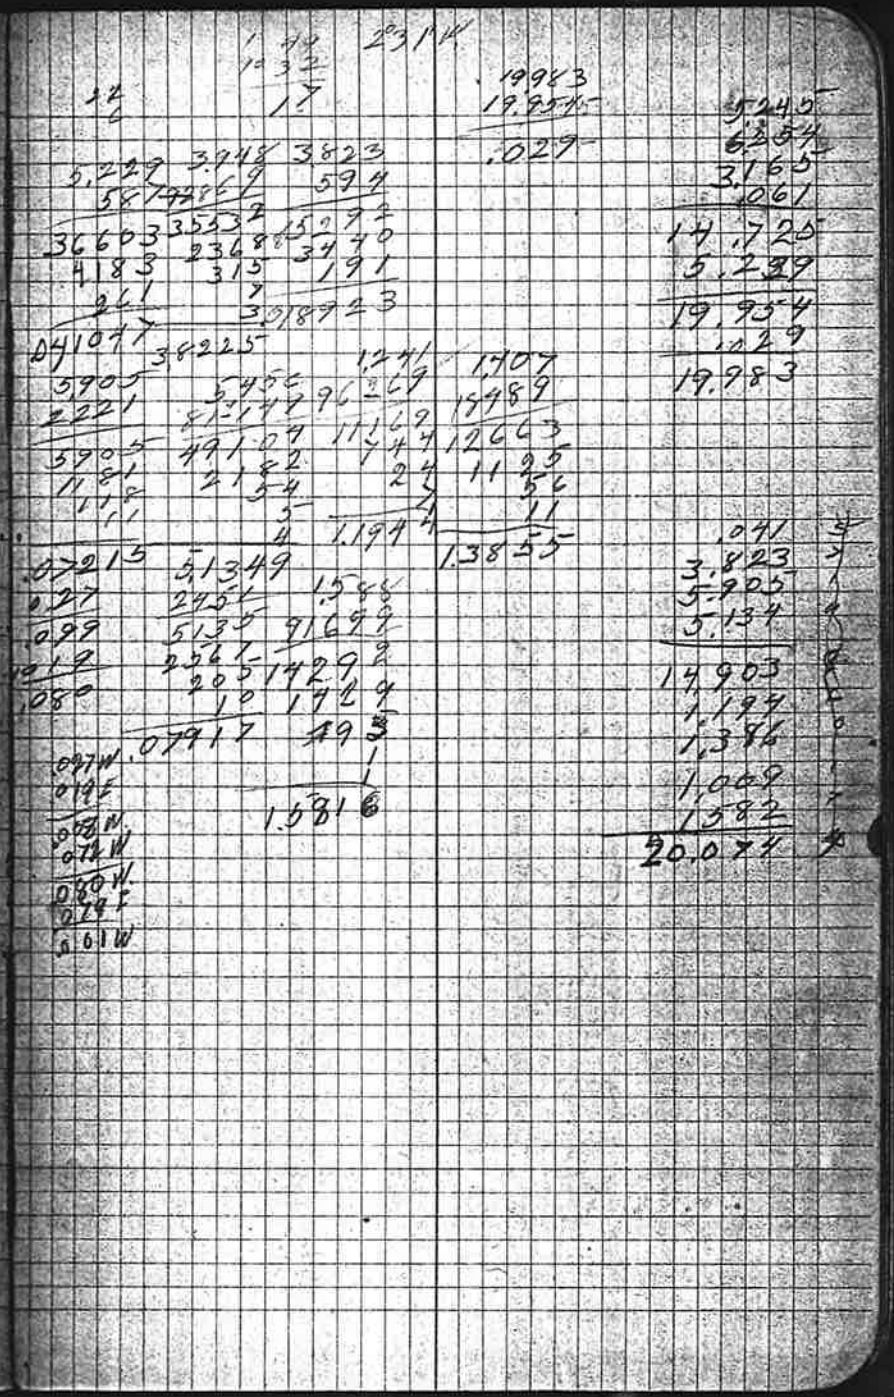
| | | | | | |
|---|---|---|---|---|---|
| 60 | | | 45 | 6,250 | |
| 61 | | | 2°40' | 3.168 | +.061 |
| 62 | L Right 28' | | 3°25' | 5239 | o/set .041 |
| | | | | +.029 | |
| | | | | N.041 | |
| | Set ½" galv. pipe | | | | |
| | Fir 20" S. 2° W. .05C chs. | | | | |
| | | | | .027 N. of line | |
| | S. 1° 49' W. | | | | |
| 63 | L Left 17' | | 14°28' | 3.948 | offset .019 E. |
| 64 | L Right 42' | | 4°20' | 5.923 | o/set .072 W. |
| 65 | L Left 53' | | 19°45' | 5.45C | o/set .079 E. |
| 66 | | | 15°43' | 1.241 | |
| 67 | | | 10° | 1.407 | |
| 68 | | | | 1.009 | |
| 69 | | | 5° | 1.588 | |
| | Strking .002 E. of cor. | | | | |