C.S. # 378

F.B. 11-18

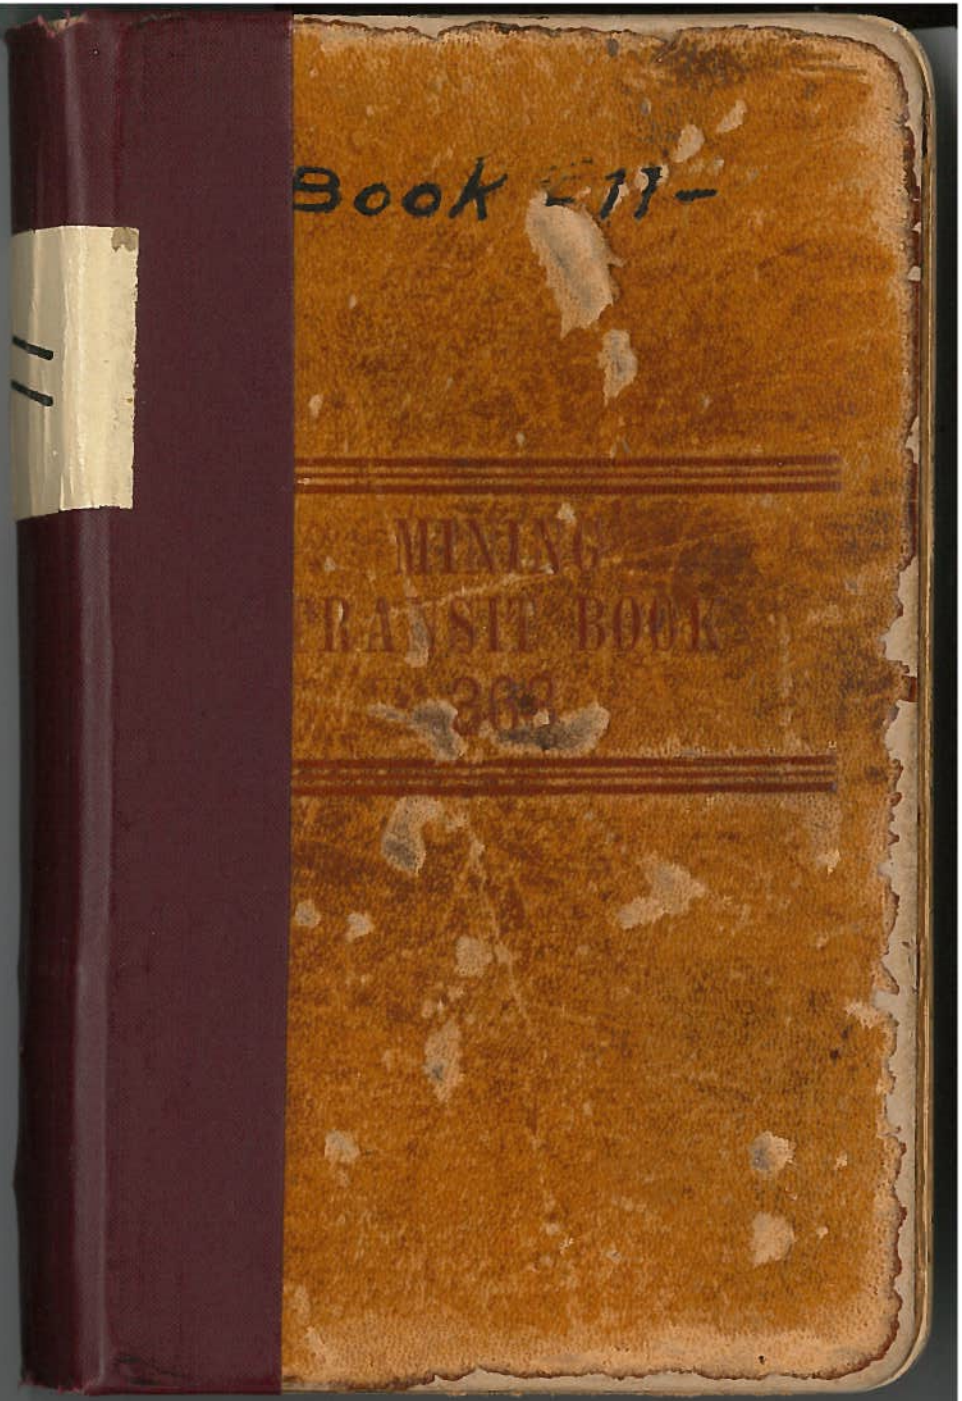
Book -11-
MINING
TRANSIT BOOK
365

18

Angle R 27° 36′ 525.3′

T. P. 560-1000 Angle R 59° 41′ 53.3′ to pipe
W. Line B.L.C. = 1142′ ft N of B

Miscellaneous #378 For N W
Stover N W. 3.5 m. S.W.
From SW N 36° E 36.001 = 32.55
Δ N 54.5° E - 21.461
Set 53 South - 2.499
" S 45° 03′ E - 5.346
to NE N 36° 30′ E - 2.406 N.E. Cor.
+.162

Back to 15.50 S 36° W.
Line 6 54° E. 11.493
Set a 1" pipe 1.306
N 36° E. 2.324
N 6
Cor from 45 Ent. 17.014
Angle Pl. +.830
Bearer Tree 4.451
+.082 to B.L.Cor

April 11-1913

Direction Sun
2.5 m N of B Line.

	Hor ∠	Vert ∠		Time
1	72° 6′	24° 49′	IR	4h 13m
2	72° 21′ 15	24° 35′		4h 15′
1	71° 57′	23° 53′		4h 14m
2	72° 09′ 12	23° 41′ 12		
Mean	72° 08.2′	24° 13.5′		
		Cor. 2.2		
		24° 15.7′		

Running from Linn Co. April 10-13
+ 55 to Sun mark

5.031
5.346
7900
42768
3742
34510

31.74 | 1.25 | 75.00 | 2.00 | 1.904 | 95.40 | 95.22 | Tan

Tan 30° 55′ 16.67 15.0 1.7 | 1.000 | 30° 35′ 48.35

24.949 | .0 | 24749 | 190310 | 189780 | 15.270

21.461 5.346 .162 26.969

15.50 13.998 11.493 1.306

11.493 17.014 .830 29.337

4.451 .082 4.533

21.461 5710 21462 15622 1.173 33556

19

North from NE. Cor Bank 17.194

Road Traverse

From SE. Cor North 1.120

N 52° 47' W. 4.231

Crotch 15 links E. N 820 52' W 2° 2.665

N 5° 18' W 7.406

West N 46.50 chs. to Crotch.

Length of N Line. 21.461

+.065

Length of E Line to Cor 10.740

Length of E Line to Cor 13.280

10
3.194
17.194

7 to N Line
Corrected

7
3.740

22
22
44
132
132
145

47
52

17.194

47° 34'
145

14.070
13.570
+.500

13.896
13.398
.498 W

more SE to a

on Road .50

Mouth of Road South .50

at in Road South .405

Time Etc 7 50