C.S. # 393

See notes in file

F.B. 15-52

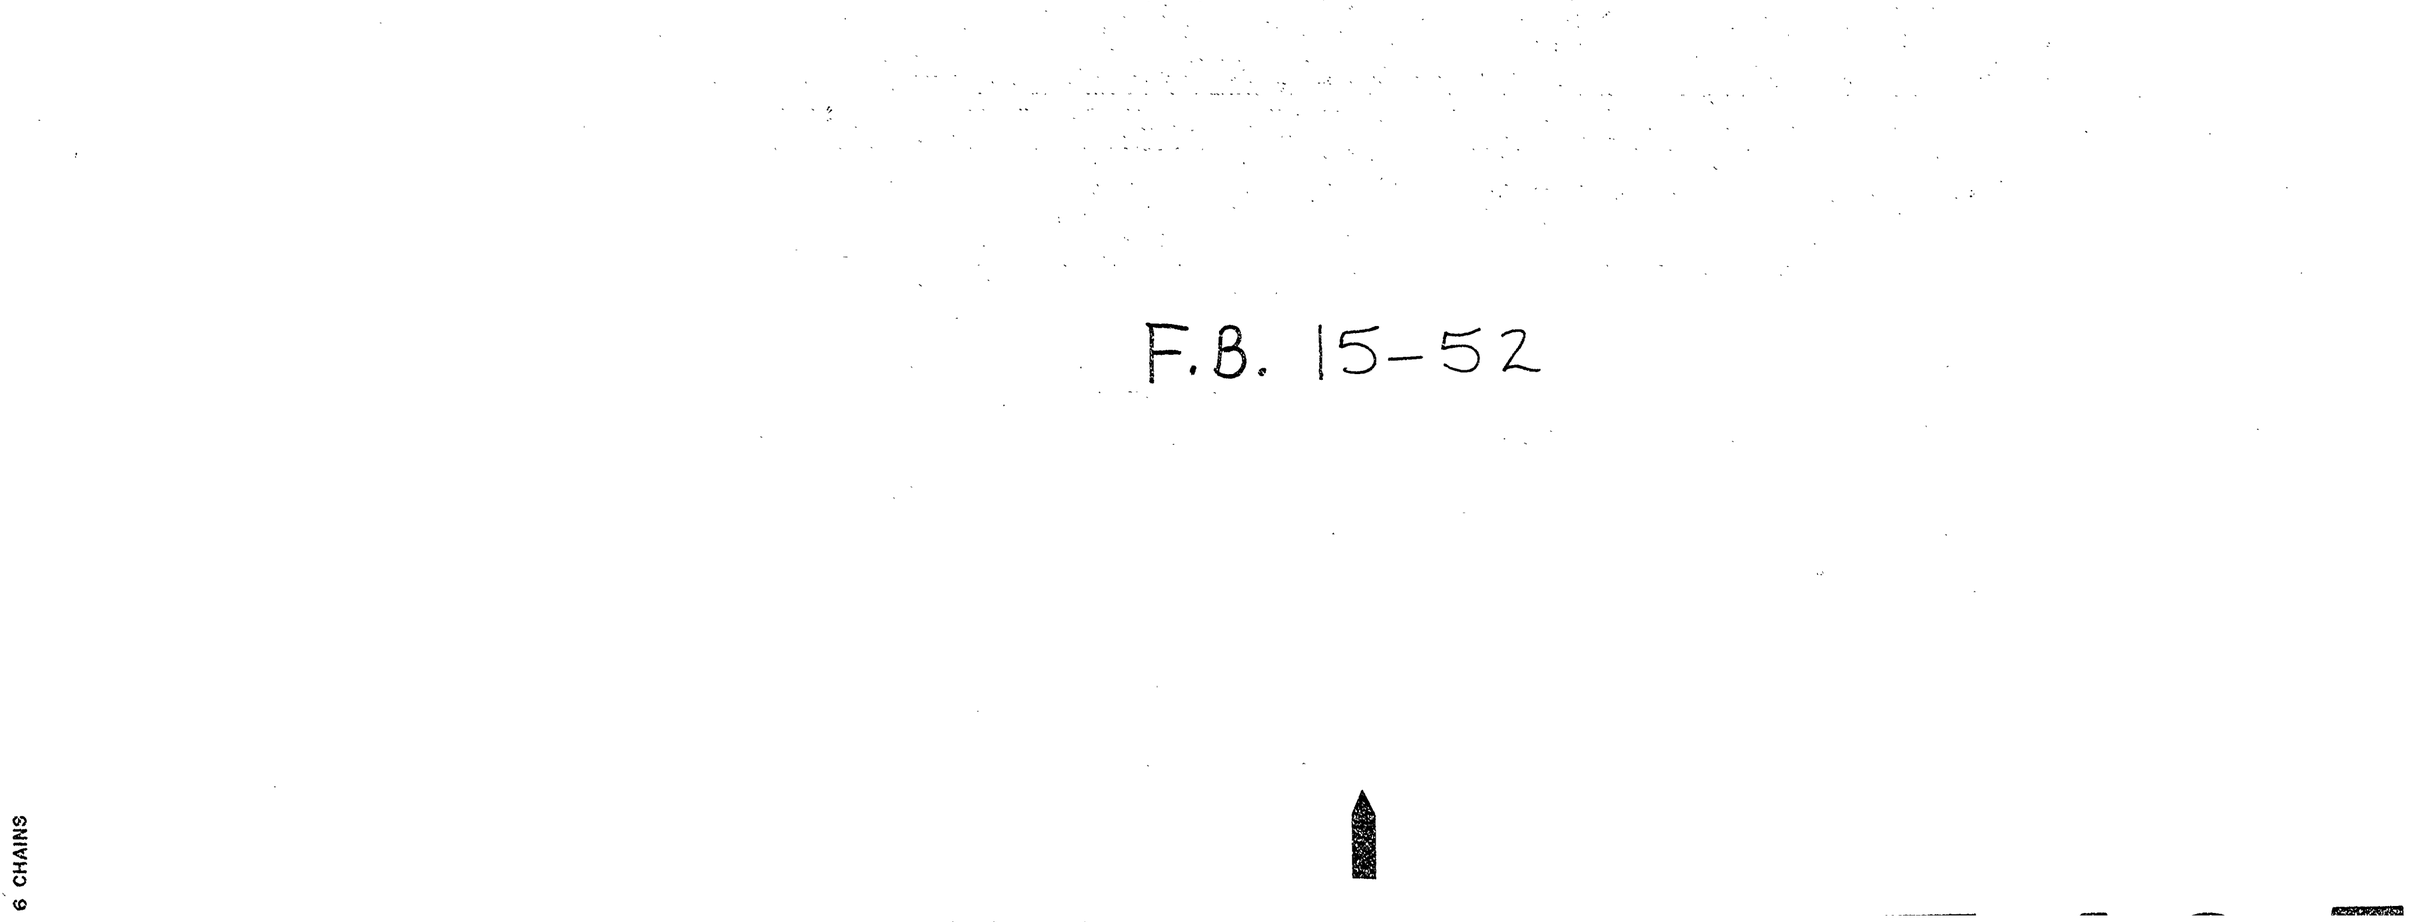

FB#15 CS 393

52 #393

Survey #179 For H.B. Rivers

N.W. Bg. at N.W. cor. Jesse Wood #15

Tp. 12 S. R. 6 W.

R.F. Thomas Sep. 18, 1913.

F. Crowell

Set Stone 8"x8"x15" Oak stump.

	Fir 20" S. 45° E.	.220	cks.	
	Oak 18" S. 80° W.	.88	" Std.	
	S. 44' E.			
1	Con. with W. 44'	.650		
2	L Left 4°22'	5.112	offset	.211 E.
3	L " 2°22'	3.388	offset	.140 E.
4	L Right 26'	4°30'	4.774	offset .036 W.
5		9°40'	1.498	
6	L Right 9°26'	15°55'	2.307	offset .383 W.
7	L Left 3°28'	15°45'	3.538	offset .206 E.
8		6°45'	3.673	
			+.410	
			4.083	
			W. .457	
	Set Stone			
	Fir 10" S. 77°30' W.	.405		
	Oak 5" N. 29° W.	.623		
9	L Right 12'	2°	4.444	offset .015 W.
10		1°30'	4.649	
11			3.424	
12		6°30'	3.584	
13		11°10'	4.953	
14		12°40'	7.371	
15	From △15 it is S. 89°01' E. 10.981 to Sec. cor.	4°15'	1.345	Base Line
			N. 28.19	N 18° 57 W.

| | | | |

53

16	L Right	1°59'		3.142	offset .109 W.
17	L "	2°51'	11°41'	4.058	offset .144 W.
18	L Left	40'	17°54'	6.425	offset .154 E.
19			8°30'	7.266	
20			20°35'	2.713	
20½	N. at ℄ to line			1.010	
				1.723	line
				.503	
Rest. S.W.				S. .384	
	Set 2" pipe Set from N.W. Cor. of Sec. cor.				
Maple	20" S 13°30' W.		.956	Obs.	(Sept. 22)
Double Maple	36 S. 66°30' W.		2.772	"	
	Back to △ 15				
21	N. 8°16' E.		20°34'	2.109	
22	S. 89° 30' E. from stake at base of 11.39 cu. yds. Sec. Sec. 11.39 cu. yds.		8°6'	1.756	
23	L Left 99'			.988	offset .016 N.
24	L Left 54'		7°36'	9.104	offset .089 N.
25			2°35'	2.671	
Rest.	S. 88° E.		21°38'	.246	
	Striking N. of cor.			.231	
				.603	
5/8	Set 1" pipe Maple Stake both Woods				
	Orig. Cor. S. 20°10' W.			.125	
	" 12" S. 84° W.			.499	
	From △ 23				
26	North		12°30'	3.315	(3993 N. 12° W. 3.993 Set 11.45 Pipe 3.993 Set 11.45 Pipe)
27	Set 1" I pin			.100	corner Stone.
	Back to △ 8			S. .412	
				Cor. 11.45	3.543
28	West		10°25'	6.078	
29				1.270	

| | | | | |

30			9°45'	1.433	
31			17°30'	3.429	1.996
32				-.344	5.204
Set Stone W. edge of creek.					
Mile 14	N. 88°35' W.	264 chs.			
4-16	N. 44° W.	546 "			
	12° 55'				(2.913 = 1975
33	S. 11° 52' W.		9°20'	3.245	-.209 S)
	18° 45'				
34	S. 20° 42' W.		0°	4.209	4.186 = 276.28
	20° 39'				
35	S. 10° 12' E.		10°10'	3.390	
36				.145 =	3.482 = 229.81
	7° 55'				
37	S. 7° 55' E.		0°40'	6.10 =	6.764 = 446.42
	20° 10'				
38	S. 20° 10' E.		0°	2.034 =	2.022 = 133.45
	3° 22'				
39	S. 3° 22' E.		7°15'	2.954 =	2.932 = 193.51
	16° 24'				
40	S. 16° 24' E.		7°25'	2.814 =	2.790 = 184.14
	9° 40'				
41	S. 9° 40' E.		0°	3.348 =	3.330 = 219.78
	12° 52'				
42	S. 12° 52' E.		5°50'	2.157	2.176 = 141.64
	2° 19'				
43	S. 2° 19' E.		6°8'	7.105	7.065 = 466.29
	2° 41'				
	S. 2° 41' E.		5°35'	4.336	4.313
44			7°15'		3.916
45			14°3	1.295	1.217
	9° 31'				
46	S. 9° 31' E.			4.272	4.272 = 281.95
	7° 07'				S. 7° E.
47	N. 74° 07' E.		3°30'	1.907	1.903 = 125.6
	N. 75° 40' E.				

Back to D 13

1437	3207		
45569	27357		
14697	28443		
1509	1603		
41	96		
45	22		
16092	30584		
3245	3390	28414	
47689	03459	36199	
29205	30510	25326	
2596	2712	2532	
194	135	28	
22	10	16	
1			
3.2012	3.3367	2.7902	
.209	.115	1255	
2.993	3.482	80079	
		18295	
		8791	
		1.2174	

12.017
11.096
.921

6.889 4
1.609 7
3.058 7
11.556 6
.347
11.212
.047
11.259=

743.09

55

47	Back to D13	+8°	2.939	(2.939)	
	S. 88° 57' E.			1.670 E. of	
48		9°13'	2.774	D.L.C. 11	
49		6°10'	7.146		
50		1°30	3.500	S. 3°10' E.	
S.W. cor.	Wm Hewlett 74		.727	2.25	
Rest.			.265		
	Set Stake				
	Oak 24" N. 1° E.		7.26		
	" 12" S. 79°30 E.		4.50		

2.939
2.825
.114

					45.875
					.911
					42.914
					.265
					43.179
				Brs.	.232
					43.411
					2.738
					7.105
					9.843
					3.559
					13.402
					.729
					12.673
					.670
					13.343