C.S. # 408

Hardcopy 14-7 # 1

also see notes in file

F. B. 86-5

F/B #86, Pg. 5-6

5

Cont. C.S. 128 - Sec 3, 14-7

L.A. 408

Rex Clemmons

Mon Feb. 17, 1941

Find Pipe E. side Road @ sec. line

Set B.S. Go to to cor. Turn on B.S.

- 10°10'
474.25 466.80 N. 2°36' E

Temp spike for N.W. corner of Clemmons Tract.

Move N. 15'

Back up S. 44' = N. 10.9 Set 3/4" X 24" Galv Pipe = Calcm.

	(477.70' / 7238')	R. 92°36'
+2°20'		
305.72	305.47' (4628')	East
℄ Road		L 141°43'
467.85	=(2543')	N. 51°43' W.
℄ Road		L. 7°30'
-2°		
213.7'	(323.8')	N. 59°13' W.
End Co Rd @ sec line		L 123°23'
213.53	(323.5')	S. 2°36' E.
Beg.		

Set 3/4" X 24" Iron Pin

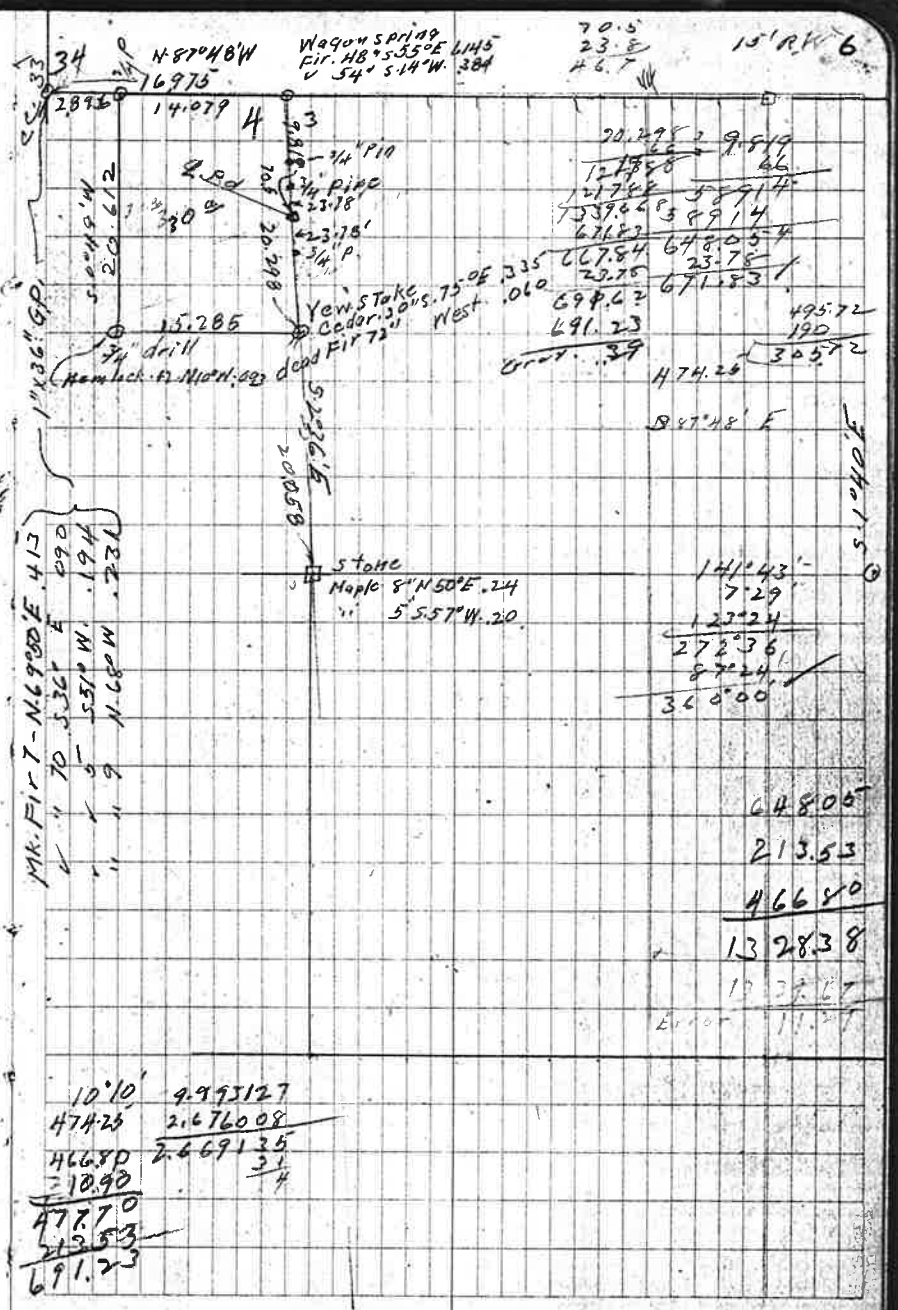

10°10'
474.25
466.80
= 10.90

9.993127
2.676008
2.669135
31/4

477.70
213.53
691.23