C.S. # 415

Hardcopy 12-6 # 32

also see notes in file

F. B. 16-3

6 CHAINS

F/B #16

3	S. #415	12 – 6		
	Survey #184	Fd. R.A. Pulley		
	Beg. at a ½" pipe	10.202 E. of sec.		
	cor. to secs 28 27 33 34	T 12 S R 6 E		
	S. 0° 04' W.			
	correction E. 16'			
1		1°40'	5.155	
2		2°33'	5.619	
		1°20'	7.984	
		3°35'	8.000	
			.365	
3				
4		11°50'	5.479	
5			.428	
6		8°35'	7.457	
			+.020	
		90	E. 183	
	Set ¾" pipe			
7	N. 89° 56' W.	4° 20'	2.672	
8	correction N. 41'	50'	7.442	
			.059 = 10.299	
Test				
	Striking S. of cor		.099	
33 84	Set ¾" galv. also 2 brick		2 Trees down	
	Ont 8" N.	51°10'	E. 1307 to 48.	
	Fir 7" S.	5°30'	W. 1.937 " 48° 40'	
	Back to ⌀ 6			
9	S 89° 56' E.	1°	5.904	
	correction S. 41'	9°38'	1.991	
10	Oak 7" N. 14° W.	.214	S. .113	
	Set ¾" galv. pipe		+.204	

Dec. 29, 1913.
A. F. Ervin
R A Pulley
C. R. Stanton

40.26 .00454 = 16'
.18 300
16 112
2 18 80
2 0 140
1 7 40 0

5.479 74457
5 82 2 08 8 8 2
4 9 3 1 1 6 2 1 1 3
3 3 8 3 5 5 9 6 5
4 3 8 5 9 4
3 8 5 9
2 7.737 33
5.362 4 7.737 ++

1.991
.988
1.979
1.592
99
17
1.962

2.664
7.731
10.105
.059
10.229
10.046
.183

17.912
.207
16.116
10.229
7.887

5.153
5.613
7.982
7.984
.365
5.362
.428
7.373
40.260
.020
40.280

5.903
1.963
7.866
.207
8.073
.186
7.887

4

11	N 0° 04' E.	13°30'	1.186		
12	Make correction W. 21'	0°30'	1.461		
			−.906	∠ R. 19°	
	Rec 5+		.598		
	Striking W. of cor.		.194		Two stamp hdes
	Set ¾" galv. pipe 1 brick			orig. stake hde	
	Oak 8" N. 88° 50' E. 1.758			chs. slope	
	" 7" S. 3°30' W. 1.584			"	vert. ∠ 12°40' (101.1)
	S. 89°56' E.				
	correction N. 43'				
13		3°	5.287		
14		4°10'	6.161		
		3°15'	7.988		
15		0°45'	3.457		
			.160		
		Set	5.621		
	Set ¾ pipe				
	Fir 4" S. 89° 10' W.		3.671	chs.	
		8°40'	2.091		
16			.558		
17			.907		
18		14°4'	3.866		
19		7°20'	5.197		
20	∠ R. 9 + 12°33'	3°45'	4.970		offset S. 1.077
			+.000	E 39.912	
	Rec 4+				
	Striking S. of cor		675		
	Set 3" galv. pipe				
	Fir 60. S. 60° E. 37				
	Oak 20 S. 20 W. 1.85				

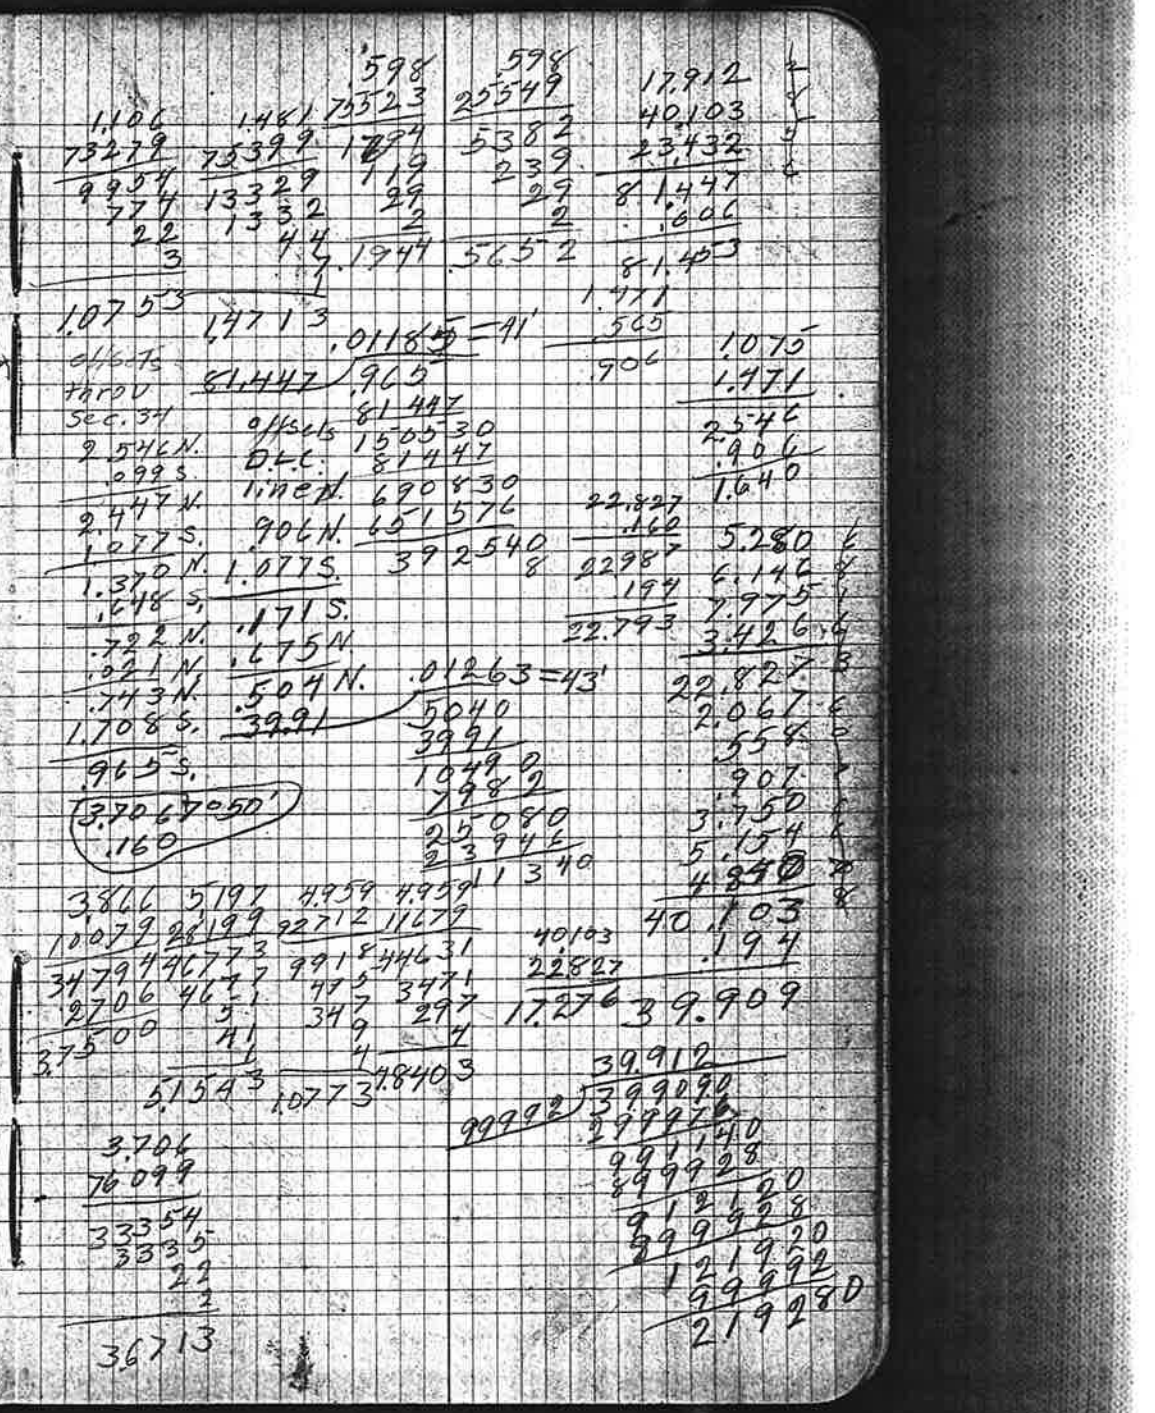

5	S. 89° 56' E.				
21	∠ Right 18° 42	3° 15'	2.026	offset .648 S.	
22	∠ Left 13'	8° 45'	5.734	offset .021 N.	
23		1° 20'	1.426		
24		6° 10'	1.399		
25		11° 8'	6.048		
26		7° 07'	7.053		
to cor	S 2° 46' E.		1.710		
			+.083		
34/35	Reest		1.708	Fir Stump N. 60° E. 2.01 by 1.7	
	Set ¾" galv. pipe	stake hole little stone			
	Cherry 4" S. 6° W.	.120 lks.			
	Fir 15" N. 11° W.	.281 "			
	Back to ⊙ 15. S. 0° 04' W. correction E. 21'				
27		2° 45'	5.443		
		13° 30	1.000		
		14°	7.000		
28		10° 48'	3.333		
		3° 50'	8.000		
29		1° 50'	3.924		
30	∠ Right 8'	1° 40'	5.803	offset .014 W.	
31		2° 45'	4.459		
32	Reest	6° 35'	3.967		
cor.	∠ Left 13° 47'		.637	= +.462 W. .441	
34/3	Set ½ galv. pipe orig. cor.		Striking wood in hole both trees down		
	Fir 20" S. 23° 30' E.	.260	chs.		
	" 22" S. 81° 30' W.	.250	"		Jan 3/13

2.020 2.020 5.754 5.687 673
12.749 1.423 6.385 17.061 3.986 454
18.188 6.064 5.178 4.603 4.454
8.888 4.244 4.603 4.454
1.411 .647 4.454 3.021495
.647 3.021495
1.913 5.68469

6.048 7.053 1.710 97237
6.189 55.299 1.284 97030
54.432 63.477 6.840 1
48.36 6.347 1.368
6.0 1.41 .37
.6 35.3 .11 6.79210
.4 70003.082353

5.9340 3.333 .637 .637
98.336 63.389 6.91 27.391 96
3.333 29.999 2.666 44.79 38.22
99.004 .999 12.7 5.73
99.004 9 6 6
99.004 1 5 5
99.004 3.2772 4.617 4.406

5.800
.332
1.1600
1.740
1.334
91.351 80.429 .00618 = 21'
9 Sticks 497000
From St. N. 482574
.441 W. 144260
.014 E. 80429
.427 W. 63831.0
.028 E.
.399 W.
3.758 W.
.142 W.
4.299 W.
3.802 E.
.497 W.

440.917
10.229
10.046
.183

12.13 5
5.687 8
1.425 3
1.390 4
10.415 2
5.931 3
7.000 7
1.083 2
23.432 5

5.437 1
.872 6
6.792 6
3.277 1
7.982 8
3.922 7
5.800 4
4.654 6
3.941 1
.462 3
43.239 3

43.239
.621
42.618

	Back to P 15				
	N. 0° 04' E.				
	correction W. 21				
33			8° 55'	2.301	
34				5.875	
35	L Right 28'		5°	3.493	offset .028 E.
36				1.163	
				+.029	
			9°	E. .053	
	Set 3/4" pipe				
37	N. 89° 39' W.		5° 10'	3.773	offset W. 3.758
	correction S. 4'				+.019
	Striking S. of Cor.			.025	
	N 76' W. along Cl. line				
					offset .172 W.
	Striking W. of 1/4 cor.			3.802	

2.301 = 25
3.480 3.758
.418 .094

27840 15032
348 3382
139 187

.028327 .018601

.00106 = 4'
3758) 4.0040
3758
242 80
8

12.190
.029
.621
13.440

2.272 4
5.875 3
3.480 2
1.163 1
12.790

3.758
.053
3.811

Stone

24358