444

Miscellaneous Corvallis Meat Co

Alexander & Butterfield C/S. 12-5

Survey N. ½ lot 1. Davis Subdivision

Also. Part of Lilley property.

Begin at ℄ State Road & Claim Line

N. 89°10' E. on Cl. Line .609 set ¾" Pipe Road side

8.10 8.00 Dist in first deed

① 2.745 10.845 Mean " second " set ¾" pipe

At. 14.62 14.915 Find pipe = "1 Tract #1. Davis

S. 0°05 E. 6.65 Find Point of rotted stake.

At. 3.34 set ¾" Galv pipe.

Back To ①. N. 6°50' W. = 90°00' Angle-Cl. Line

15 rds. 3.75 set ¾" Galv pipe.

Back To ℄ road & Cl. Line.

N 4°35 E. 3.767 set ¾" Galv pipe .608 N 89°10' E.

From ℄ Road & Cl. Line

S 4°35' W. 3.35 set ¾" Galv pipe .608 N. 89°10' E.

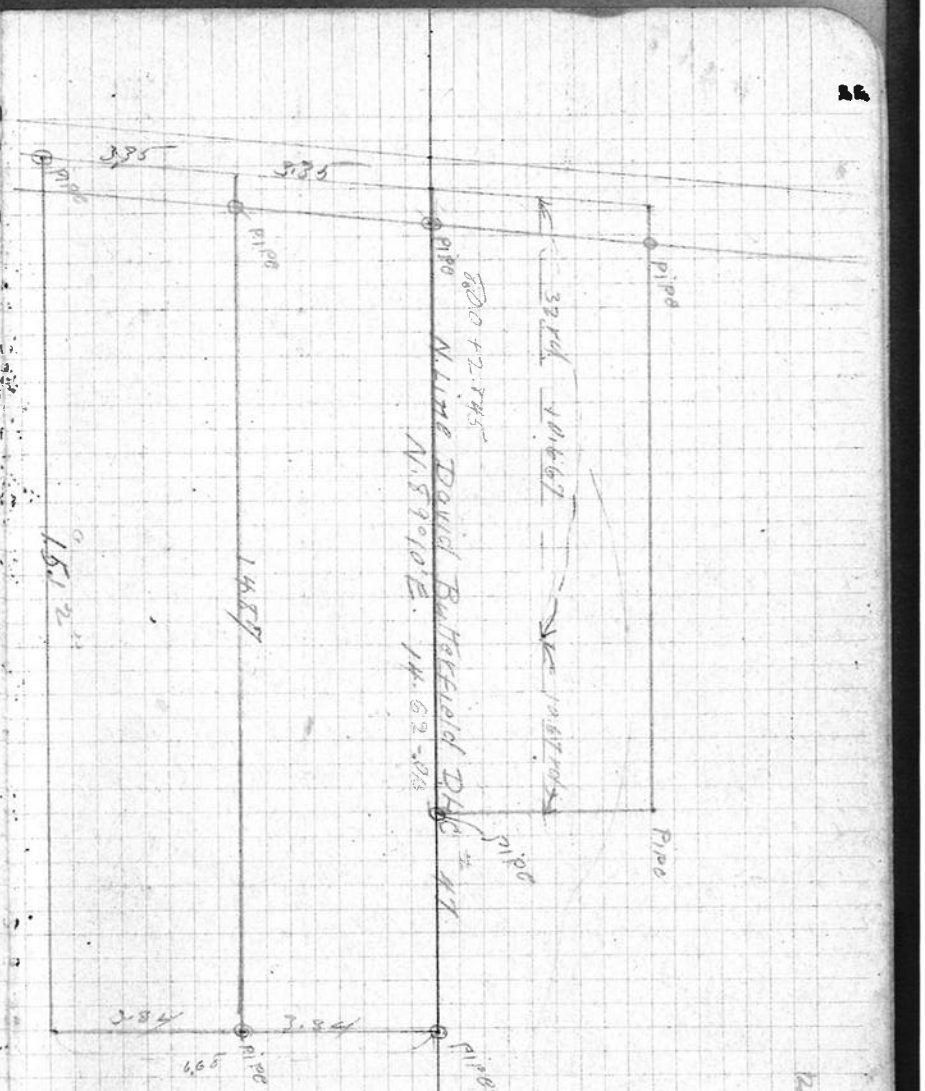
3.35
3.35
Pipe
Pipe
Pipe