C.S. # 453

Hardcopy City Plat #13

F.B. 17-37

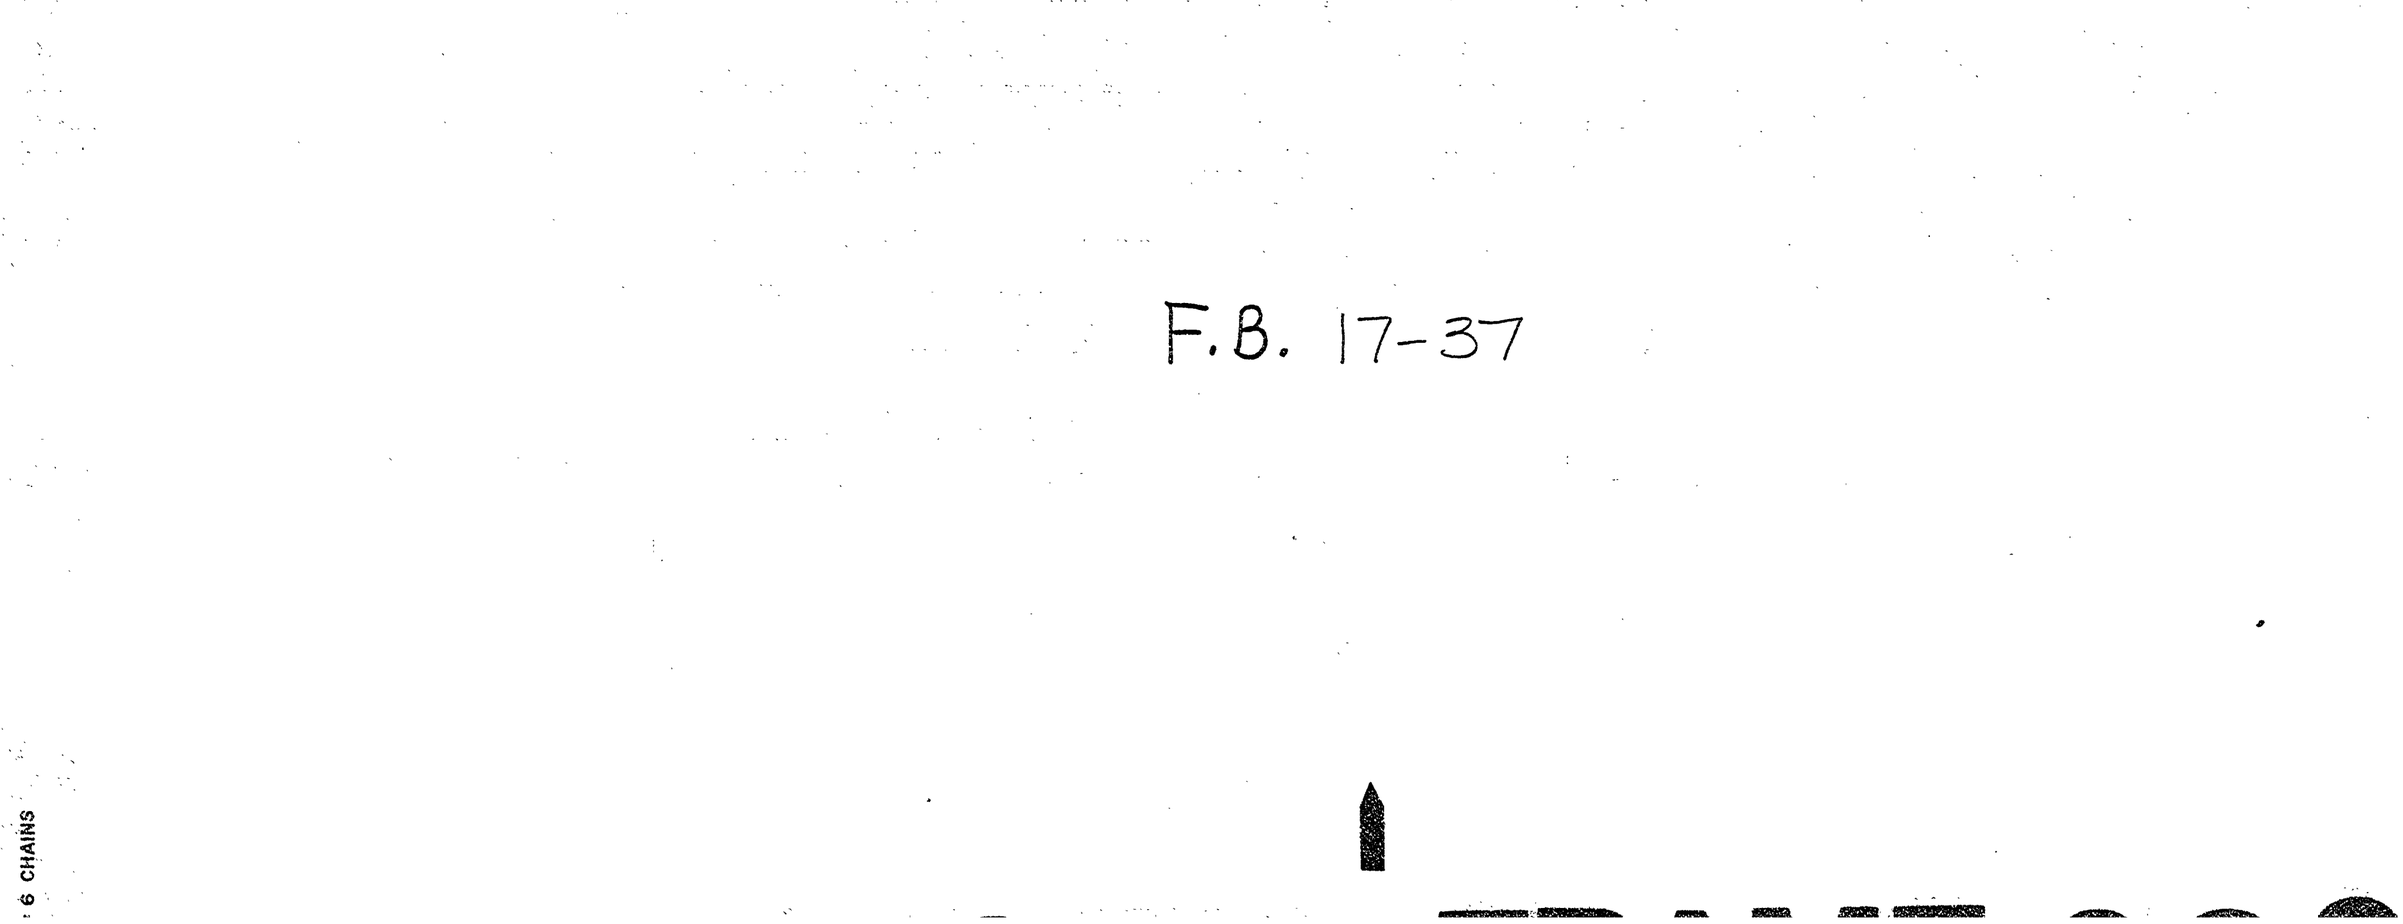

Miscelaneous #458 June 9 & 10-4
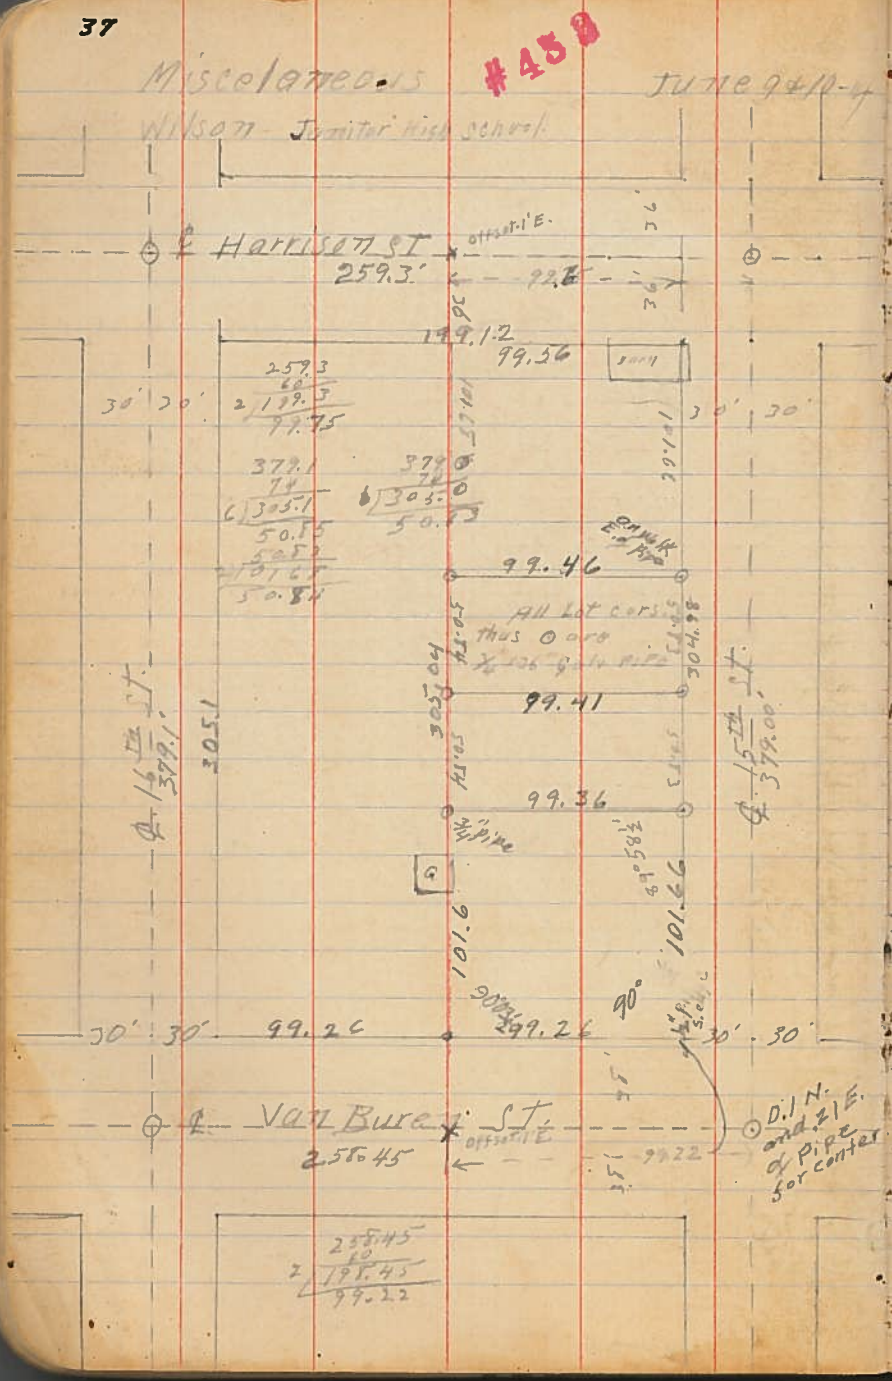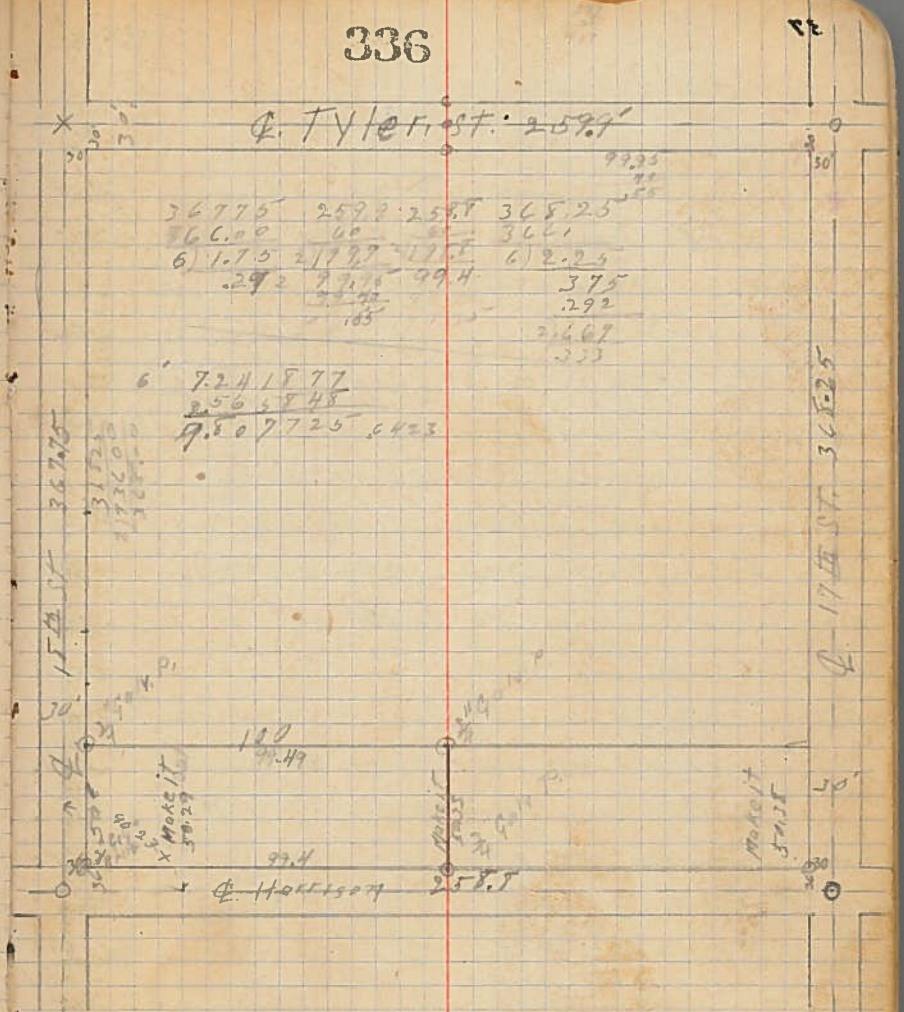
Wilson Junior High School