465

465

~~211~~
465

County Survey No. 211 465

Made for E. C. Lake and others

In Section 7. T. 14 S., R. 4 W. Will. Mer.
Benton County, Oregon. Sept. 1 to 5. 1914
Scale 3.00 chains to 1 inch

W. C. Galloway County Surveyor
By Burdette Wilkes
Deputy

Area inside Shore line 92.43 Acres

18.84 Acres

Iron pipe
1.02
1.23 Acres low bottom
5.00
2.34
original
← 32.64
Iron pipe
← 19.90
N. 0° 39' E.
Range line
19.90
Sec. 12
Sec. 13
Sec. 7 Iron pipe
Sec. 18
Iron pipe
S. 89° 3' W. 21.174
S. 89° 41' E.
Iron rod
Iron bar
W. R. Iron bar
S. 89° 3' W. 11.39
S. 89° 12' E. 7.62
S. 0° 32' W. 20.00
N. 0° 23' W. 20.182
5.00
S. 61° 10' E.
4.687
3.78
5.00
4.687
3.80
Present
Shore
5.00
S. 55° 5' E.
2.54
2.582
S. 59° E.
Line
Low
Water
Line
(Approximate)
9.72
Gravel
12.40
Bar
2.8.62 Acres
3.16
5.00
3.54
Shore
5.00
S. 44° E.
4.96
7.26
27.20
S. 00°
Orchard
8.38
4.06
4.22
Line
Shore
3.16
5.00
S. 45° W.
3.57
S. 8°
3.57
.96
8.17
6.32.2
S. 10° 45' W.
0.36
S. 45° 59' W. 7.881
0.48
Iron pipe
Iron bar
S. 89° 3' W. 11.39
S. 89° 12' E. 7.62
W. R. Iron bar

54 54

FB #17

Eugene

C.S. 211 – C.C. Lake – lots 5, 6, 7 + ¼ of 4

Sec. 7 – T 14 S R 4 W.

Begin at Com. pipe 19.90 N of 12/7 / 13/18 Ref CS. 161

Run about E along ℄ Road

21.714 1" iron pipe

Turn angle R 90°40' = S by needle

"B"

"C"

East.

From large stone in ℄ Road E of River

Supposed to be 7/5 / 18/17. Run W down ℄ Road

40.44 Point Near River

∠ R 6°49' to "C" ③

Set Cor, S. 1467 + W. 20.98'

Should go. 140 S.

Should go. 140 S.

Station 0.77, Sand bar

Point Near River

Falls 37 N of 1/7 / 6/5

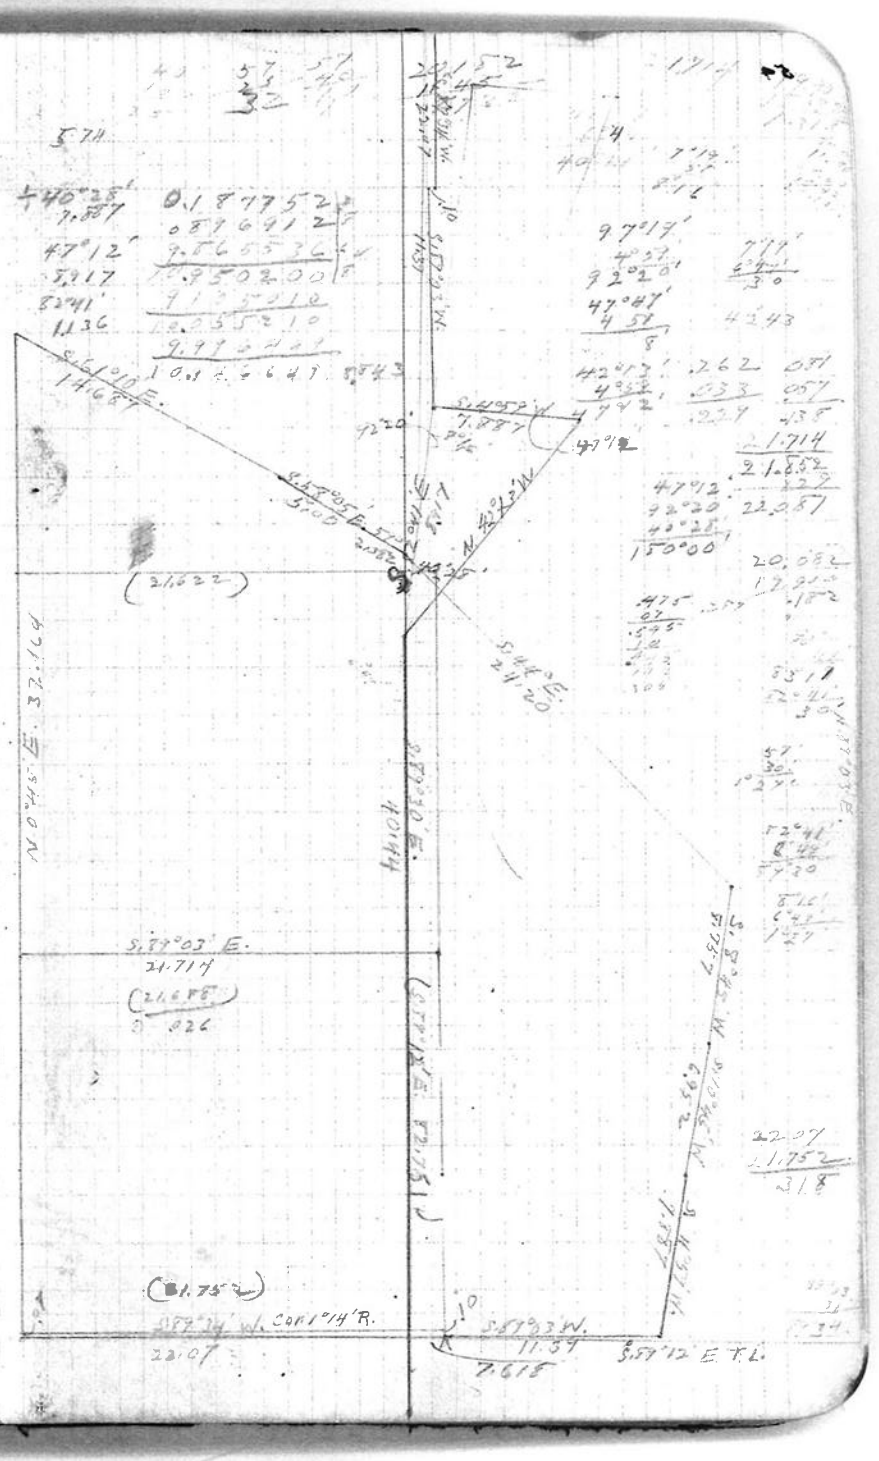

55

CS.465

Begin again at gal Pipe at Needle = N45°E. 19.90 W of 11/2 13/19

Run North "D" fence ∠ not taken

19.905 19.905 Pass .033 E. of ½-pipe

D 25.00 25.00

② 32.164 32.164 ± of beam 1.2 Mine
Mark Maple 16 S 55½° W. 16.4 .245 Maple 16 N 5° W. 17.1 .026 set ½ pipe 28"

"E" No

D S. 61°10' E. D 5.00

④ 4.287

⑤ 5.00 14.687

S. 58°05' E.

⑥ 5.12

⑦ S. 59° E. 2.582

⑧ S. 44° E.

⑨ 5.00 10.00

⑩ 5.00 15.00

⑪ 5.00 20.00

⑫ 4.20 24.20

D S. 5°45' W. 5.00

⑬ 3.757 8.757

D S. 12°45' W. 6.952

D S. 4°59' W. 4.000

⑭ 3.887

"C" bears S 59°52' W

Stake on E bank bears S. 82° 41' E

N 2.23

N 5° E 1.55 E. 3.24

N 5° E 2.52

N 2.72

N 3.40 W. 3.15

S. 4.96

N. 14.90
S. 8.37
E. 7.25
E 4.06

E. .62
E. .51
W. 3.16
E. O.K.
W. .96

W 1.36

5.845' 8.116726
32.164 1.507316
H 21 1.624242

61°10' 9.683284 9.942517
14.687 1.166726 1.166933
7.083 10.850217 11.109450 1.2546
209 241

58°05' 9.723177 9.728815
5.00 0.698970 0.698970
26.44 10.422167 10.427785 4.244

59° 9.711853 9.733066
24.52 0.411956 0.411956
1.330 10.123809 10.145022 2.213

44° 9.841771 9.856934
24.20 1.383815 1.383815
16.811 11.225586 11.240749 17.408

5.845' 9.182196 9.994916
8.757 0.942355 0.942355
1.332 10.124551 10.937271 8.653

10°45' 9.270735 9.972311
6.952 0.842110 0.842110
1.297 10.112845 10.534421 6.530

14°59' 9.938850 9.978555
7.887 0.896912 0.896912
.686 9.835762 10.075267 7.857

89°03' 8.219581
11.29 1.052524
.189 9.276105

.032' 7.968870
8.732 0.941114
.081 8.709984

0°17' 7.694173
44.5 1.058802
.057 8.752978

89°03' 8.219581
21.714 1.337
360 9.556241

360
138½°
121
180
58½°

238½
1.2546
58½