C.S. # 473

Hardcopy City Plat #14

F.B. 13-53

SURVEYORS

Book #13.

MINING
TRANSIT BOOK
363

53

Estab NW Cor of Blk 6. 20.3 E + 10.1 S of mk.

" SW " " " " " 20.61' S mk.

Location = SE Cor of intersection of Jackson St. & 25th St.

#478

25th & Jackson St.

$\frac{40}{41.22} : \frac{20}{20.61}$ etc. $\frac{20}{20.63}$ $\frac{40}{41.66}$ ±

25th Van Buren

$\frac{40}{40.16} : \frac{20}{20.3}$ $\frac{10}{10.15}$ etc.

6 | 20.61 (3.43)

46.10
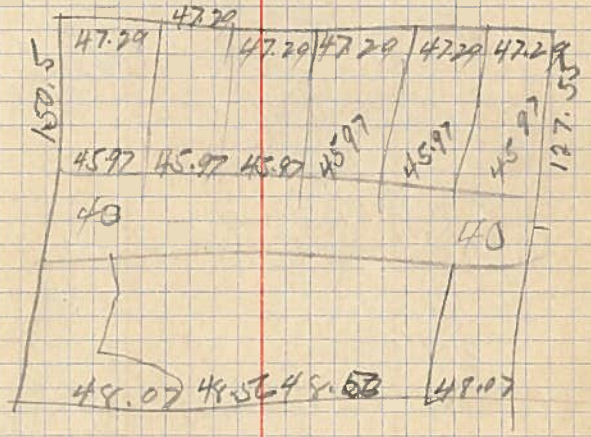
49.93