C.S. # 475

Hardcopy 14-6 #8

also see notes in file

F. B. 17-64

SMWL

64

F.B. # 17, PG. 64

Herman C.

C.S. # 215 ∧ Buckingham C.153-14-6

Wed. Oct. 15-1914

Begin at stone on S. line of C.I. at 25.00 from Needle = N. 20° W. Cedar Fence post at Creek for line

∧ Cor. North, 3.046 - 144° ℄ Road

Thence along Road.

N. 70°12' W.	1.003 + 5°	.996	
	4.945		
	4.147 + 3/4	5.144	
N. 70° 24' W.	6.743 - 1/2°	6.741	
N. 88° 12' W.	6.500 + 2/4°	6.494	
	1.905 —	8.399	
	5.044		
	5.055 - 3 3/4	13.443	
S. 77°49' W.	2.355	2.355	Temp. For. trial line
	(4.531 + 1°		set stake for future reference
North			on trial line
	5.00		
	4.749		
	(2.009	11.758	For Meander line
	+ .45		Small creek ℄ E.
N. 86°26' E.	+ 3.115		Main Creek ℄ E.
			← from N. cor 1.12 W. of this point
	17.767	→	creek is N. 54 —
N. 72°39' E.	1.10		11 N. 50
	2.30		1.52
	3.40		1.96
	5.00		1.64
	7.10		1.90
	8.10		1.74
	9.62	10	1.96 Point on E. line
South	19.66		beg. PT bears South 0.4
From N.W. Cor. of tract			
N. 24°47' W.	3.349	Point at bend of creek.	=N. 3.041 + W. 1.404
			Cor. .85 N. Ash
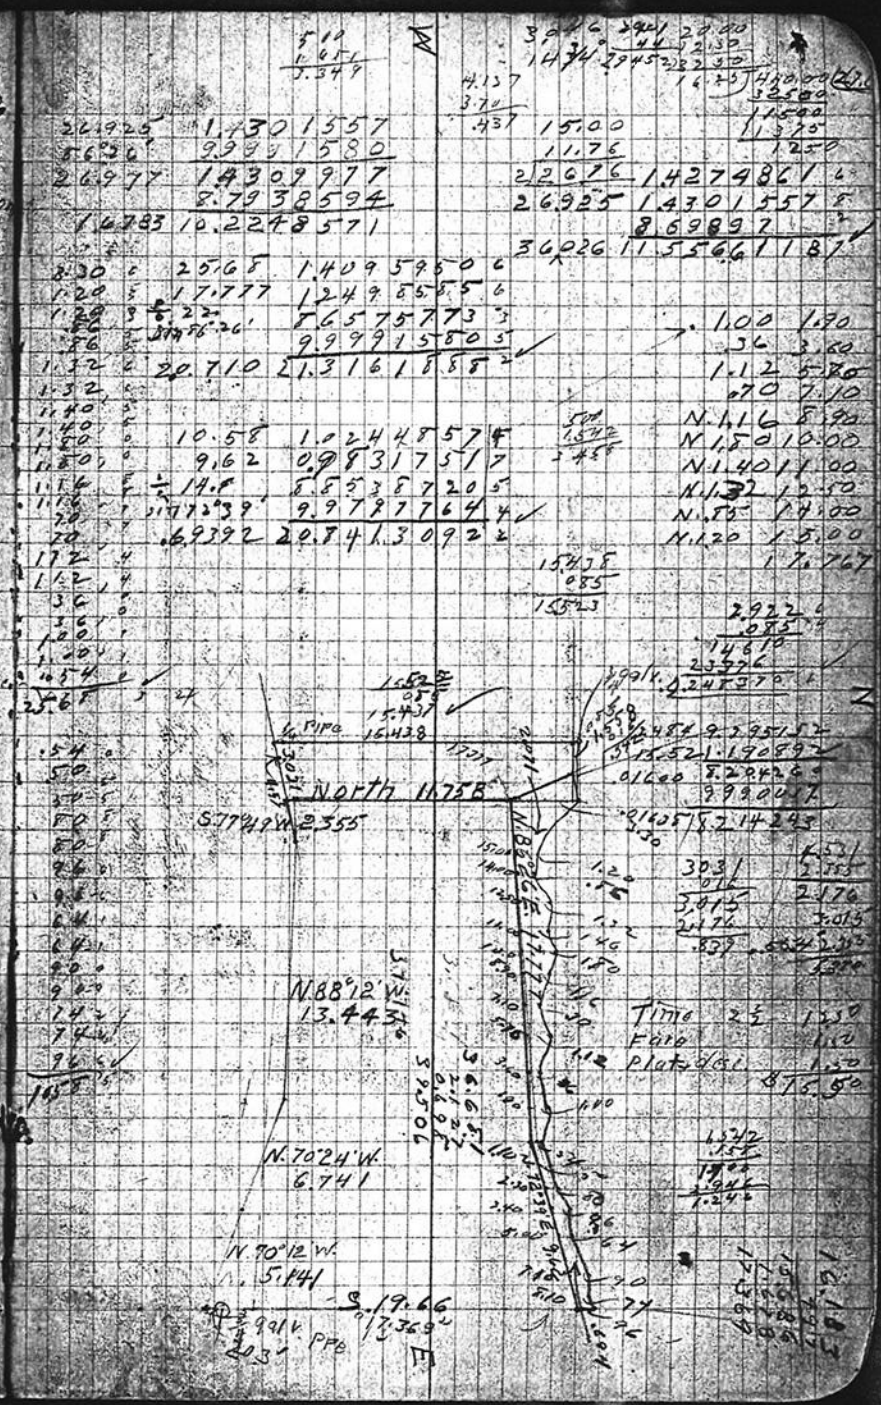
#475