486

II-6&7
13, 24, 18

COUNTY SURVEY #~~196~~ 486

T. 11 S. 6 & 7 W. W. M.

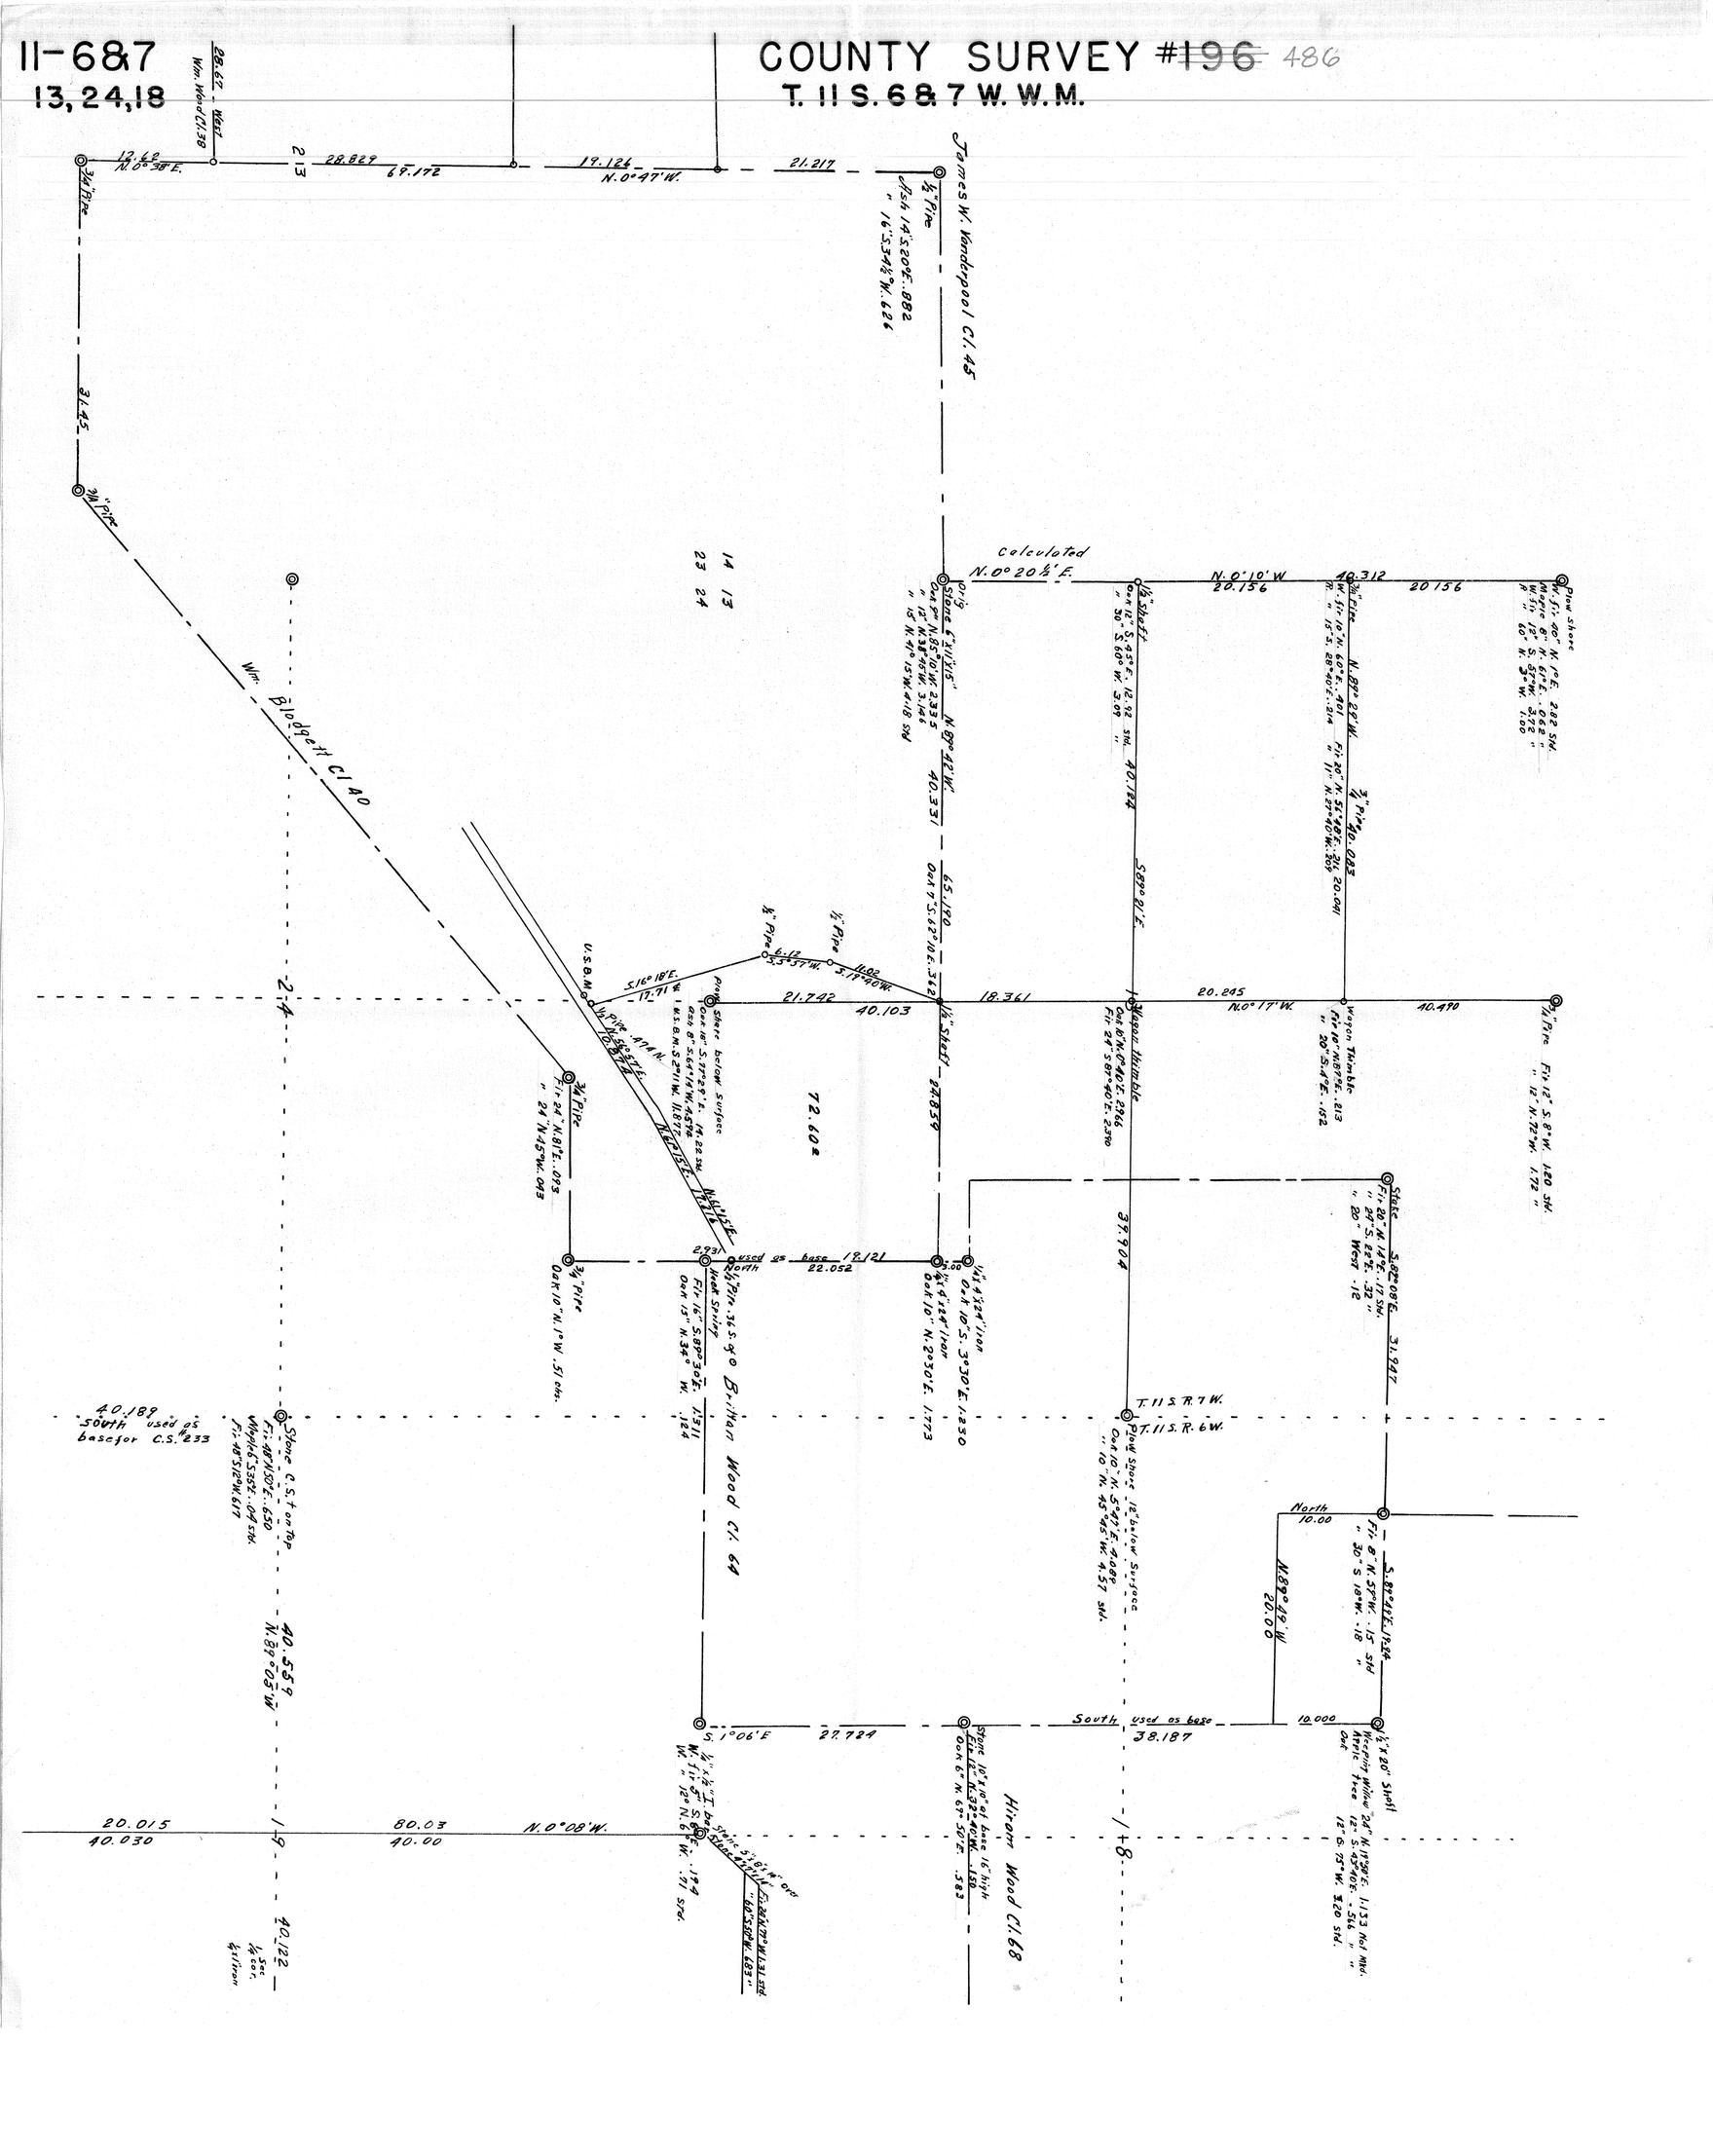

F/B # 18, Pg. 27-31

F/B #18 #486 Pg 27-31

27 C.S. #196 For L.H. Hawley, Jr.

N.W. cor. of Britton Wood Ct. 37

Re est Tp. 11 S. Rs. 7 & 6 W.

	Set	Stake	orig. cor.		
	Fir	20" N. 74° E. .17	cds.	std	
	dead "	24" S. 22° E. .32	"	"	
	"	20" West .12	"	"	
		N. 8° 55' E.			
		Correction 3° 07' S.			
1		(S. 89° 08' E.)	1° 36'	6.346	
2			2° 30'	2.240	
3			4° 50'	1.793	
4			9° 33'	2.040	
5			14° 44	5.411	
6				2.051	
7			3° 30'	1.156	
8			8° 55'	2.486	
9			11° 42'	4.408	
10			3° 20'	.734	
11				2.782	
12			3° 10'	.923	
13	cds.	L. R 90° 9'	7° 38'	2.218	
	Set	Stake	orig. cor.		
	Stump	Fir 8" N 59° W. .15	std.		
	dead "	30" S. 28° W. .18	"		
14		S. 89° 08' E.	N. 3° 11' O	5.957	
15		correction 41' (S. 89° 49' E.)	6° 45'	5.062	

Fir 11" diam. Mar 3, 1942 N. 12° W. 198 links

" 14" N. 57° W. 170 "

Blazed but not marked

31.945 = 31.86 on 2.198

M. P. Rycraft

64

6.346 2.040 5.411 4.408 6.193

29579 41689 21769 22979 2.238

57114 18360 48699 39672 1.784

4442 1632 3246 3085 2.012

317 122 378 396 5.233

51 2 5 8 2.051

6.193 2.016 43161 1.156

2.486 5.2329 2.486

19789 2.218 32.35 2.782

12374 4.199 30.953 30.955

1988 1.996 1.397 .922

198 1.996 31.877

19 2 .006

2 2 31.871

2.1982 .06998 = 31.86

2.198204

1912 4

28606

25495

31 1060

28 6821

2423 90

5062 .94762 31.945

70394 31.86990

45558 299286

4555 194640

151 94762

3 94 27780

69 7858

44 9220

3 9048

5017 20

5.945

5.027

10.972

28

16 -11° 4.755

17 -11°40 4.545

N.E. of Brinton Wood Cl. #64 -.153 = 19.938

Striking S. of cor.
Set 1½" Shaft 20" long .238

Weeping Willow 24" N. 19°50' E. 1.133

Apple tree 12" S. 43°40' E. .566

Oak 12" S. 75° W. 3.20 stk

Set a plow share
Starting at △ cor. N. 7°43' E. 2.386 = 2.344 chs. stk

13/24 Oak 18" S. 87°30' E. 14.22 chs.

Ash 8" S. 65°15' W. 9.594

N 0°23' E. -3° 40' 8.000
correction W. + 1° 6.920
(N. 0° 17' W.) +6°40' 8.000

18 +9° 1.207
+.068
E. .052

Set 1½" Shaft

Oak 7" S. 62°10' E. .362 chs.

+13°30' 8.005

19 +1.7° 1.209

20 +6°55' 2.343

6.620

21 7.694

22 L Left 3°50' 3.536

unmkd bngs. have these no connection

304 W. of Co.

Offset 237 W.

Edwin Johnson, Virgil & John Skaggs.

4.755 4.545 19.938

36189 43979

42795 40905

3804 3181

47 409

28 13

1 1

46676 44509

1.207 1.209 2.343 2.386 2.354

96789 03659 27299 46721 18099

10863 10881 21087 23462 21477

965 604 2108 477 21

87 72 46 144 23442 7.944

7 3 44 2.344

1.1920 1.1560 23251 3.043 5.625

offset 80597 .01162 = 40 6.919

3936 .937 7.946

.0669 80597 1.192

31824 131030 21.682

21216 30597 7.784

2121.6 504330 1.156

23654 483582 2.326

207480 32.948

7.944 11.314

40.592 3.528

.483 50.790

40.109

N. to con. sec.

29					
23			2°10'	3.366	
24			19°22'	3.910	
25			11°40'	.590	
26			9°40'	1.192	
				+.747	
				W. 1.54	with correction 4/0'
	Set Wagon thimble				
	Fir 10"	N. 87° E.	.213	chs.	
	" 20"	S. 4° E.	.152	"	
27				1.341	
28				1.138	
29			14°	2.666	
30			15°49'	4.505	
31				1.029	
32	L Right 11'		5°	5.166	offset .016 E.
33			12°10'	2.519	
34			2°25'	2.942	
	Reset			+.014	
12/13	Striking E of cor.			.412	
	Set 3/4" pipe	orig. cor.			
	Fir 12"	S. 8° W.	1.20	Std.	
	" 12"	N. 72° W.	1.72	"	
35	Back To Δ 20	North		7.644	
				+ .183	
9/13	set Wagon thimble			W. .167	
	Oak 10"	N. 0°40 E.	2.966	chs.	
	Fir 24"	S. 87°40 E.	2.390	"	

3.916 590 2.666 4.505
2.349 4.379 .030 4.129
35.190 53.13 2.392 40.545
15.647 5.31 1.866 2.703
1.17 .51 .07 .90
.15 .5777 2.5847 .04
.36886 .01
5.147 43.343
2.519 .023 59.604
4.379 .15441 -0.997
2.671 .1029
1.763 .0164+0
1.176
.12
.1
2.4623

80.597
40.109
40.488

50.790
3.363
3.689 8
57.842
.578
1.186
1.341
1.138
2.567
4.334
1.029
5.147 5
5.182 3
3.462
2.939
.017 2
80.597
40.109
2|40.488
20.244
40.109
60.353
39.606
.747
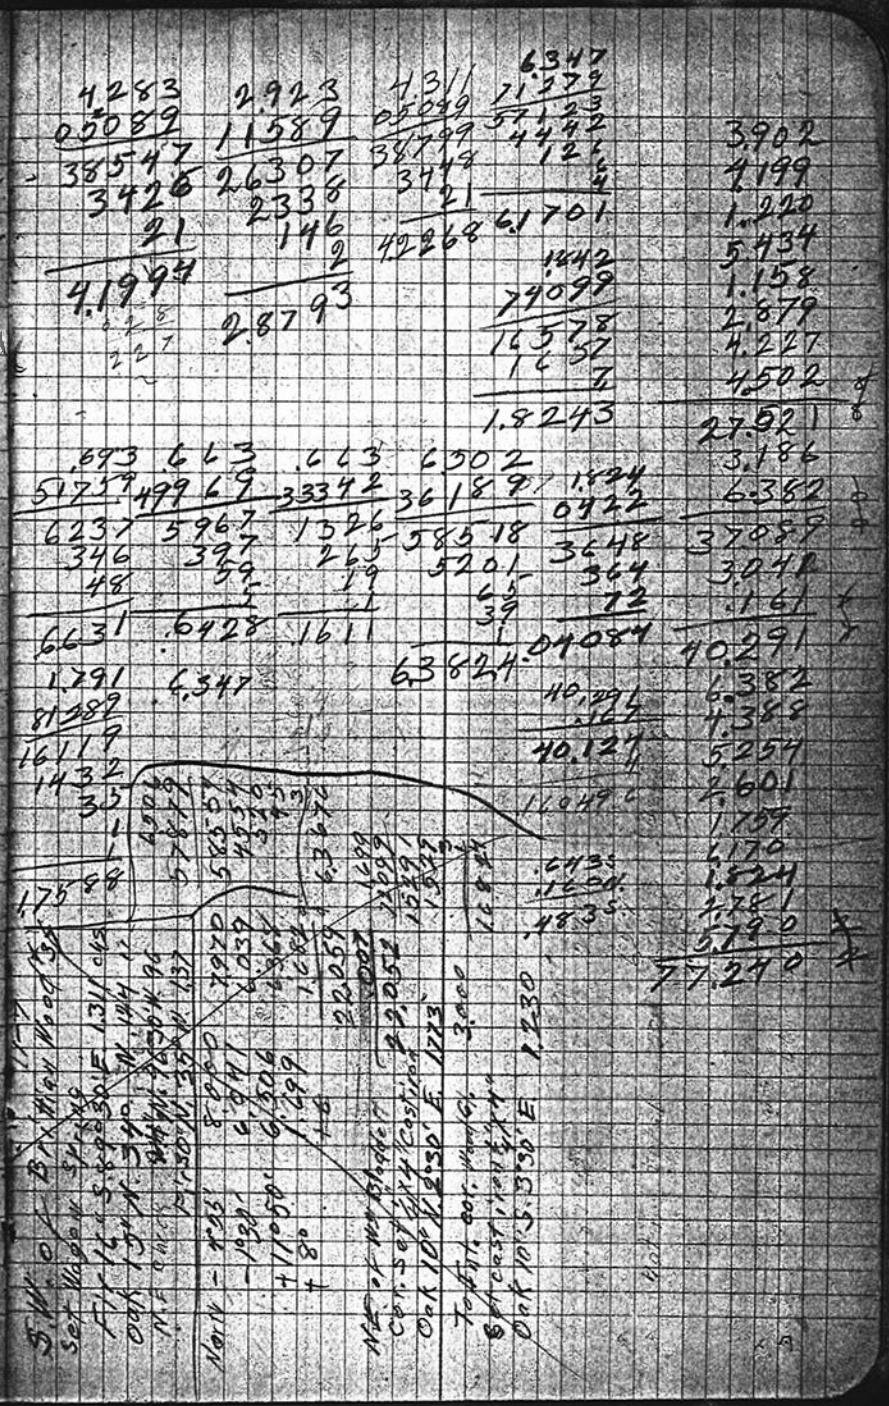
30	36	N. 89°07'W.	3°	3.907	
		corrections .14'	11°20'	4.283	
		(N. 89°21'W)	1°15'	1.271	
37					
38			4°20'	5.450	
39			5°35'	1.163	
40			9°54'	2.923	
41			11°20'	4.311	
42			1°5'	4.503	
43			2°30'	3.189	
44				6.382	
45			1°50	3.043	
Reest				+.161	
14/13	Striking N. of cor.			.643	
	Set 1½" shaft		orig. cor.		
	Oak 12"	S. 45° E.	1.292	std.	
	" 30"	S. 60° W.	3.09	"	
	Back to △ 35				
46	S. 89°07'E.		11°	6.502	
47	correction N.14'		2°	4.391	
48	(S. 89°21'E.)			5.254	
49			4°10'	2.609	
50			10°30'	1.791	
51			13°33'	6.347	
52	L L Left	1°17'+	7°55'	1.842	0/Eq .041 N.
53				2.781	
54			3°15'	5.807