C.S. # 487

See notes in file

F.B. 17-75

75 FIB 217, P. 75 14-645

Cont. 85 - Jesse Belknap Cl 41

Everett Hanshew 12/7-10-14

Begin by setting flags at cor. on N. line about 5.00 E. of cor 7 Cl 41 - Cl. 41 - 7.50 S. of 7 41 + 7.50 S. of Cl. 41

With N. line of Cl. as S. 89° 45' W. - E. line S. 0° 09' W.

Begin at 7.50 S. of 7 Cl. 40

S. 89° 45' W.

12.030 falls .078 S. of 7 M. Berry Tracts - (J.A.G.)
Set iron pin Round head Taper of ½" to ⅜" x 14"

12.97 Set Temp. div. cor.
Set ¾ x 20" pipe at -.15 + N 10.77
(F.M. Berry Tracts)

52.455 falls .044 N of F.M.B.T.s. iron pin ℄ Road

N. 11° 50' E. 5.42 ∠ in Road

4.144 = L. Church lot 31.32' E. ℄ Road Set 1½ x 30 Pipe

N. 16° 30' E. 7.277 ⊙ N. line Cl.

18.420 Pipe Cl. E. Hanshew's Tract

Back to ℄ Road & N. line Cl.

#487

N. 89° 45' E.

6.475 set Temp 7 Church lot. set 1⅜ x 32" shaft

S. 90° 90° 3.00 = ⊥ " " set 1¼ x 32" ∠ iron.

37.479 set Temp div. cor. Set 1" x 14" pipe

50.303 7 Cl.

AT. 37.479 - Run N. 0° 09' E.

11.034 approx. N. line E.H.s. 4.53 W. of his 7 cor.
Set 1" x ¾ L. in R.

length of his E. line 13.732

AT. 37.479 Run S. 0° 9' W. -

7.50 Intersect S. line a. 150 E. of Temp. cor.

Move this S. line N. To conform with N. line Midway Berry Tracts.
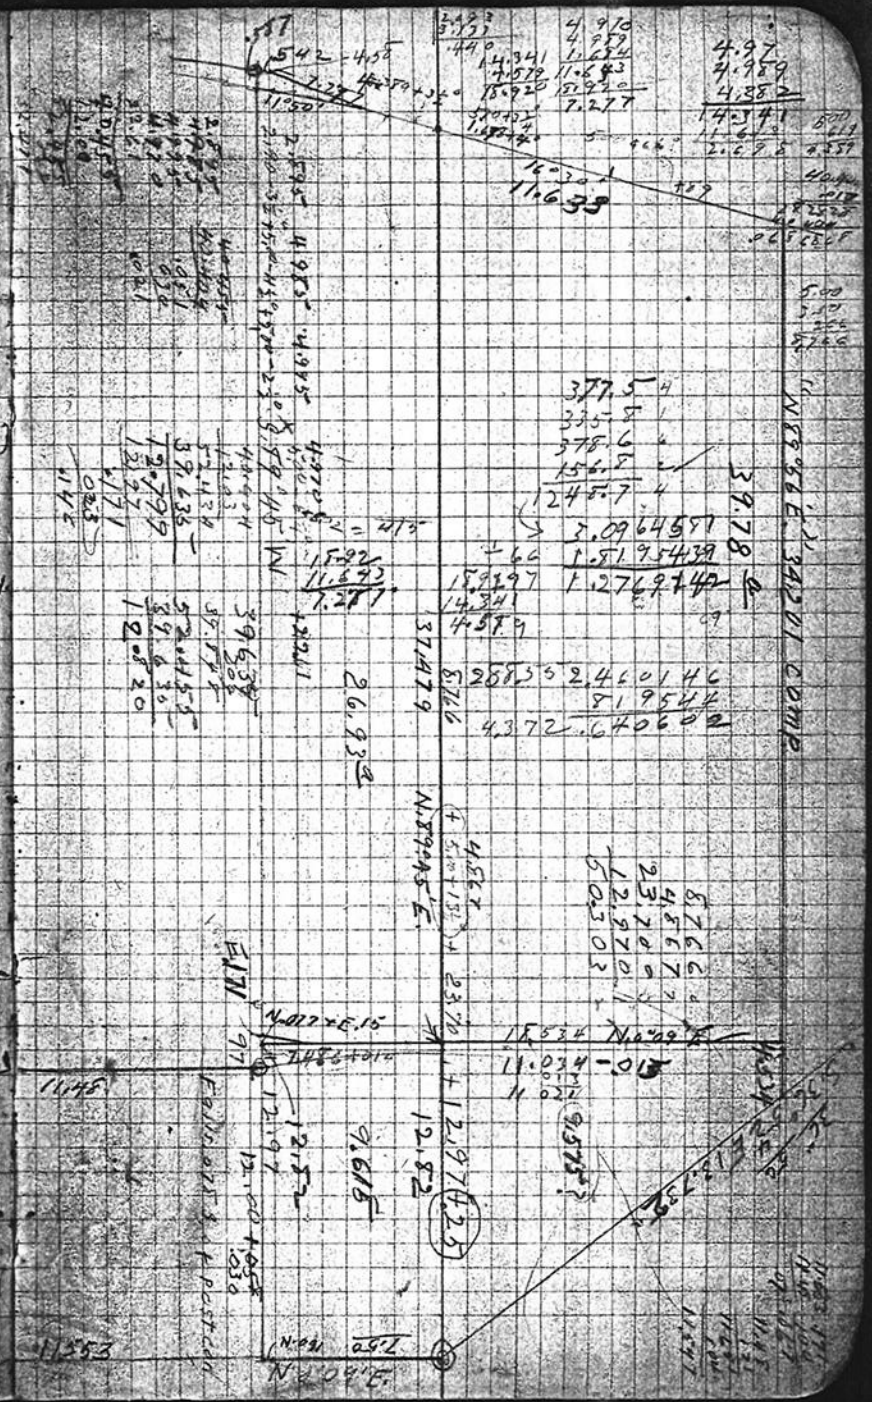
Bears S. 87° 42' W.