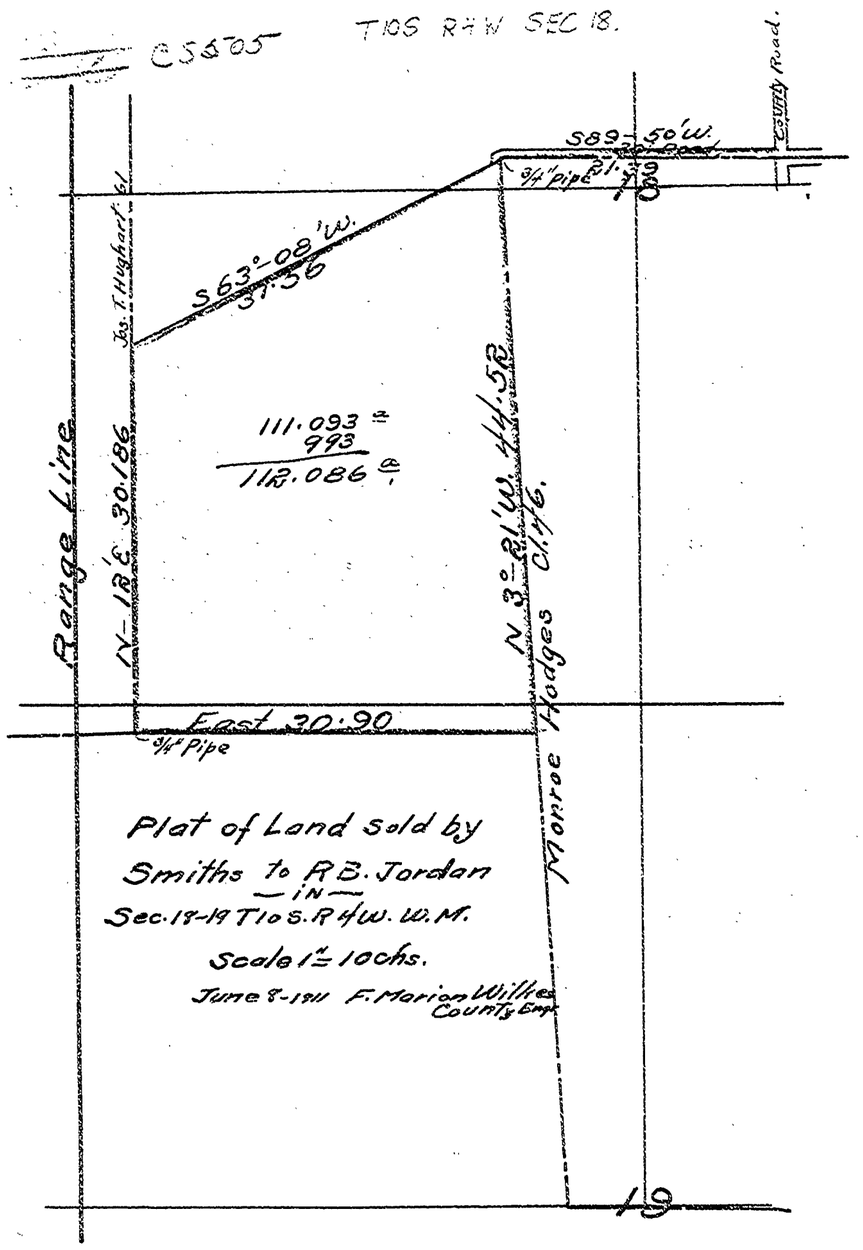
T10S R4W SEC 18.
County Road.
S89-50'W.
3/4" Pipe
21.39
S63-08'W.
37.56
Jos. T. Hughart
Range Line
W-18 & 30.186
111.093 ch
993
112.086 ch
N 3°-21'W. 44.58
Monroe Hodges C.1/4 C.
East 30.90
3/4" Pipe
Plat of Land sold by
Smiths to R.B. Jordan
IN
Sec. 18-19 T10 S. R4W. W.M.
Scale 1" = 10 chs.
June 8-1911 F. Marion Wilkes
County Engr.
19

F/B 19, PG 12

12/12 CS-221, Concluded

#505 CS #505

2/2 = 1.5

Begin at P.I. W. Line Hodge Cl. & S. Line of Hudgens Cl. produced E. set W. 3.95' Produce line

Set Flag at P. Hodges

①	4.635	12° 4.533	4.533	=W. .41' = 4.36
②	1.90	+7½° 1.884	6.417	W. 55 = 4.53
③	3.619	+4° 3.610	10.027	-10,890 = 89.94' (Set Stone S-347 Oak 10 inches)
④	1.872	-5° 1.865	11.892	-.91 = +.863 Temp Stake 1.05 5.03 N. 12.51' W. 14.2'
⑤	3.658	-12° 3.578	15.470	1.41' 5.364
⑥	.167	.167	15.637	1.142 5.37, C.R. 0°05' = R. 011 = .65'
	5.100	+5¾° 4.975	20.612	1.93'
⑦	3.315	+6¼° 2.301	22.913	2.07 - .604 - .65 = 5.36. 2.07 = .625 = 5.57
⑧	1.964	+1½° 1.963	24.876	Pt. E of Fence cor.
⑨	3.514	+3½° 4.505	29.681	2.81 = .66 - .23 = 5.98
⑩	4.944	4.944	34.625	3.16 = .211 = 6.143 Point E of ⊐ Roberts Cl.
⑪	2.505	2.505	37.430	
⑫	.932	.932	38.362	+.028 Falls .035 E. L. M.H. Cl. 4.4
		.028	38.390	

Set Stone S-347 Oak 10 inches 9 Set Stone S-348 Oak 10 inches 12 Set Stone S-349 Oak 10 inches 10 Harris Tract

By div. line = N. Line Harris as E. & W. W. line Rand. = N. 3° W.

Begin again at P.I. Run line N. Toward P. Hodge: Set Stake 3.95' W.

	=10.843 From P. Hodges	10.543	
⑬	5.100 - 14½°	4.846	15.689
⑭	1.292 - 10°	1.270	16.959
⑮	3.599 - 10¾°	3.479	20.436
⑯	1.887 - 6¾°	1.874	22.310
⑰	1.919 - 5°	1.912	24.222
	-5.100 - 8¾°	4.948	29.170
⑱	2.927 - 4°	2.927	32.097
		32.097	32.265 + .103 Mon. Rock 10 Hot.
			.103 Cor. CS. 221 Centres

This should be set .030 Chs. S. of Tree. RW.