C.S. # 508

Hardcopy City Plat # 6

also see notes in file

F. B. 19-16

16 #508 FB#19

Block 24 - County Add.

Miscel. Prof. Brandon -

9th bet. Van B. & Harrison

Property line on 9th 306.52'

" " " 8th 306.50'

" " " Harrison 221.37
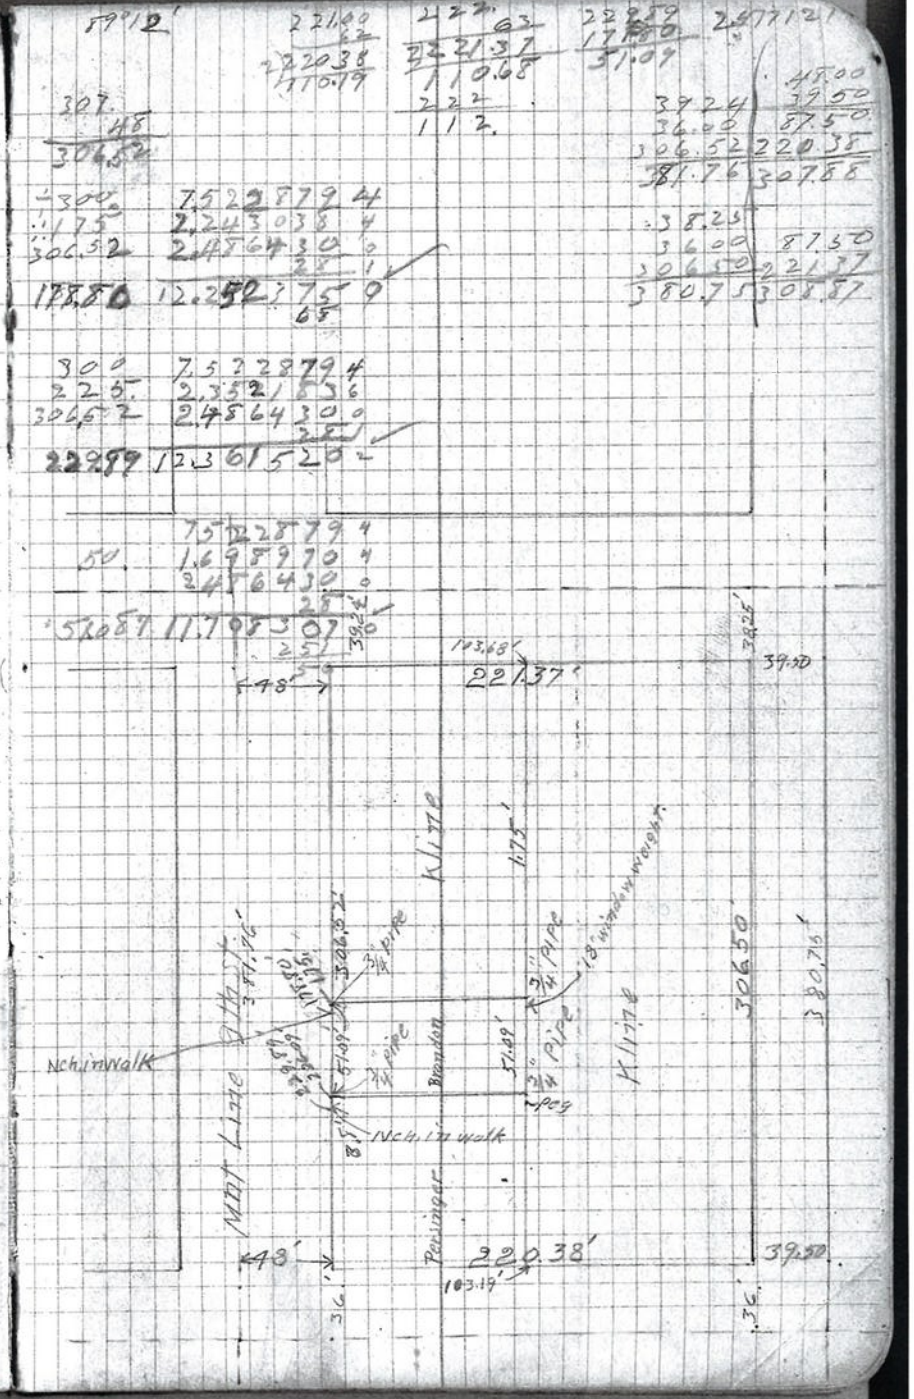
" " " Van B. 220.38