510

C S 510

Block 6, Dixon's Add. to Corvallis, Benton County, Oregon.

Tyler Street

Scale 1" = 30'

W. C. Galloway
County Surveyor
Feb. 18, 1944.

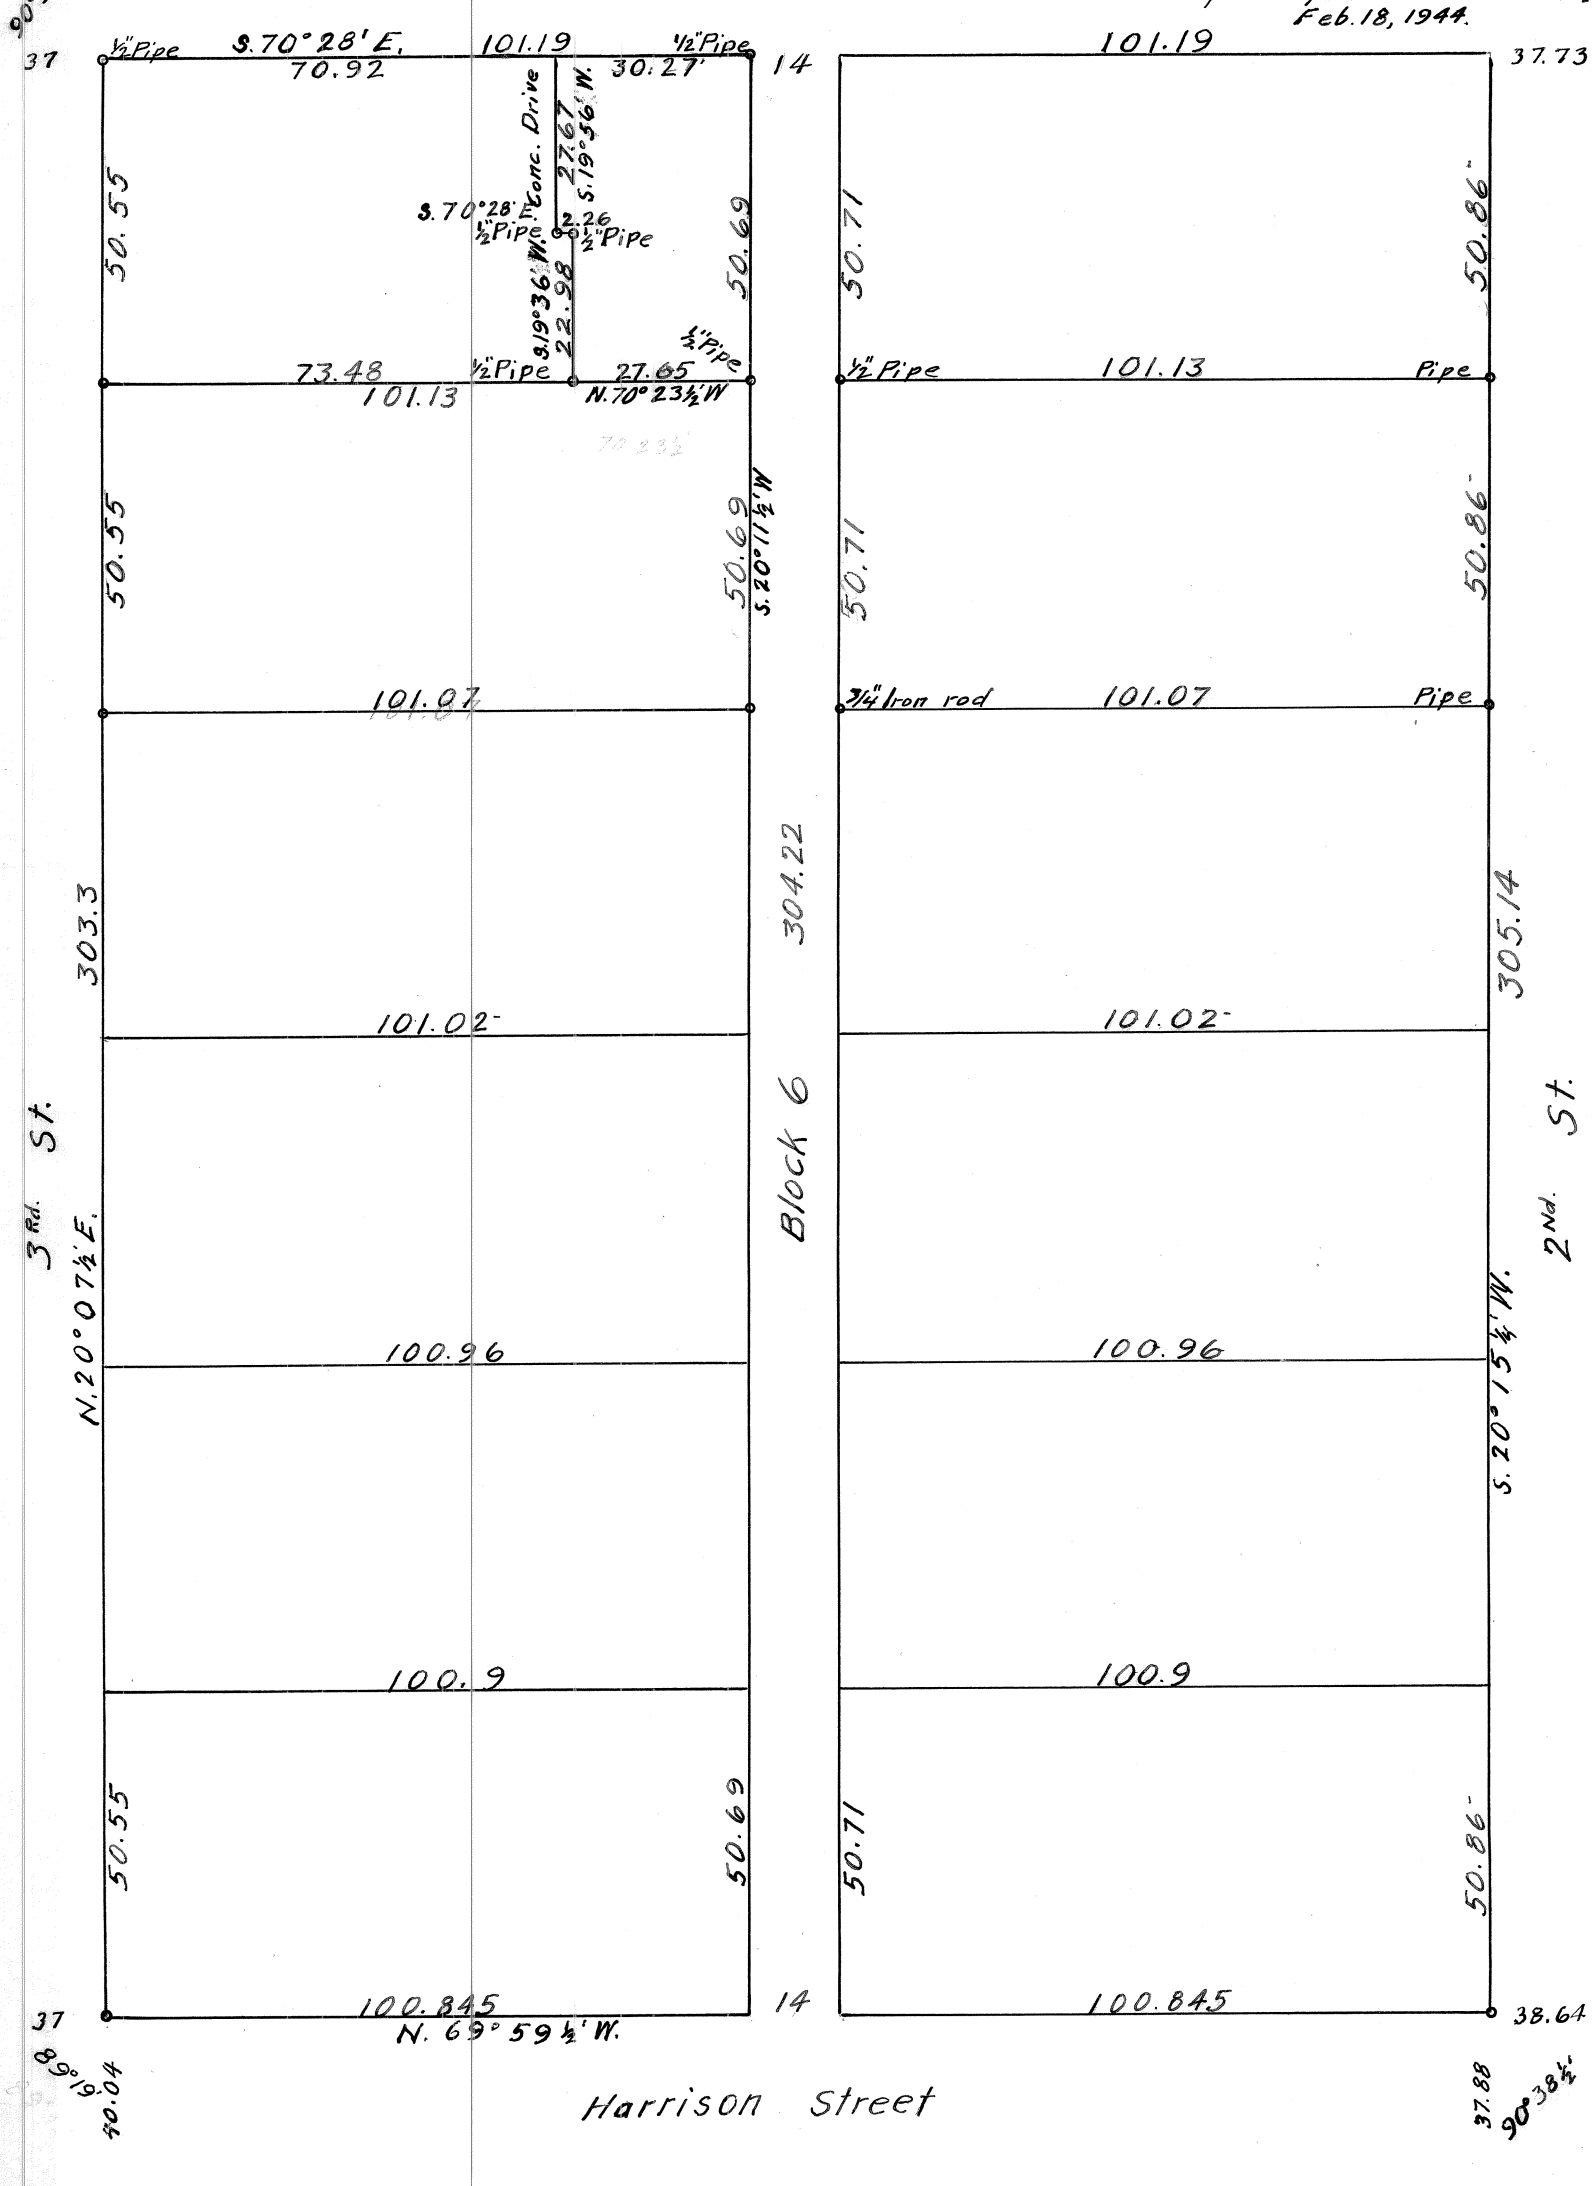

510

18 FB#19

#510

Miscel. - Mrs. Anna Bryant.

Property Line W. side 2nd 305.18'
" " E. side Alley 304.16'
" " S. " Tyler 216.3'
" " N. " Harrison 215.6'

At ± lot 1=4 Block, set 3/4" pipe
" L. " 1=100.8 W of 4, 3/4" "
" 7 S½ 3 = 127.15' N of 1, 3/4" "
" F. " 3 = 126.74 N. of L. 1 " 1 3/4" "
" 50'S. of 7 S½ 3 = 77.15 N. " 1, 5/8" "
" 50'S. of F. S½ 3 = 76.74 N. " 1, 5/8" "

50.69 / 304.14 — 50.70 / 304.20
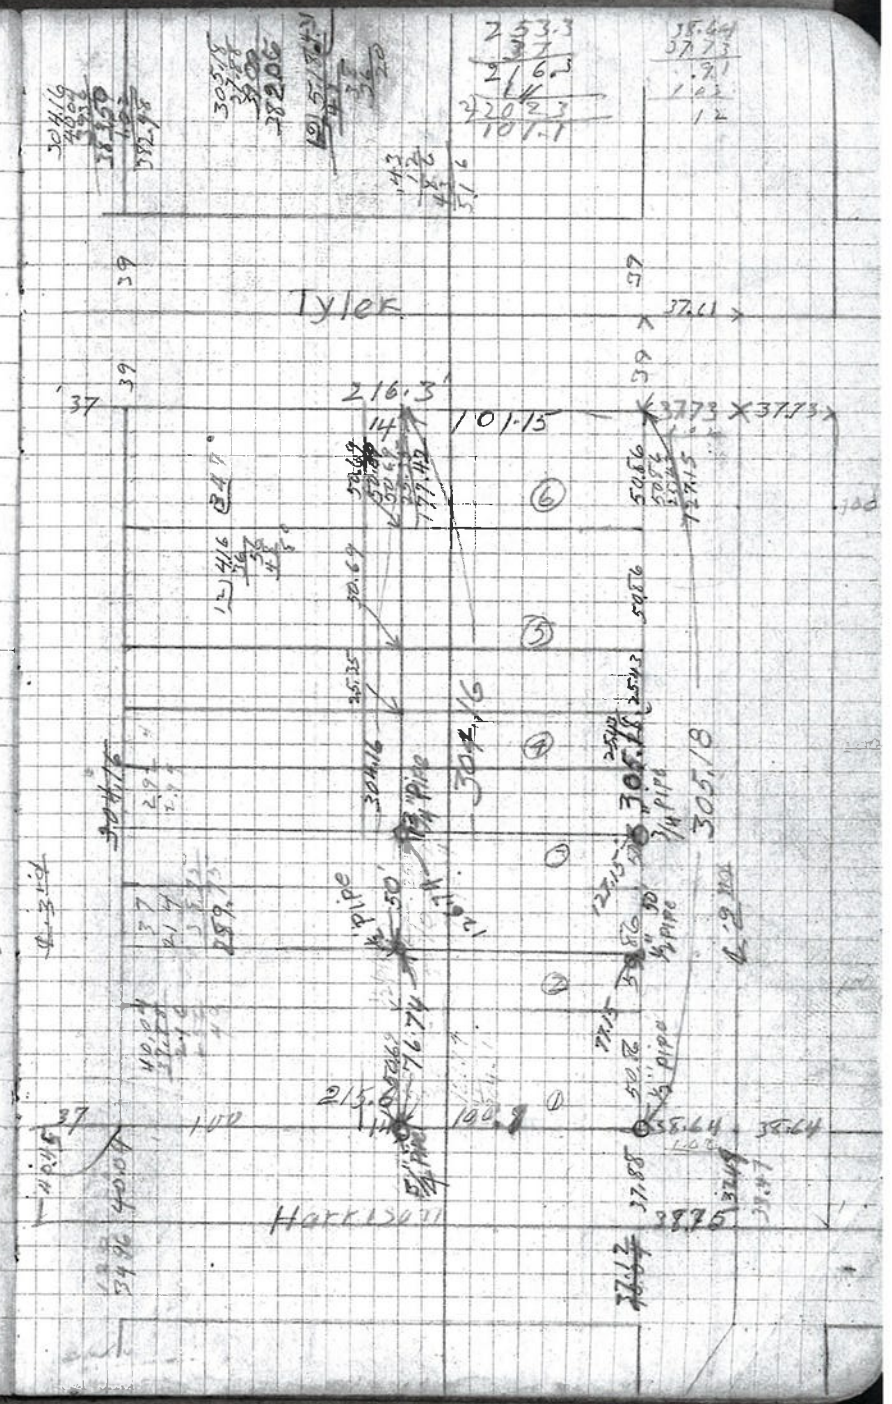
Self 3.00
Ward 1.50
$4.50