C.S. # 512

Hardcopy 12-5 # 10

also see notes in file

F. B. 19-19

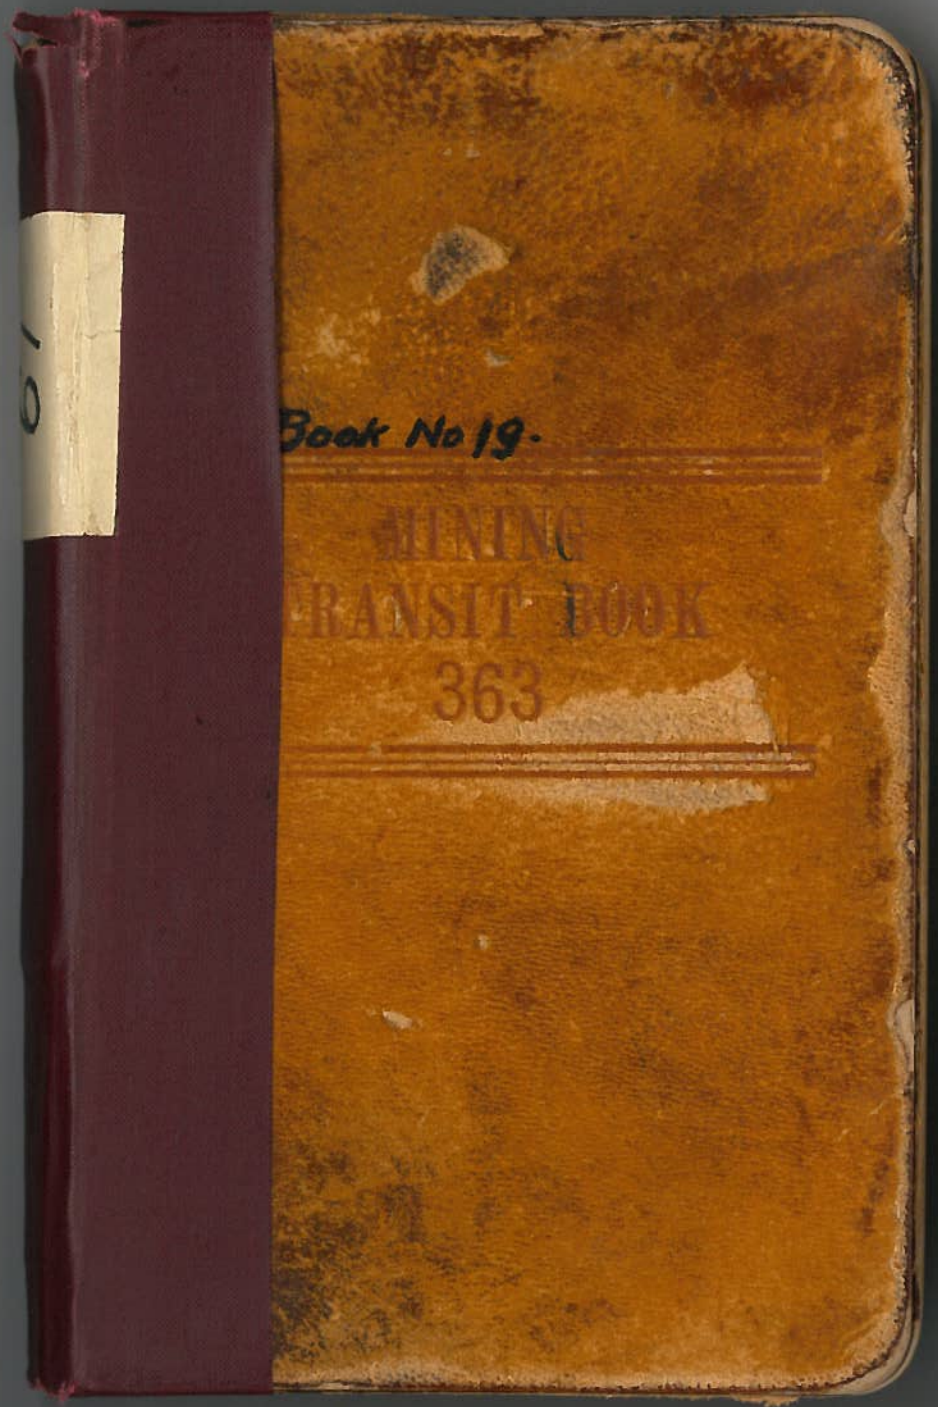
Book No 19.
MINING
TRANSIT BOOK
363

19

4/23-15. #~~510~~ 512 CS-10171

Jos W. Brown - 2A

CS

Cont. K-16 Cl. 46

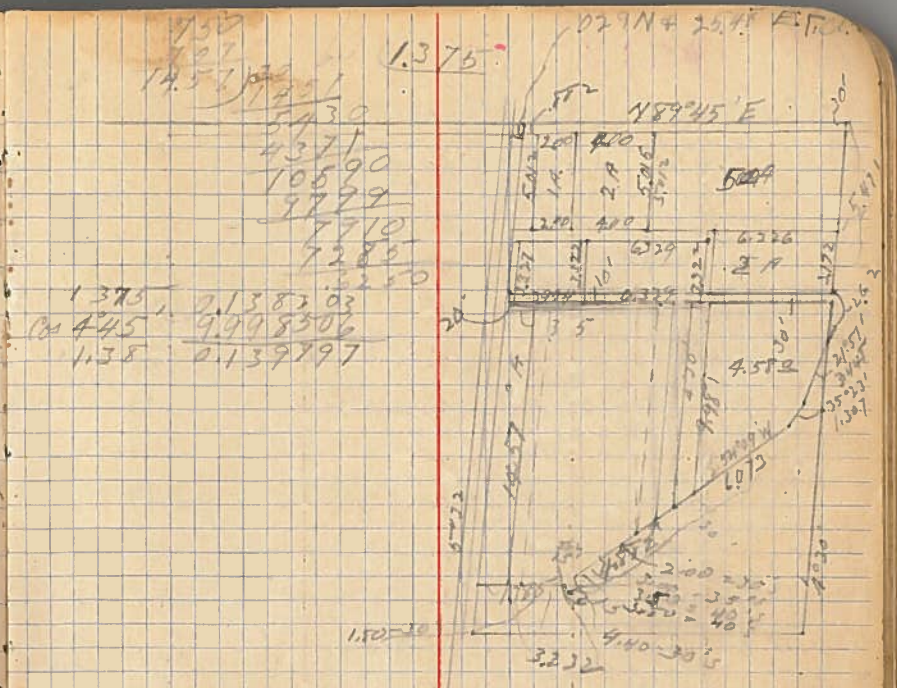

Desc. C.E.L. Pege E 24.676 & S. 8.277 chs.
F.J.C. Alexander Cl. 46-12-5-N.M. B.C.O.
S. 5°32' W. 14.57 chs. N 89°45 E 1.385 chs. N. 5°32 E
14.57 chs. S. 89°45' W. to 2 A.