BLOCK No. 5

College Hill Addition

to

Corvallis

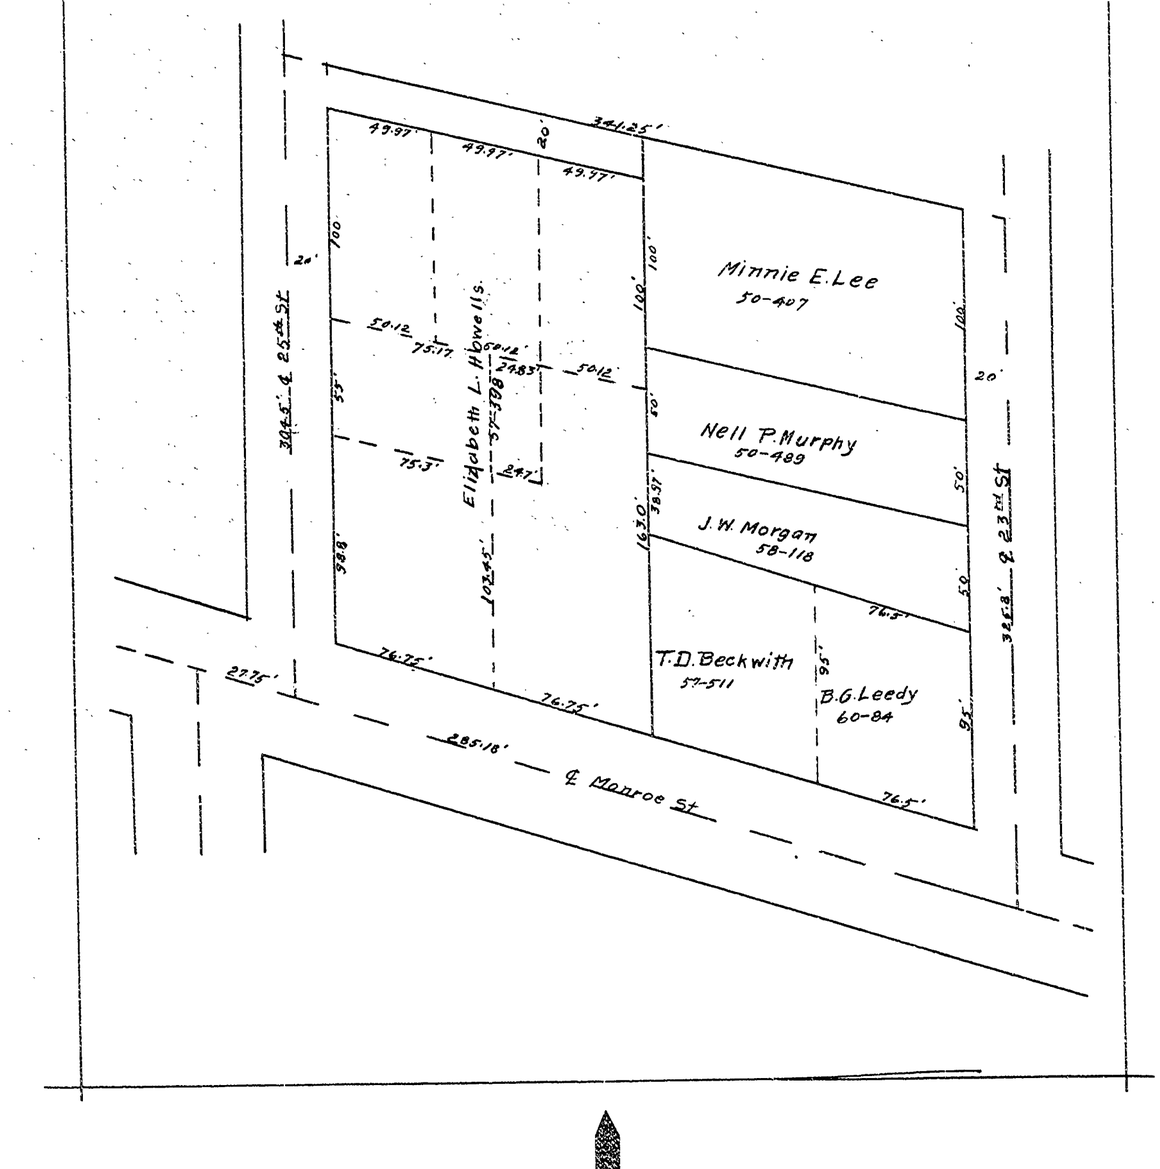

20 #513 FB #19

Miscel. - Dr. E. L. Howells. 25th Monroe.

W½ Block 5. College Hill Add.

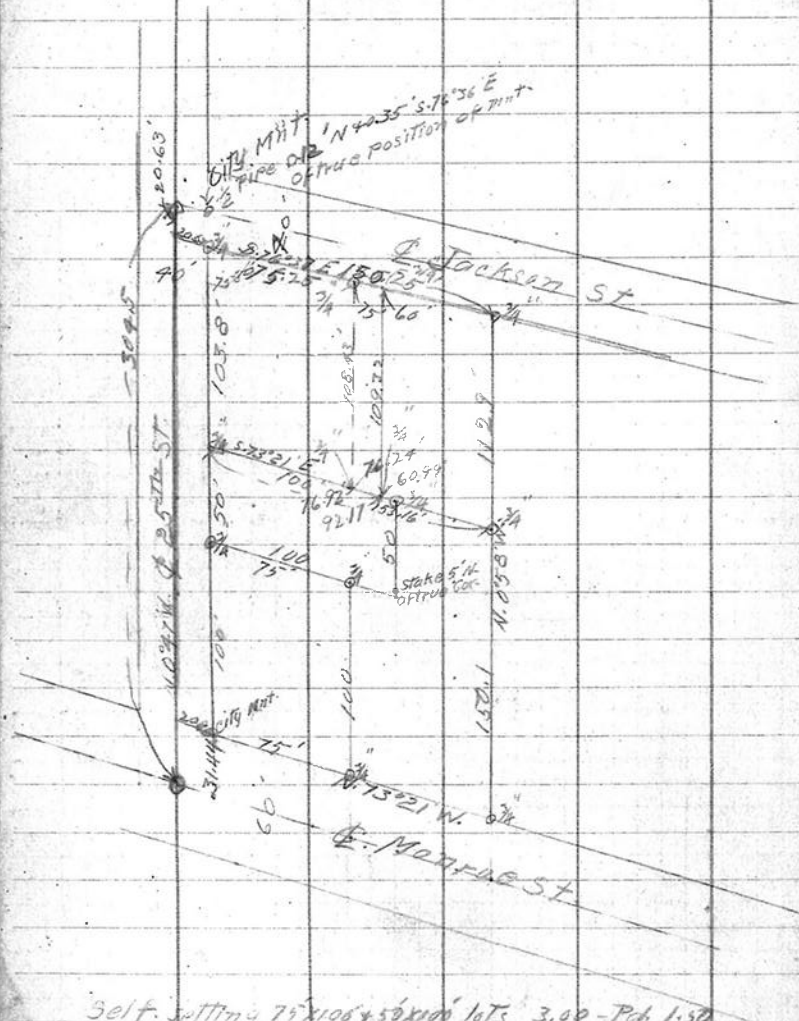

Self. selling 75'x106'+50'x100' lots 3.00 - Pd. 1.50

" " Remainder + Plat. 3.00

W. W. " " 1.50

$6.00

N. 73° 21' W. N. 0° 58' W.

Mnt. 25 - Van B. 10' S. of ℄ Mon.

℄ 25th Monroe 102° 26'

Harrison