C.S. # 515

Hardcopy 10-5 # 9

also see notes in file

F. B. 13-62

62

FB# 13

#515
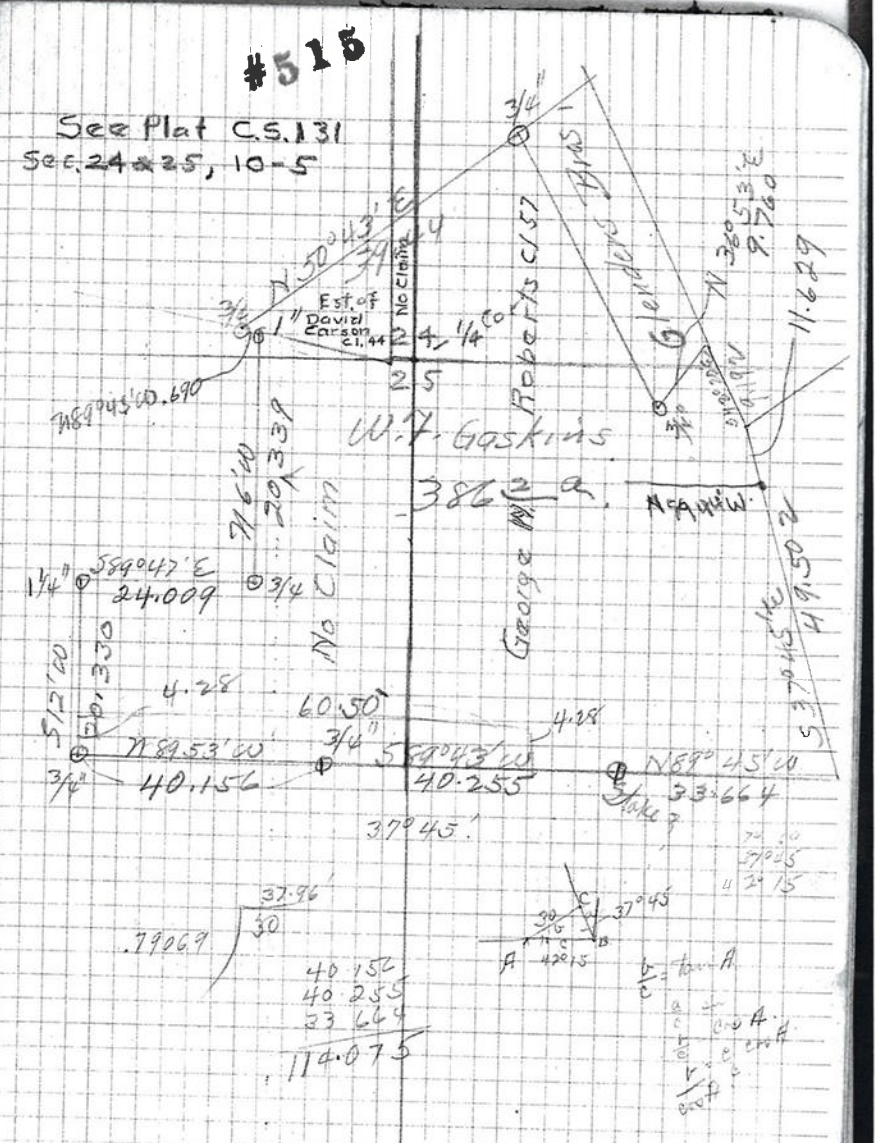
See Plat C.S. 131
Sec. 24 & 25, 10-5