C.S. # 518

Hardcopy 14-5 # 25

also see notes in file

F. B. 20-1

C.S. #242 for notes F/B 20, Pg. 1-2

#518 Survey of Gravel Pit For County

T. 14 S. R. 5 W. 28/27 33/34

May 17, 1915.

Beginning at

Set 1¼" pipe

Oak 10" N. 2° E. 1.0 ' std.

" 24" S 72° 30' E. 3.286 " cls.

" 14" S. 86° W. 1.37 std.

" 12" N. 42° 45' W. .75 cls. std.

S. 2° 29' W.

Correction 2° 29' E.

1		.623	W. 080
2		7.230	
3		6.447	
		3.593	
		−2.156 = 15.75	South.
		E. 1.685	
4		7.170	
5		7.983	offset W. 1.690
6	L Left 1° 59'	7.070	offset E. .245
		−.007	
	Striking E. of cor.	.190 < 40.142	
	Back to point 15.75 S. of 28/27 33/34		
	nail in ash E. .479		
1/2	Set ¼" pipe West	1.823 ¼" pipe	
	" ¼" " 3.175 W. of ¼" p	3.175 ¼" pipe	

7.130
8.000
8.623
15.753

17.893
15.735
2.158

17.893
15.750
2.143

.623
7.230
6.447
3.593
17.893
7.170
7.983
7.065
40.111
.007
40.104

offset 40.104

1.690 E
.245 E.
1.935 E.
.190 W.
1.745 E
.99906

.04351 = 2° 29'
1.74500
160416
140840
120312
205280
200520
476 00

40.142
40.10790
39912 "
141 600
99906
416940
399624
17316 0

7.070
1.423
2121
2828
424
2.49469

15.750
4.154
19.904

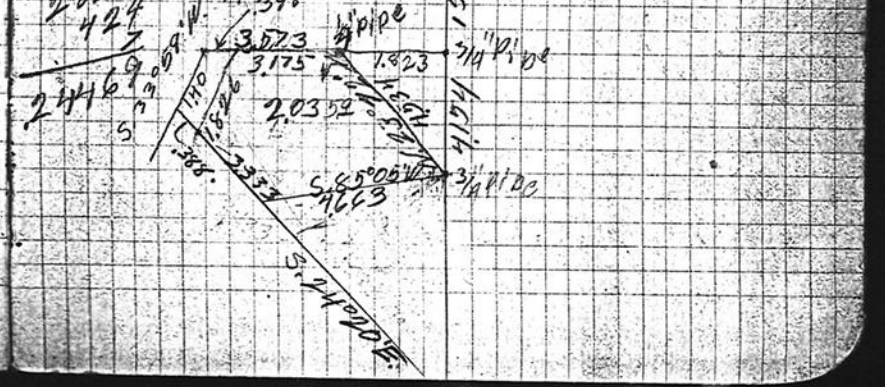

2 Back to sec. cor. 28/27 33/34

1 South 7.750

S 33° W. (S. 33° 59' W.)
correction 59'

2 L Right 224' 4.745 offset .199 W.

3 2.867

4 1.982

~~-.156 = 9.432~~

Set ½" pipe
set orer to ½" pipe S. 80 22' E. E. .364 +.063 E. .034 1.400 1.862 (S. 21° 27' W.)

~~16s~~ 3 3 S. 33° 59' W.

~~16s~~ S. 24° 20' E. 3.333

See Page 1 made change

5 L Right 2° 10' 4.456 offset .168 W.

L Right 1° 43' 8.284 offset .248 W.

6 -.534 = 21.791

Striking W. of cor. .240

Set 1¼" galv. pipe in cen. of pine stump

7750
.223
7.527

4745 4456 8.284
4819 1873 2992
18980 133689 16568
4744 31189 74556
379 3564 7455
37 4 49
.19870 .16847 .24817

offsets
.199 W. 21.788
.168 W.
.248 W.
.415 W.
.240 E.
.375 W.

.01701 = 59'
.37500
21788
.15712 0
.15 2516
46040
43576
246 40

9589
1271
9589
2712
1961

.16501 W.
.199 E.
.034

22,320
21.710
2.612

9.589
.158
9.431
.001
9.432

4.790
2.867
1.982
9.589
4.453
8.280
22.322
.534
21.788
9.580
12.208