524

PORTION OF
FISCHER BROS. MILLING CO.

Secs. 1, 2 & 12, T 12 S R 5 W. W. M.
Scale 1" = 10 Chs.

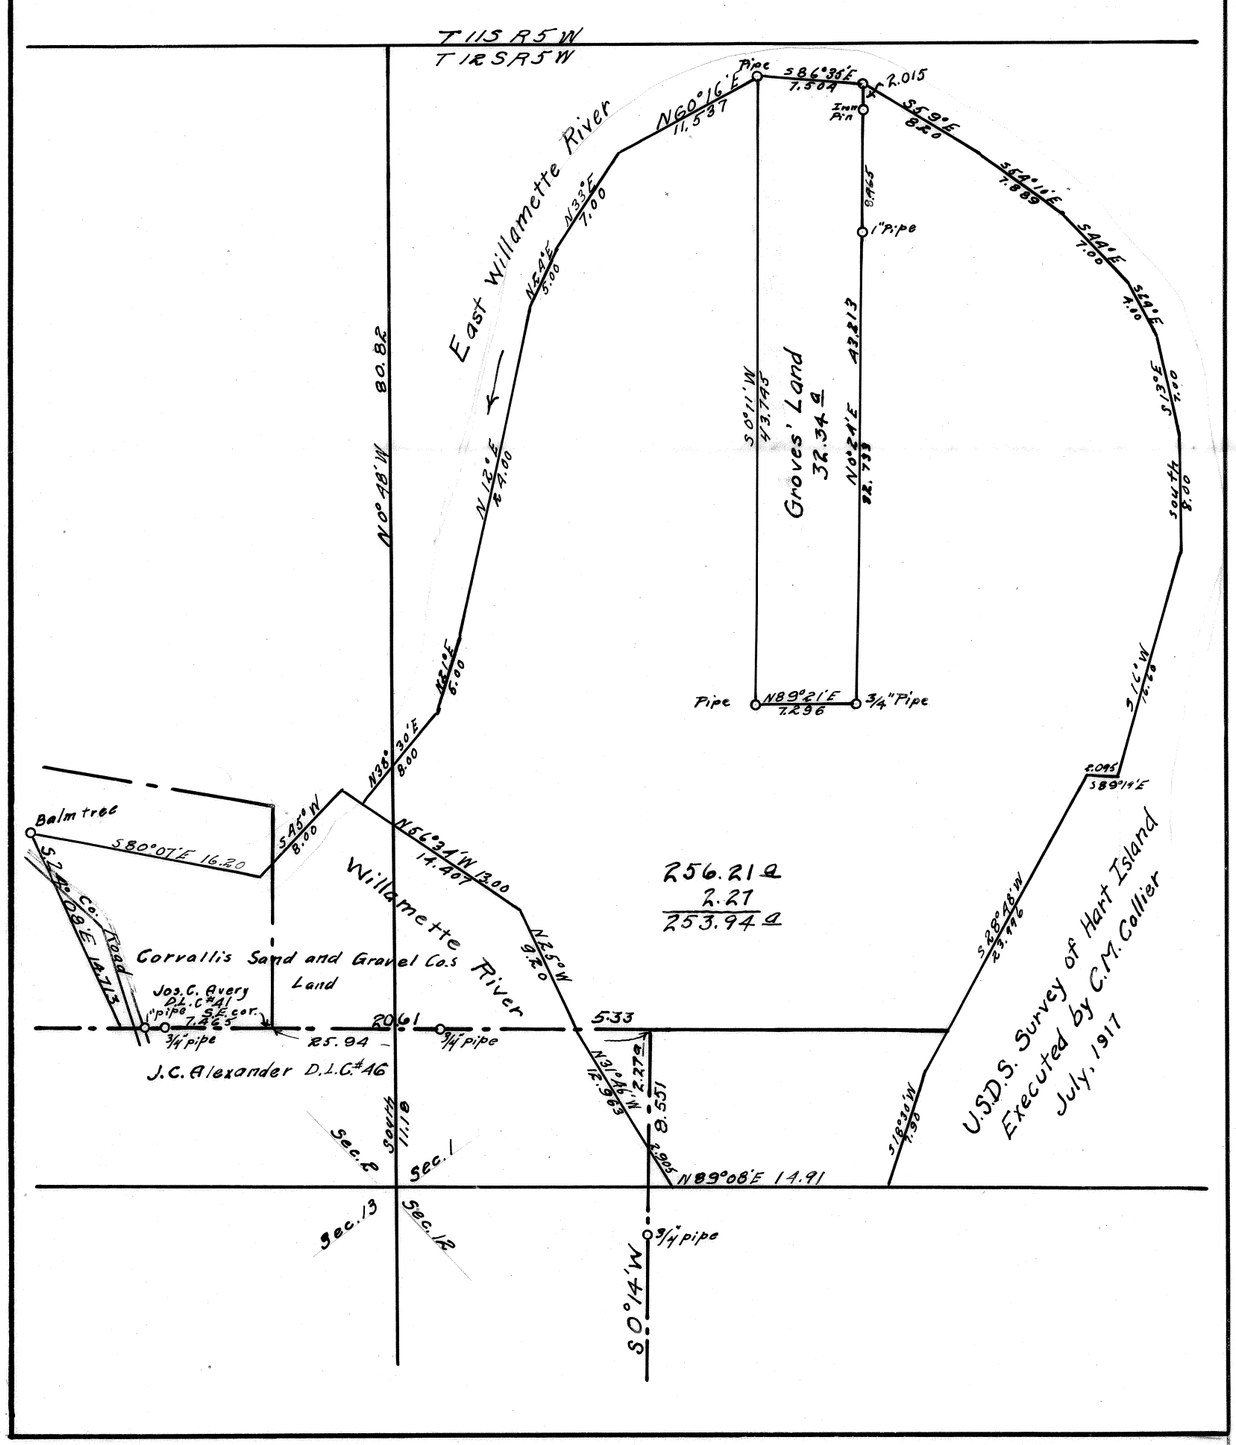

524