C.S. # 526

Hardcopy 10-6 #14

also see notes in file

F. B. 20-25

25 C.S. 276 School lot Hoskins

Beginning at S.E. cor. of the Mill property at Hoskins T.10S R6W

#526

South		7°45'	3.473
West		6°30'	.840
South			2.189
S. 45° 24' E.			1.545
S. 65° 54' E.		13°23'	.760
		3°15'	2.802
North			3.527
West			4.628
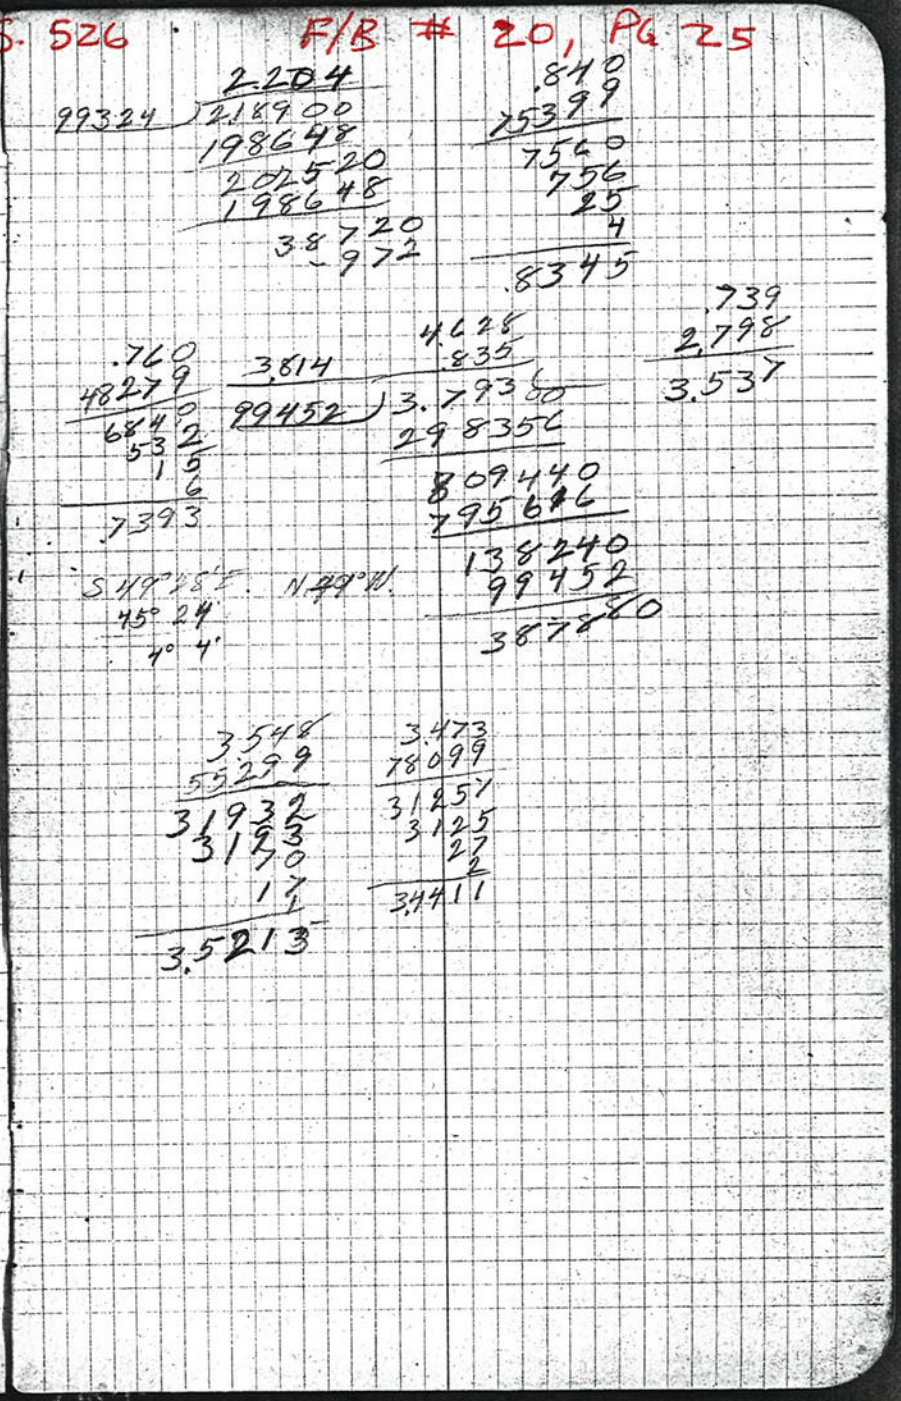
C.S. 526 F/B # 20, Pg 25