529

529

529

C.S. 244

529

PLAT

SHOWING LAND

WHICH WAS CALLED

LOW WILLOW ISLAND

IN

1853.

SECS. 1 & 12 T. 12 S. R. 5 W. W. M.

Scale 1" = 10 chs.

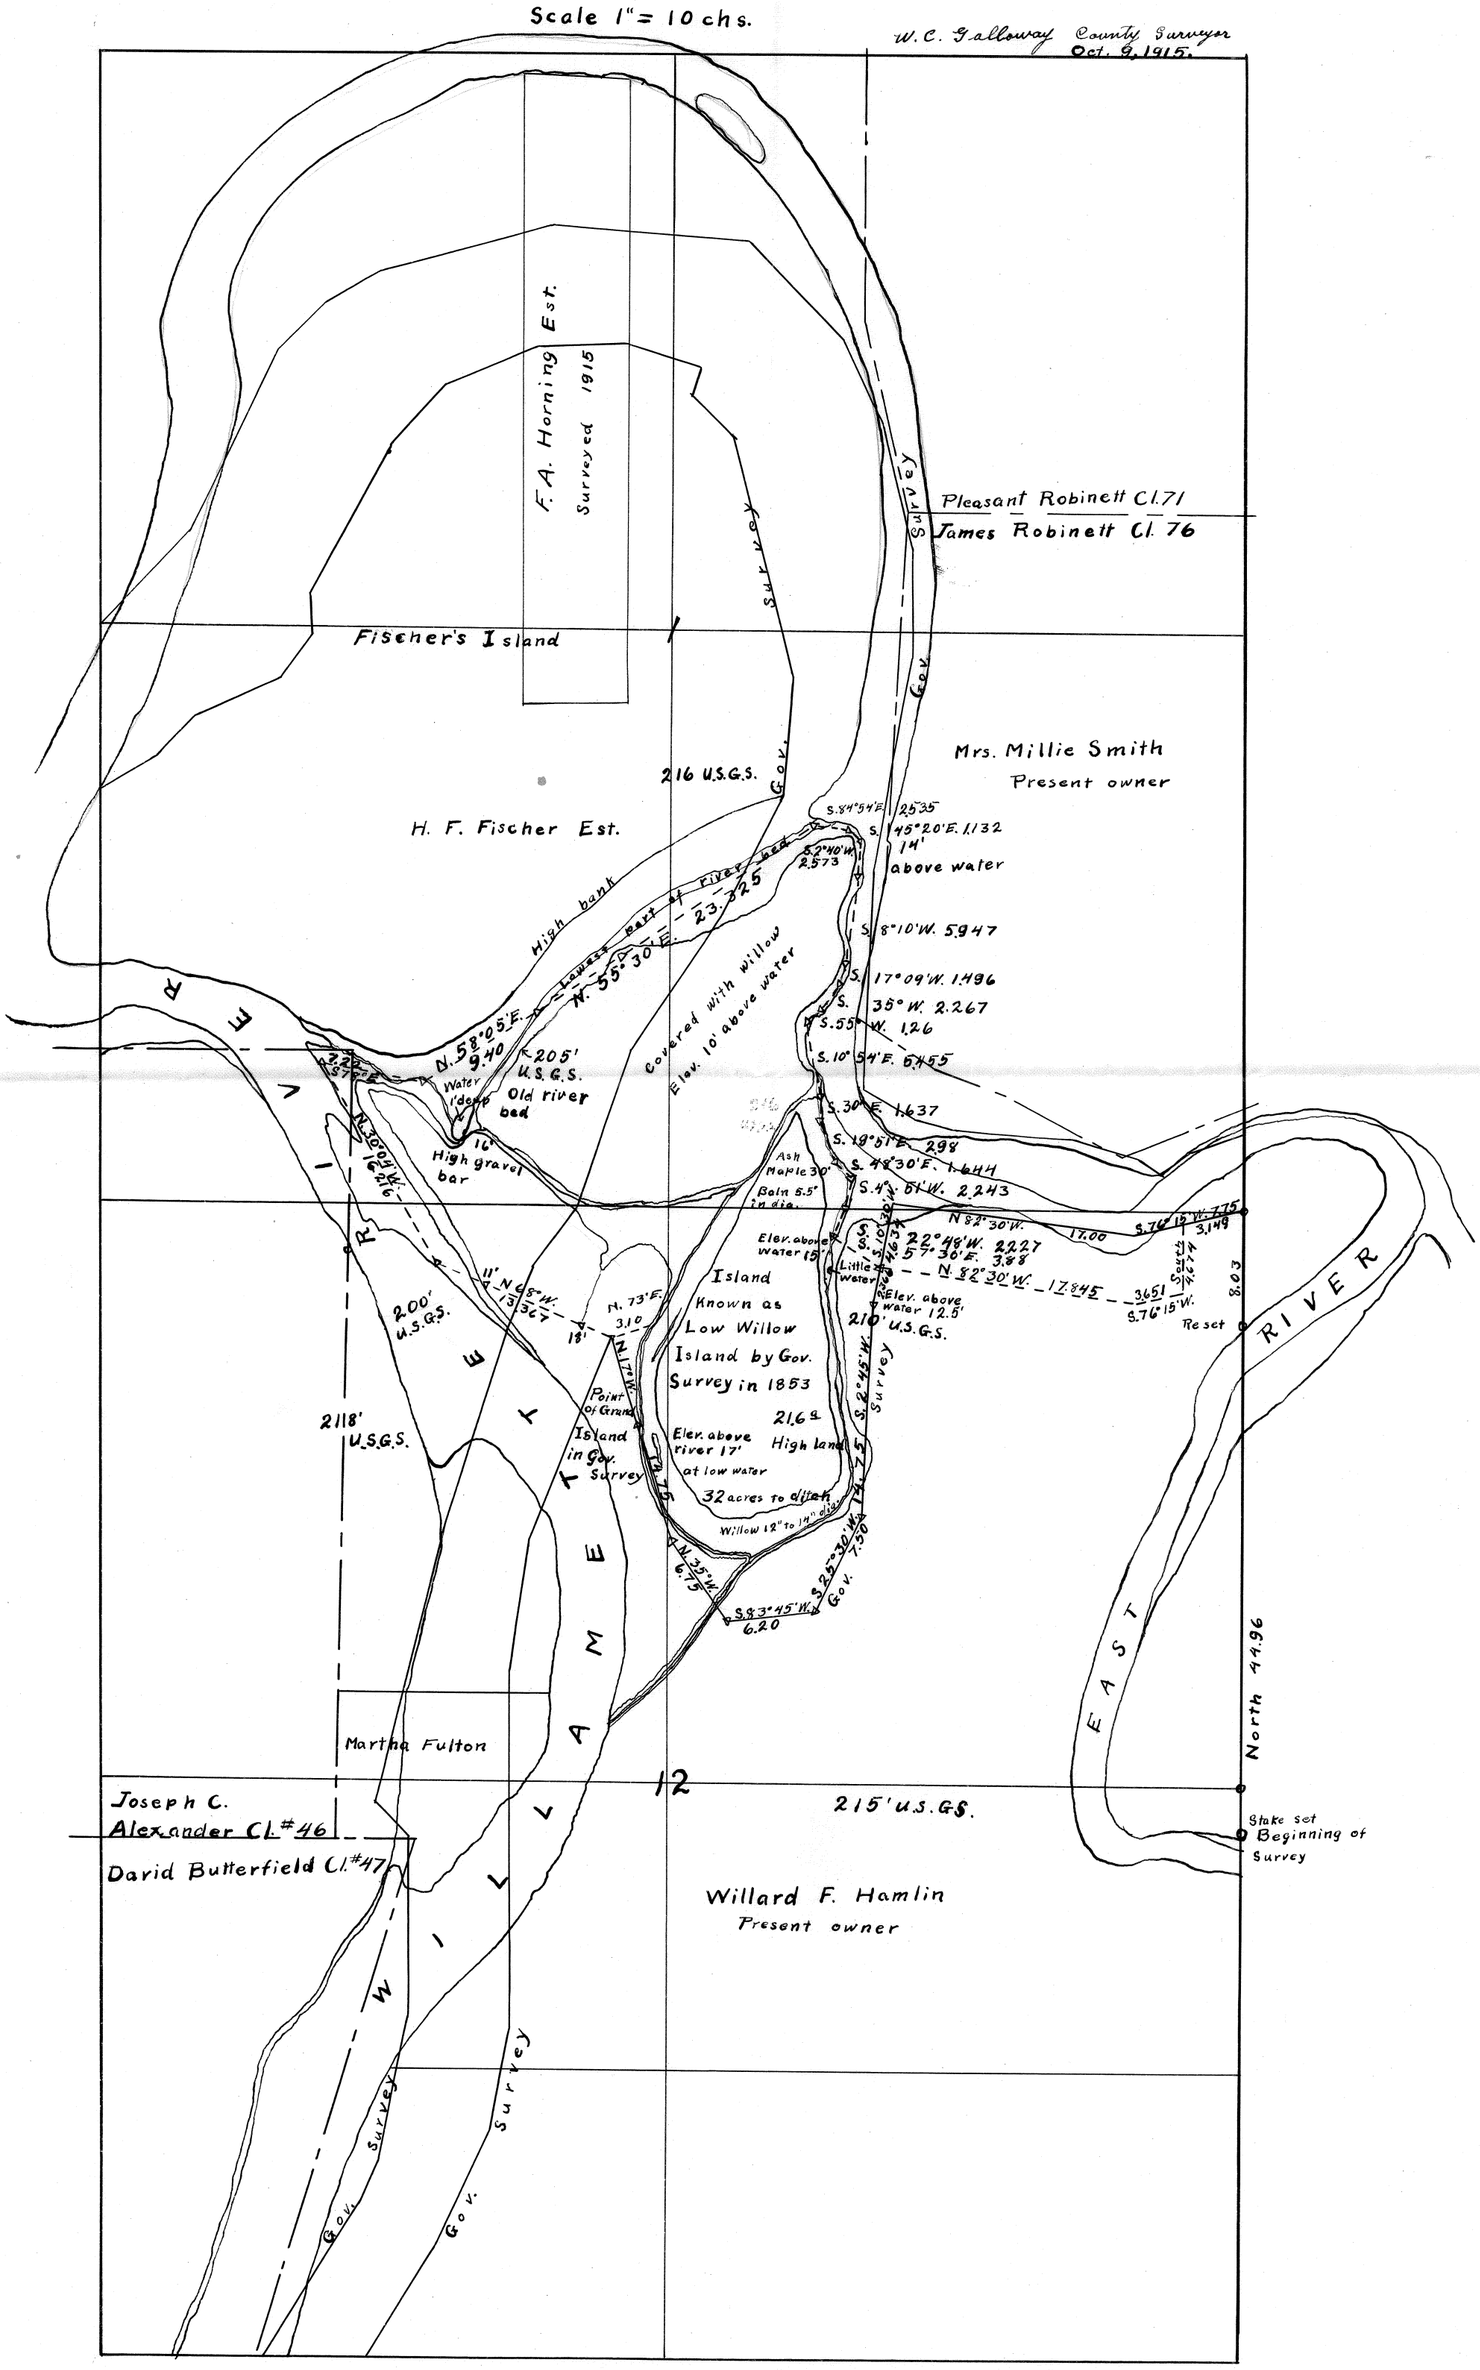

30

#529

F/B 20, Pg. 30-32

Sept. 1915.

C.S. #244 For B.L. VanHoosen

C.S. 529

T. 12 S. R. 5 W.

Beg. at meander cor. on N. bnk. of E. river on Tp. line just S. of ¼ Sec. cor. between 7 & 12

1	N 0° 03' E. correction W. 3'		8.043	- 440 ash 12"
2	∠ Right 7'		5.373	offset .011 E.
3			3.956	
4	∠ Left 8°		7.287	
5			4.582	offset .028 W.
6		3° 45'	2.298	
			5.443	
			-.228	

Rec't.

Striking East of cor. .011

Nail in root

Ash stump 20" S. 42½° W. .47

" 6" N. 43° E. .75 Std. remkd

Mkd. " Ash 10" N 8° W. .195

7 N. 003 E correction W. 3' ∠ Left 1° 10' 7.979 offset .162 W.

Set -.177

" E. .156

8	S. 76° 15' W.	4.149	+ 2.0 bnk
9	South	4.674	
10	S. 76° 15' W.	3.651	
11	N. 82° 30' W.	7.989	
12		5.974	
13		3.882	+1.25 bnk. +3.47 To water +3.70 cen.

+ or.

8.043
5.373
3.956
7.287
4.582 + +
29.241
2.298
5.443
36.982
7.979
44.961

.228
7.979
8.207
5.03
.177

7.979
5.974
13.963

17.000
13.963
3.037
.852
3.889
7.000
4.634
2.366

5373 11.869
.402 .332
10746 23738
2 14 3560
.010960 356
.027654
.000275=3'

36.983
.228
36.755

.011 E.
.028 W.
.017 W.
.011 W. 4603
.028" .84
5443

7.979 7.979
6302 5586.3
15958 4787
239 4606.46
4706
.12244

162
005
.157

780
4.149
3.651

4674
42281
4674
37391
93
1
.8516

4637
2.955
1.679

344
93
369

7.989
5.974
3.882
17.845

31				
14	N. 10° 30' E.		2955	
15			1.679	
*	Back to Δ 13			
16	S. 10° 30' W.		2,366	
17	S. 2° 45' W.		5.819	- 2.1 H con.
18			3819	
19			2.554	.80 cen. water
20			2.558	+1.62 con. +1.50 rt.
21	S. 2.5° 30' W.		7.50	1.90 mouth of slough offset
22	S. 84° 22' W.		6.20	N. 067
23	N. 35° 16' W.		6.75	+1.40 cen. Gravel bar
24	N 17° W.		8.710	
25			.505	E. 1.40 low E. 1.15 lowest
26			5.535	
	Alder 12" N 41° 30' E. .063			
	Ash 14" S. 77° 30' E. .387			
	" 14" S. 8° E. .345			
27	N. 73° E.		2,606	
			+50	low ground
	Back to Δ 26			
28	N. 68° W.		2,253	
29			7.373	bn R. 11'
30		2° 40'	3.745	-.50 +3'
31	N. 30° 4' W.		16.216	at 9.60 rt.
				-3.50 rt. gr.
				+1.5 rt. W.

6.20

6.200
6701
6200
434
37
.0671

3.45 N. to W. bk. R.
1.55 E. bnk East
2.00 lowest

Island 1.4' above river

N. 68° W.

N. 48° W. 3.0 wide
N. 39° W. 4.3 Pt. Gravel
N. 59° W. 5.5 " "

at Δ 2.5 wide gravel bar.
water .30 N.
over 1.5 W. notches W. 30 S.
water .10 wide 1.00 long

slough 12.75 S to slough + 50 for cen.

14.750
12.192
2.558

11.750
9.215
5.535

6.00
3.86
2.14

2.955
1.679
4.634
2.366
7.000

5.819
3.819
2.554
12.192
2.558
14.750

8.710
.505
9.215
5.535
14.750

2.253
7.373
3.741 *
13.367 *

N. 40° W. 9.50

32

32	S. 78° E.		7.320	
33	N. 58° 5' E.		9.402	low pt.
34	N 55° 31' E.		7.134	
35			16.011	
36	S. 84° 54' E.		2.535	
37	S. 45° 20' E.		1.132	
38	S. 2° 41' W.		2.573	
39	S. 8° 1' W.		5.947	Water
40	S. 17° 9' W.		1.496	1.20 ridge
41	S. 35° 1' W.		2.167	"
42	S. 55° W.		1.260	
43	S 10° 54' E.		5.455	
44	S. 30° E.		1.637	
45	S. 19° 51' E.		2.979	
46	S. 48° 30' E.		1.644	
47	S. 4° 51' W.		2.243	
48	S. 22° 48' W.		2.227	
49	S. 57° 40' E.	3° 5'	3.864	

S. 26° 30' E. 5.00 Pt. pot hole
N. 87° E. 4.75 lowest pt.
S. 50° E. 5.00 pt. of d'fcy

7.314
16.011
23.325

East to pt. on E. bank.
N. 42° 31' E. opposite pt. on river E. bank.
Jogs W. 50 of line

8.00
6.74
1.26

1.85 N. 64° 40' W.

+ 10 7.50 & 8.30 to low ground.

S. 10° 21' W.
E. bank 12.5'
W. bank 15.2'

from D 27 7.50
N. 11° 30' E. 8.0 circle N. 32° 30' E. 3.
N. 10° W. 3.00
N. 25° W. 2.00
N. 75° W.

N. 74° W. 8.0

N. 48° W. 2.00

N. 45° W. 8.0 + 30
Strike 150 N. South of