C.S. # 532

See notes in file

F.B. 20-42

42 #532 FB#20

Cont. of C.S. # 76 For E.E.

0 Beg. at stone S.W. cor. of T.M. Reed D.L.C.

	N 0° 11' E.		
1	correction W. 20		8.000
	N. 9' W.		
2		3° 10'	5.237
	Run on to cor.		
	Struck E. of cor.		.133
1	Back to 8.00 chs. N. of Beg.		
3 Ths.	N. 0° 9' W.		4.180
	Set 1" pipe in ccd road		
4	N. 17° 47' E.		5.160
	Back to 0		
5	East		10.318 Stone
6	To W. line of R.R.		.580 3/4" Pipe
7	N 39° 47' E.		7.934
	N. 59° 12' W.	2° 15'	8.000.
		1° 35'	8.000
			1.558
			.007

Permit

N. 11° E. 23.013

.00578 = 20'
.133000
115065
179450
161091
183590

East
10.318
.44
10.758

13.230
675
66150
9261
1008
56469

13.230
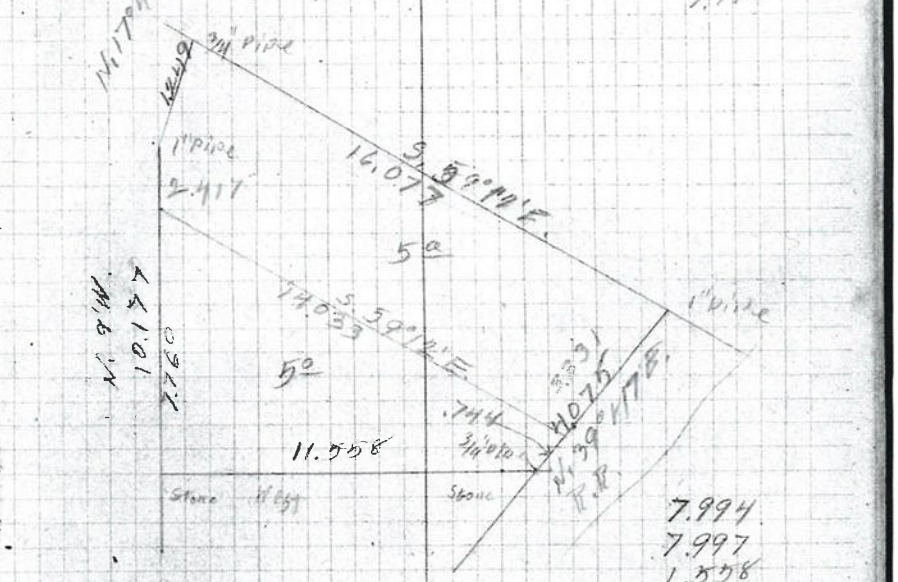
7.999
7.996