C.S. # 533

See notes in file

F.B. 20-43

H3 #533 FB#20

C.S. Road #370 T11S. R6W.
in sec. 19

Beg. at a n binder iron
From which Apple 5" N. 59°30' W. .548
Apple tree 7 S. 0° 50' E. 2.070

E. line of Road	S 5° 30' W.			1.10 +0'
1	N 18° 36' E.	+3°59' = 1.69' 4°5'	3.529	+1.7' -2.5'
2		+1°3' = 5.2'	4.276	
3		-2.5'	7.866	
4	Not in Tot a	-3.7'	2.621	
5	N. 3702' E.	+10.8 ft.	4.589	
6		+4.1' ft.	7.997	
7	N. 0° 20' W.	+3.7'	1.685	
8		+33'	5.222	
9	N 13° 30' E.	+1°13'	8.773	
10	N. 3° 33' W	+3.6'	1.622	
11		+1°24'	7.279	-1.02 1.54' below grade
12	N. 12° 21' E.	+35' for 8.00 +41'	13.236	
13	N. 15° 18' E.	+1°5' +1°17' + thru +5' P.30'	8.000 2.928	-4.50 -.70 W.F.
14		-1.5'	1.735	+1.2 1.12 -.25 -1.2 CU
15	N. 32° 29' E.	+1°6'	9.273	45° -3.75 +1.37 water
16	N 14° 42' E.	+1°20' +1°27' +1°40'	8.000 4.494	-3.0 -1.2 -1.50 +11.5' +1.5 on ground
17	Oak 30" S. 2°30' E. 1.334 Chs.			

See page 61 for change of this part

For W.E. Rosecrans

From Δ 4 L.F. Wilsons Fork of road on
N. 66° 45' W. +3°3' 8.000
3.50' 8.000 = 18.258
+3.5' 1.585
-1.5' .701 tickets off
N. 0°06'E. 4°30' 3.544 = 3.553
Oak 9" N. 0°37'E. 3°45' 3.478

+1.0 -2'
+2.34 +0'

-3.597 to Reads line

4.588	15.661		3.520
7.997	2.627		4.275
12.585	13.034		7.866
3.578			15.661
9.007	1.685		12.585
15.661	5.221		6.906
24.668 Wilsons	6.906		8.771
			8.899
1.622	7.999		13.236
7.277	2.927		12.663
8.899	1.735		78.721
	12.663		9.271
7.998			12.490
4.492			100.182
12.490			

Page 1 Chains

Iron
S. 44° E. 7.00 N. 38° 15' W. 1.0
12.490

N. 46° 11' W. 2.534 -1.46'
to 11/12

	N. 1°40 W.	+1°2' = 9.5 +1°6' = 12.4	8.250		
17			1.639	−6.70 10"cols.	
Face	Ash Stump 18"	S. 32°	W. .606		
"	Maple " 18"	S. 85°10'	W. .830		
18	N. 17° 15' E.	+1°36' =	10.350	+.38 −12 cols.	
19		−.9'	1.182	+3.30 N. crack 8' wide 40'	+45' to creek
20	N. 12°52' W.	+1°35'	7.870		
21	N 23°25' E.	+3°30'	5.001		
	21°07'	2°50'		−20 cols.	
22	N 19° 16' E.	+3°36'	6.186	+5.10 4" cols.	
23	N 38°37' E.	+3°36'	7.488	+4.50 −2.5 grade 3.8 5 grade	−3.0 −2.5 grade −2.6 grade −1.3 −1' cols. grade −1.7 grade −.80 +2.5 grade −4.0 +2.5 grade
24	N. 26° 51' E.	+3°36' 2°15'	2.410		
19		+2°2' = 17'	7.238		
Fir 14"	N. 79°15' W. .374 cds.				
20	N. 41° 10' E.	+3°10'	2.600		
21	N. 16° 23. 14 E.	+2°22'.6	1.404	Set N.W. 072	
22	N. E.	+3° = 15.2'	4.402	−.45 −5' cols. 9'	
23	N 43° 24' E.	+3°38'	4.160		
24	N. 36° 46' E.	+2°18'	2.178		
25	N. 46° 16' E.	+2°47'	1.637		
26	N 26°30' E.	+3°4'	3.226		
27	N. 43° 54' E.	+3°8'	7.070		
28	N 9° E.	+3°16'	1.967	+.40 ditch	
29	N. 49° 30' E.	+3°11'	2.773		
30	N. 31°08' E.	+3°5'	1.674		
2 M. Std. stake		3°10'	+.629		
Fir 9"	S. 62°30' E. .347 cds.			Nail in 34" stump N 10°30' W. .102	
" 6"	S. 7°30' E. .727 "				

Westedge of Witness Oak for back sight

1.238
5.9 E)
1.257

10.344
7.233
17.577

1403
4.396
5.799

1.395
1.401
5.799

100.482
9.638.
17.577.
2.598.
5.796.
2.757.
2.177.
1.637.
3.221.
7.059
1.966.
2.770.
1.693 ?
159.371 ?

Reset

18/17 Set 2" Pipe 1" long glass
Witness N. 12° W. 40 log on S.E. end 4.0 high
Oak 7 N. 9°54' E. 5.105 cds. Maple
Fir 16 N. 67°10' W. 7.347 − 7°30'

S. 0°51' W.
correction W. 18'
(S. 1°09' W.)

	7.173	7.173
5°45'	5.673	5.617
6°45'	6.680	7.994
7°45'	7.680	7.996
8°30'	8.400	7.998
2°10	2.750	3.247
	−.965	
	.211	

change E to Left
Make N-Easting less

Make Reset 19/17 / 19/20

Striking E. of Oak
Set 2" x 28" Pipe & glass
Oak 36" S. 73°30' E. .44 Std.
30" N. 31°30' E. 2.556

S. 53° 30' E. 2.556
S. 31° 30' W. 4.41

3.256 .0053 = 18'

45

31	N 41° 34' E.	+3° 2'	3.534	7° 03'	
32	N 47° 37' E.	3° 3'	2.783	13° 46'	
33	N 61° 23' E.	+4° 15' 2° 33'	1.376	42° 13'	
34	S. 76° 18' E.	2° 10'	2.869	29° 25'	
35	N. 74° 17' E.	+3° 4'	2.187	17° 51'	
36	S. 87° 39' E.	2° 38' 1° 43'	1.762		
37	N. 63° 11' E.	+3° 12' 2° 16'	2.193	+.20	

S. 47° E. pipe

Mt. Ash 12" N. 40° E. 17 ± cks.

38	N 58° 48' W.	+2° 52' 2° 10'	3.697	Head of 34" S tulip pipe S 41° 26' W. 23 c
39	N. 40° 23' W.	+3° 24' 2° 24'	1.903	
40	N. 14° 46' E.	+3° 14'	1.038	
41	N. 41° 23' E.	+3° 16' 1° 20'	1.499	S 59° 25' E : .304 set leaf of spring
42	N. 39° 35' E.	+3° 16' 2° 0'	2.275	
43	N. 39° 10' E.	+3° 16' 2° 0'	2.541	
44	N. 24° 15' W.	+3° 16' 1° 15'	1.674	
45	N. 9° 54' W.	+2° 52' 1° 40'	1.359	
R.O.S.	S. 89° 16' E.	20° 44'	1.182	1.077

to ½ sec. cor. 8/17

Set 4"x4"x 36" Oak stake

Oak 8" North 2.11 cks. std.

Fir 14" S. 42½ W. .45 " "

S. 89° 48' E.

20° 44'

1.182

24° 12' = 24.2 diagl. 007

= N 74° 30' E.

15° 30

½ ½

17 1:1

S 59° 25' E

10' W. 1.671

1.359

1.447

Nail in root

1.359

159.371
3.529.
2.779.
1.375.
2.867.
2.184.
1.761.
2.192.
3.694.
1.901.
1.038.
1.499.
4.793.
1.674.
1.358. ø
192.015 ø

191.913
160.000
31.913

1.0770

19* Nov 1934

#15500

*61

Co. Rd # 15500

MAP
OF
ROAD No. 370
T. 11 S., R. 5 W., Will. Mer.
BENTON COUNTY, OREGON.

Width of road:- 40'

Scale 1 in = 10 chs Jan 19, 1916
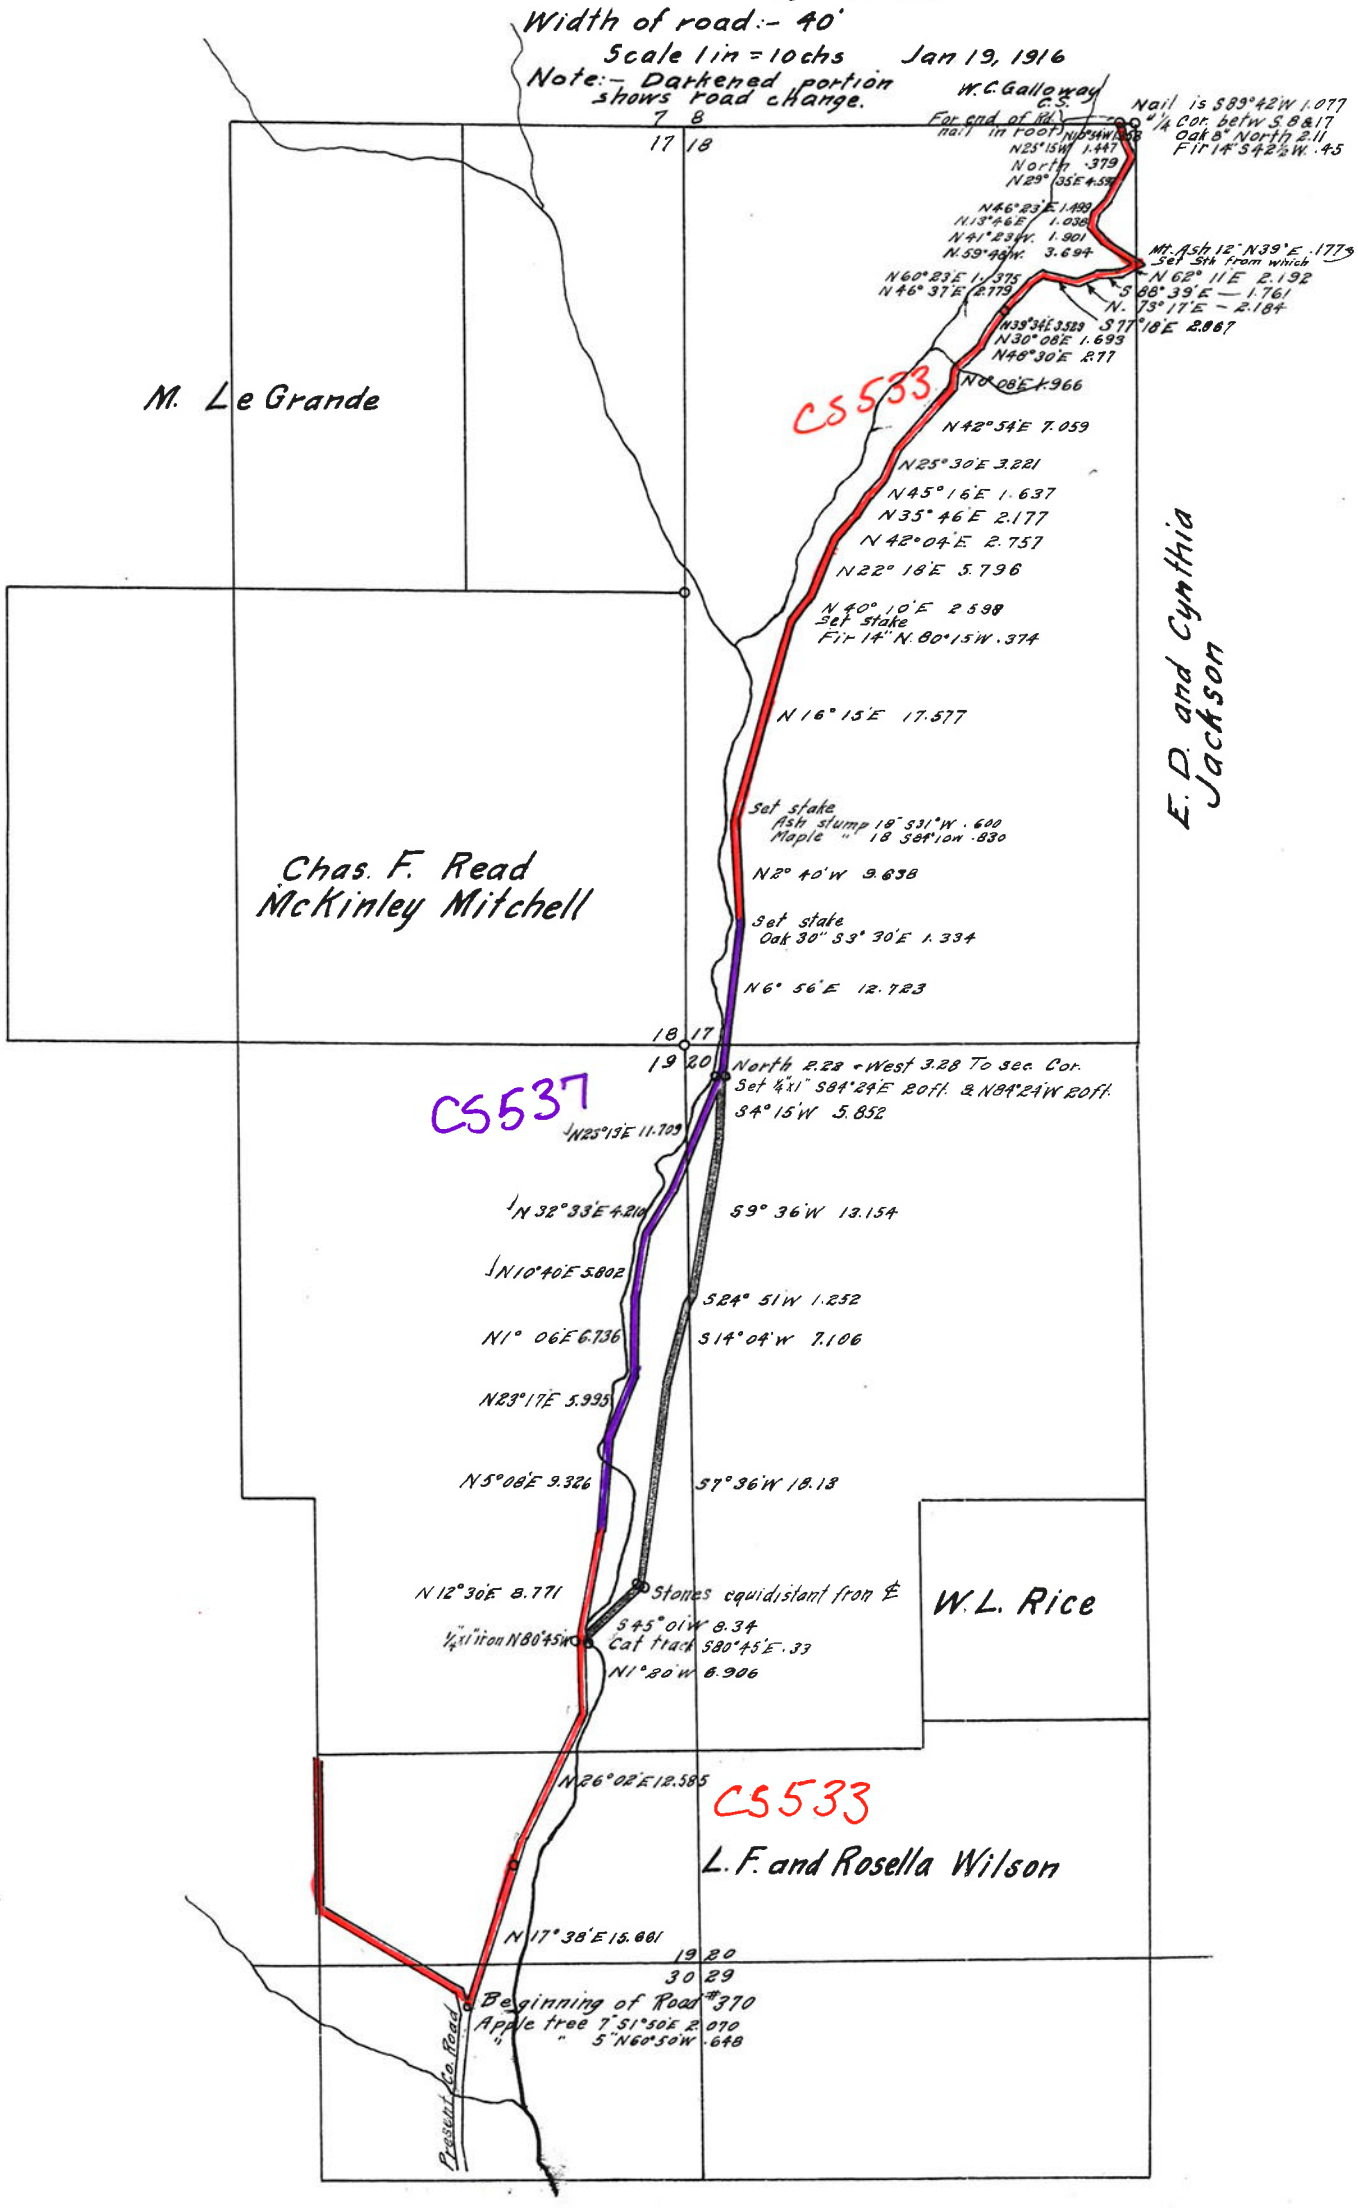
Note:- Darkened portion shows road change.