535

229

535

for
James E. Post
John Q Post
Annie L. Reynolds
J. G. Mustoe
Wm Oehman

No. 229 COUNTY SURVEY No. 247

535

T10S. R. 7 W. Will. Mer.

Scale 1" = 10 chs.

Feb. 7 – Mar. 5 – 1917
Burt Wilkes
Deputy Cs.

Dec. 20, 1915
W.C. Galloway, C.S.

for
Hiram Parker
James Stenbach

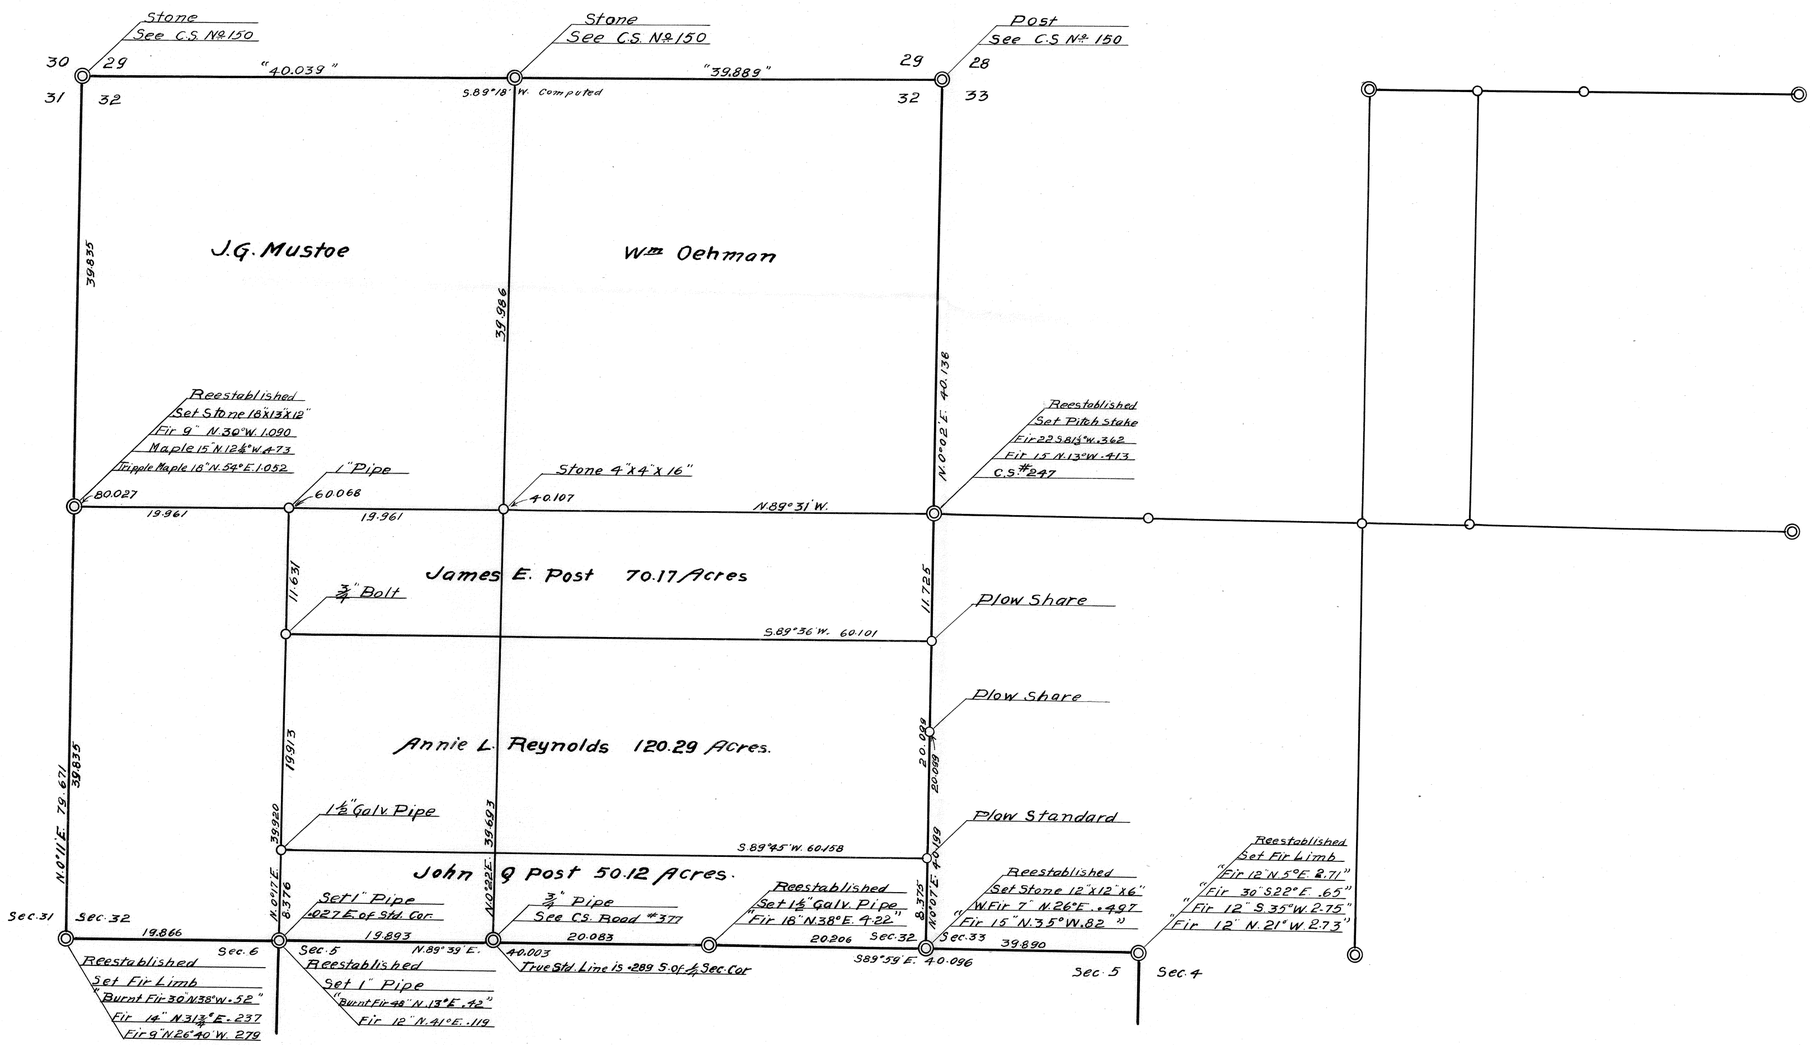

535

F/B 20, PG. 56-59
C.S. 535

56 #535

C.S. #247 For: Hiram Parker.

33|34 Set Qt. bottle
Maple 10" S. 66° E. .515 chs.
Rec's Fir 12" S 46° W. .542 chs.

T. 10 S. R 7 W.

1	West.		2.753	
2	no correction except .004 to N.	5°55'	5.095	
3	∠ Right 18'	5°10'	7.024	offset .037 N.
4		6°	5.322	-.125 S.036
5			4.556	
6			2.442	
7		1°30'	2.859	
			-.007	
			S.035	

Set Qt. bottle
Forked Maple 36" East +.053 from no. 4 on N. side
8 6.207
9 3.860
-.101
Can. Sec. 33 Qt. bottle S.035
Crabb appl. 55 15° W. 1.83 chs.
Ash 8" N. 79° W. 2.77 "

10	6.530
11	4.581
12	2.668
13	7.618
	-1.607
	S.034

Double
Set Qt. bottle Ash 34" S. 53°30' W. 1.43

Dec. 14, 1915.
James Stenback.
A.B. Weatherford
Fence N. & W.

.0024 N.
.0366

20.071
19.946
.125

29.927
6.207
3.860
39.994
.101

2|39.893
19.946

4|39.893
9.973
29.920

5.905
.625
6.530

6.207 + 3.860 = 10.067 + .101 = 9.966
9.973 − 9.966 = 0.007

2.753
5.029
6.996
5.293 ✓
20.071 ✓
4.556
2.442
2.858 ✓
29.927 ✓
6.207
4.485 ✓
40.619
5.905
4.581
2.668
7.618 ✓
61.391 ✓

57					
14				1.130	
15			12°36'	1.778	
16			9°35'	1.476	
17			6°9'	3.479	
18			2°30'	1.794	
19			1°	4.259	
20			6°50'	1.301	
21	L Left 35'		11°45'	3.231	offset .032 S.
To ¼ S. 32/33	(Dec. 15, 1915)				
Reset	Set a pitch stake 3"x4"				
	Fir 22" S. 81°30' W. .362 obs.				
	" 15" N. 13° W. .413 "				
	Back to △ 9				
22	South correction E. 14'			2.870	
23			2°25'	2.895	
~~24~~			1°10'	3.582	
24				.967	
25			8°45'	6.199	
~~26~~	L Right 19'		12°27'	4.363	
26			6°10'	1.576	offset .032 W.
27	L Left 21'		5°25'	3.471	offset .021 E.
28			3°10'	4.304	
29	L Right 55'		5°10'	2.432	offset .039 W.
30			4°5'	5.306	
31			11°30'	2.637	

1.778 1.476 3.231 3.163
29579 40689 50979 8101
16002 13284 29079 3163
1244 1180 2261 31
88 88 290 25
16 1 .03219
1.7350 1.4552 3.1631

6.199 4.363 79676
63889 84679 39.893
55791 39267 2|39.783
4959 3054 19.891
495 261
18 17
3 5
6.1266 4.2602

19.891
39.893
59.784

61.391
59.784
1.607

5828 3.459 2.422 2.637
355 116 0061 29979
29140 20754 2422 23733
2914 345 1453 1845
174 34 .03875 237
.03222 8.02113 23
25638

Offsets N. from S. of Sec. 33

.31 W.
.039 E.
.277 W.
.021 W.
.298 W.
.032 E.
.266 W.
10.067 E.
9.801 E.
.119 E.
9.920 E.
.084 W.
9.836 E.
10.165 W.
.329 W.

.00411 = 14'
80.135 | .329000
320540
846600
80135
44650

40.255
.338
39.917
40.215
40.132

61.391
1.130
1.735
1.455
3.460
1.792
4.258
1.292
3.163 &
79.676 &

2.870
.035
2.835
2.892
3.581
.967
6.127
4.260
1.568
3.459
4.298
2.422
5.293
2.584 2
40.286
.071
40.215

58				
	To 33 sec. cor.		-.071	Dec. 16,
	Rest. Striking W. of cor.		.316	
	Set cedar post 5"x4"x36"			
	Fir 20" N. 30° 30' E. .095			abs.
	Burnt " 30" S. 61°	E. .46	"	St.
	" 24" S. 16°	E. .137	"	
	Back to △ 7			
	North correction 13' W. 1°15'			
32			4.355	
33	Left 59'		7.014	offset .119 E.
			7.993	
			5.875	
			.367	
34				
35		31°	3.011	
36		16°26'	1.118	
37		12°55'	4.267	
38		4°25'	1.095	
39	Left 4°28	2°	1.087	offset .084 W.
40		14°40'	.657	
41		18°36'	4.215	
			-.239	
			W. 180	
	Set qt. bottle			
	Alder 16" N. 82°30' E.		.128	abs.
	Fir 32" S. 10°	30' W.	.354	"
42	West	6°20'	2.373	
43	Left 23'	12°20'	3.827	

5.77 H.T. .124

324	324	7.014	
6591½	.0577	.0071	
648	2916	7004	
32	226	4909	
29	16	.N913	
1			
.0710	.3159		

3011	1118	4267	.657	1095	
21706	5359	07479	24769		
24088	10062	38403	5913		
1505	559	2986	399		
210	100	170	45		
3	1	29	2		
2.5808	1.0722	4.1588	.6359		

1.084	4.215	3.827	
8877	77749	23679	
7588	37935	34443	
758	1686	2078	
86	295	227	
8	29	34	
	2		
.08440	3.9947	3.7387	

offsets
.007 W.
.119 E.
.112 E.
.084 W.
.028 E.
.180 W.
.152 W.

.00380 = 13'

40 | .152
120
320
320

.035	
4.354	
7.013	
7.993	
5.875	
.367	
.581	
1.072	
4.159	
1.092	
1.083	
.636	8
36.260	8
3.995	
40.255	
.239	
40.016	
2.358	
3.738	7
6.096	7

59

44 Reest.		15°53'	3.692	
			+.509	
To ¼ sec. cor. bet 28 & 33	striking N. of cor.		.338	Dec. 18
	Set 2 ft. bottle		Slag N. 48° E. 79	
Fir 34	S. 16°	E.	.540 clks.	
" 5'	S. 86° 30'	W.	.231 "	
Back to △ 41				
45	East			
45	∠ Left +33'	50'	7.146	offset .069 N.
46		4°30	2.005	
47			.902 +.240 5.210	
48		4°20'	1.219	
49		12°55'	1.089	
50		14°15'	4.107	+.18 "
51		1°05'	1.632	
52		2°30'	2.835	
53	∠ Left +33'	4°25'	4.922	offset .047 N.
54		1°20'	4.098	
26/27 Reest.	Striking N. of cor. .065			
33/34	set 3/4" rod 30" long			
B Fir 36"	S. 83°	E.	2.913	Dec. 18
B " 40"	N. 14° 30'	W.	1.25	
" " 48	N. 15°	E.	.55	
Stone 6"x6"x5"	South 20 ft.			
Fir 36"	S. 77° 25'	W.	2.51 clks.	
Set on fence line N. & S. also cen. road.				

S. 5° 22' W. 18.22' .644 to cor. from △ 44

3.692
7.469
33218
2215
147
3
2
3.5595

.6411
.60947
5796
257
57
.6110

.611
.06238
.4888
183
124
3
.5086

.611
.88395
3055
305
18
4
.3382

4107
32969
36963
2464
369
8
1
3.9805

4.914
569
44226
2948
.047174

10.165
9.985
.180

20.210
19.970
.240

13.474

6.096
3.560
.509
10.165
7.145
1.998
.902
1.215
1.061
3.981
1.631
2.832
4.914
4.027

4 | 39.941
9.985
29.956

7.145
.069
64305
4287
.068592

1.0612

offsets
.338 N.
.069 N.
.047 N.
.454 N.
.065 S.
.389 N.

39.94

.00974 = 33'
38900
35946
29540
27958
15820

2 | 39.941
19770