C.S. # 561

Hardcopy 13-6 # 9

also see notes in file

F.B. 19-39

F/B 19, P6 39

39 Cont. 208

Correct E.31' = N.6°22' E. #561

Cont. 208 — For Pete Rickard — W. W. Wilker

Cat: Cl. — N. 0°51' E. — ∠ R. 1°50'

① 4.055 − 4.026

② 3.526 − 6° 3.805 — 7.826 — ∠ R. 4°45' = R. 4.25

③ 5.690 − 8½° 5.614 — 13.440 — ∠ L. 4°25' = 0

③ 2.967 − 2° 2.965 — 16.405 — △ Div. bet bottom & Hill long

④ 5.493 − 2° 5.490 — 21.897 — Jones W. 345 W. 406

18.930 = .282 — +.7093 Falls 4.303 E. Cl.

7.093

26.025

S. 66° 29' W.

13.259 — 7.461

14.202 — 7.461

Turn S. 0°51' W. ⊙ Near St.

+1.268 Webster

Set cor. S. 18.72'

S. 1°16' W. — 3096 to ¼ sec. cor.

S. 0°46' W — 4.502 +1°−.071 Cl. line

at 24.925 − .428 — at .289 on sec. line

Run S. 61°56' E. 5.00 + 2½°

5.00 + 2½° — 1.580

.689

5.00 + 1¾°

1.580

1.275 − 13°

Webster Set 5/8 X 1¾ X 36" bar

△ Road survey on N. & line

At ④ − .283 Set iron S. 66°29' W. 4.06

At ⑤ div. line bears S. 63°29' W. 19.275

S. 52°40' W 10.112 set iron (1.21 N. of Cl. line)

Set 5/8 X 1¾ X 36 bar iron cylinder bdry. at all cors.

Sun Cl. 12-6 Aug 16-16

1°30' — 85050 45" — 99997785

4.023 — 06045502 — 06045502

.1287 — 91095952 — 10604328 6

0°20' — 77047544

3.805 — 05803555

.02214 — 83451093

4°25' — 88766542 — 99987085

5631 — 07545864 — 07505864

.4336 — 96371280 — 10749299

.235 — 93765777

26.025 — 14153941 — 17' 12304449

0°31' — 79611885 — 99580381 17'

18.93 — 12771541 45°13' — 12724111

.1731 — 92383839 18.72 — 96224091

81804561

.1189 — 19075276

.2837

45°35' — 99594532

.4040 — 96063645 — 96145027

.1667 — 19221868

64 — 81804565

17' — 92304495

65'38 — 00405570

.2828 — 18.45142374

96155027

.1167 — 19.06192745

31 — 79611885

18.647 — 12706091

.1705 — 92317971

.370 — 95682027

99499452

.4062 — 96087720

96155027

.4676 — 19.24222

31 — 79611885

14.202 — 12149560

1.580 — 91761385

541

391

3096

284

2.812

4.501

1071

4.430

14.202

768

13.434

039

4.994

689

5.722

4.998

1.580

12.300

.541

.171

37°

.253

.168

.4351

66°29'

1.776

EC 1.3

18.647

1.3259

19.027

3096

4.501

7.597

~~951~~ 561

~~951~~ 561

208

Continuation
or
COUNTY SURVEY No. ~~951~~ 561 ~~208~~
IN
Wm. W. WILKERSON. D.L.C. No. 53, T. 13 S., R 6 W. - W.M.
made For
P. Rickard, R.M. Jones, - Wm Webster
Scale 1" = 2.00 Chs.
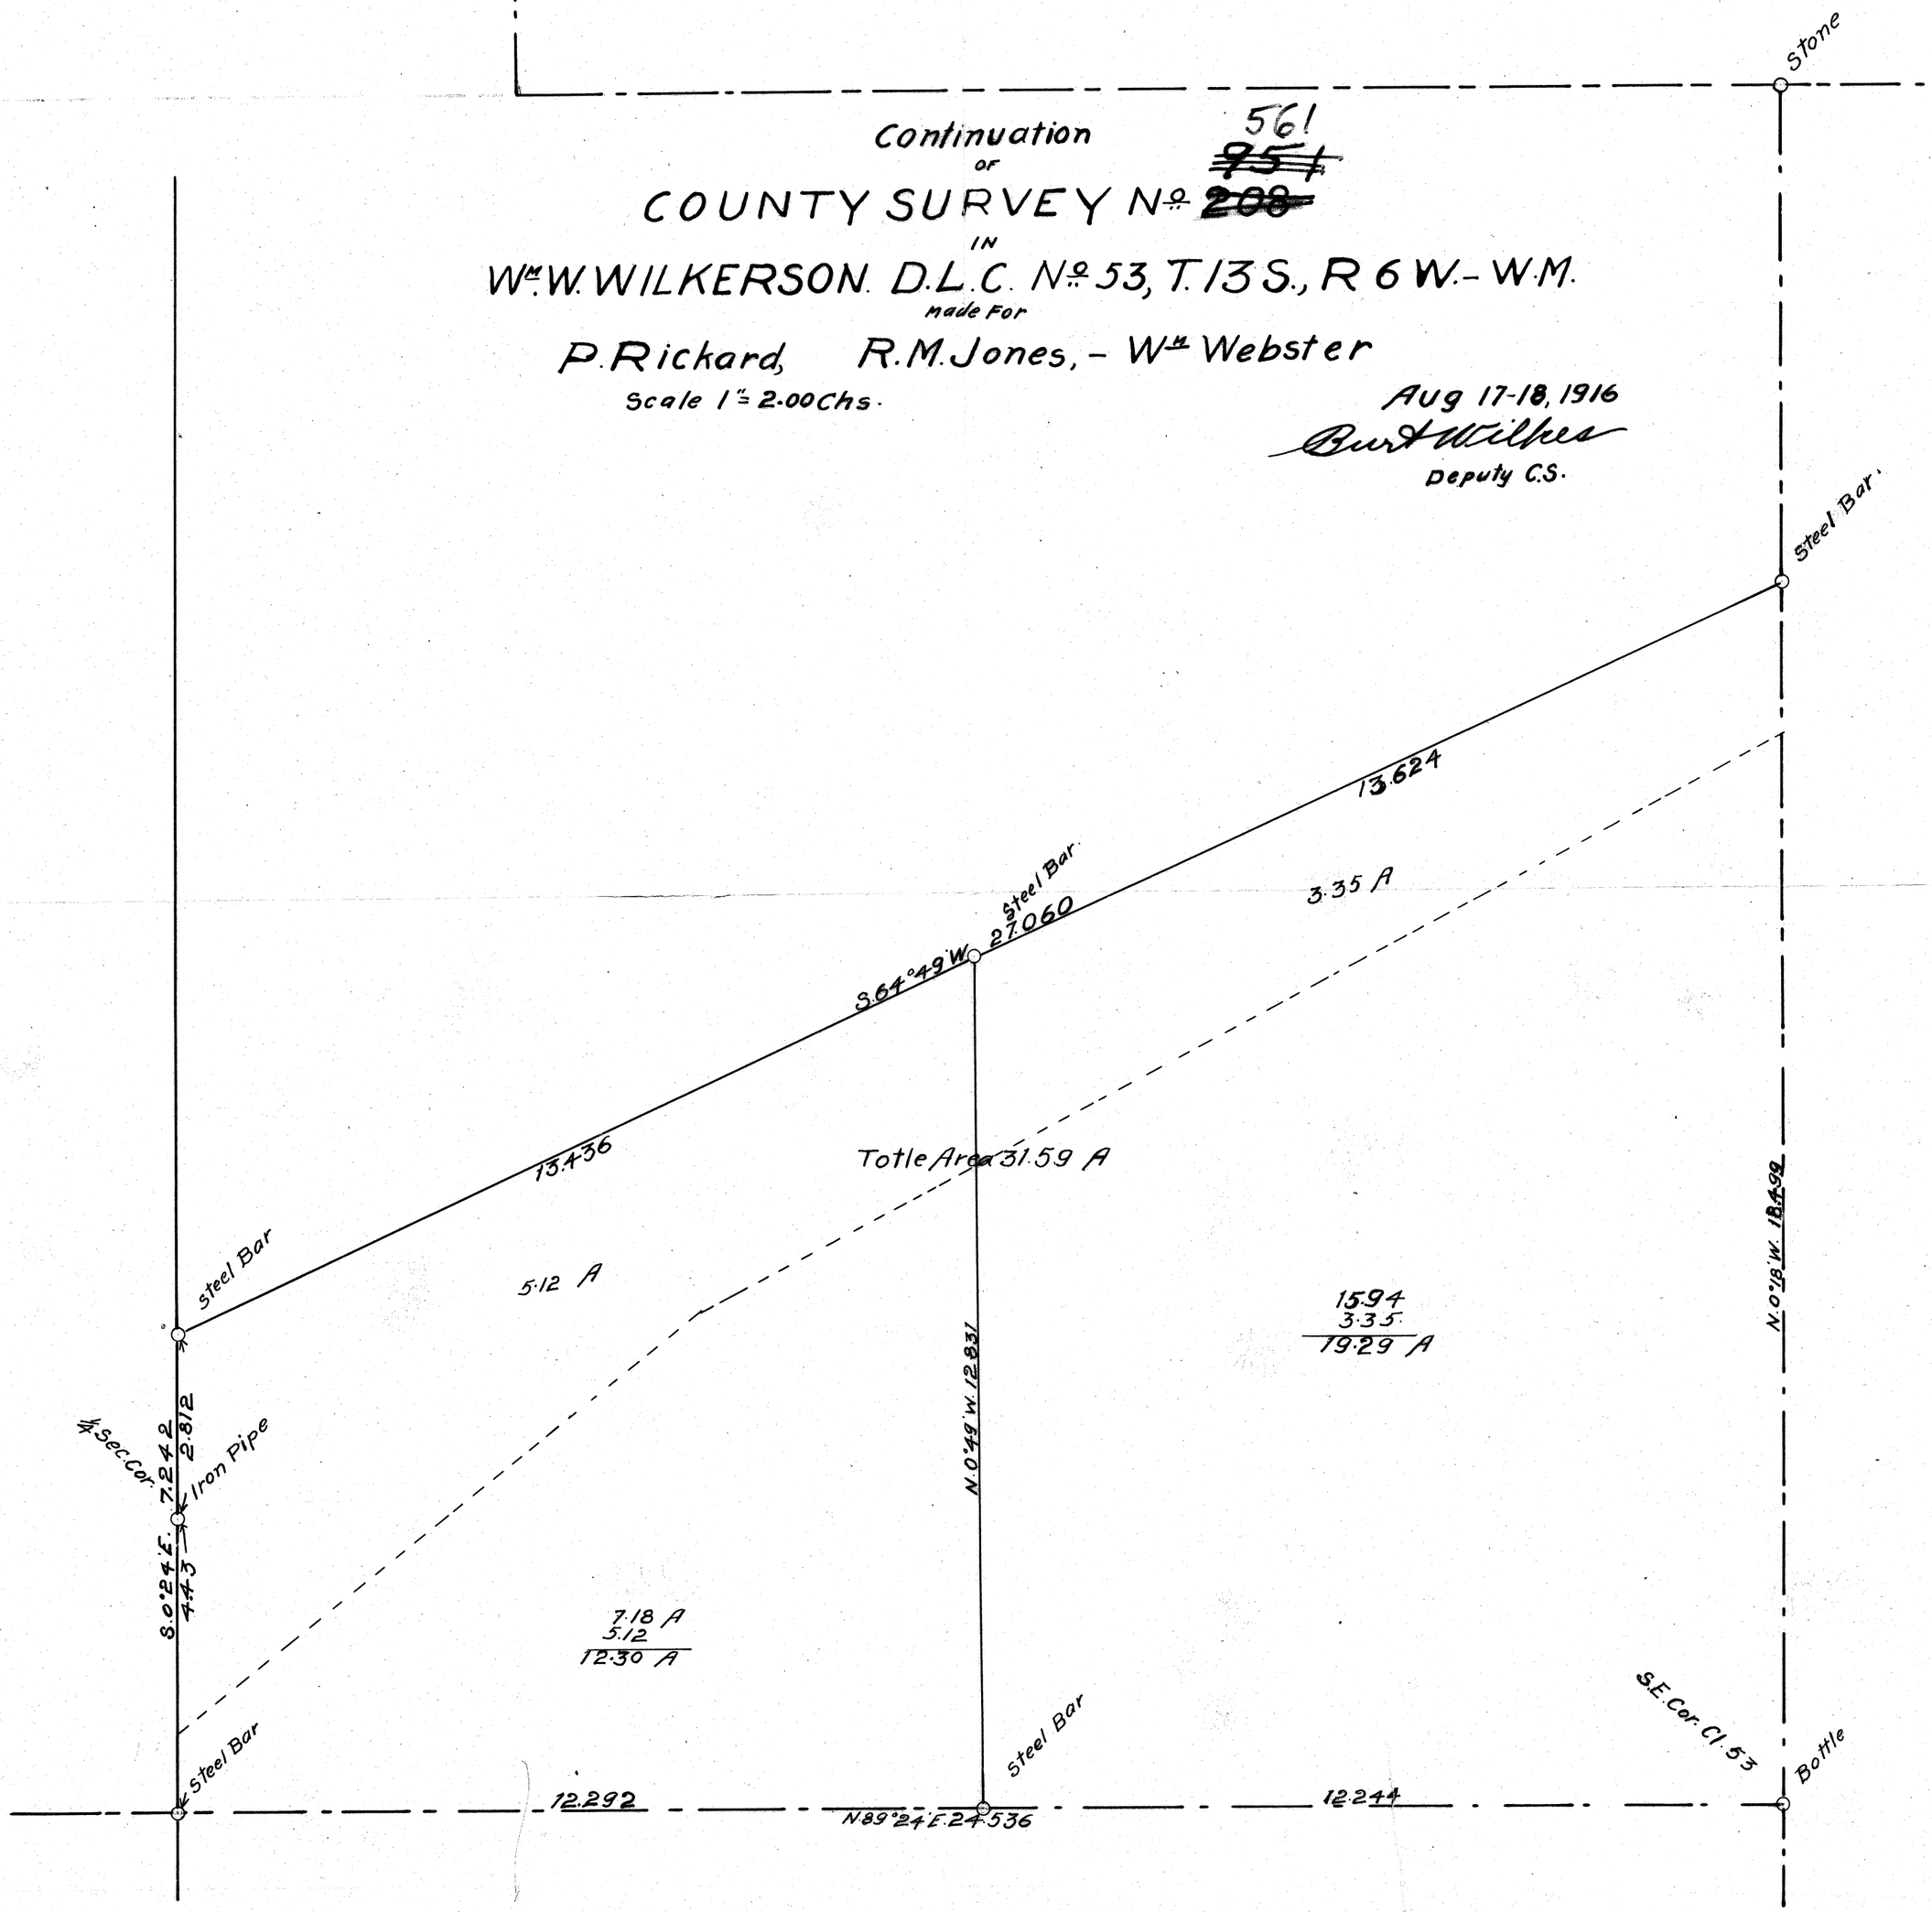
Aug 17-18, 1916
Burt Wilkes
Deputy C.S.