C.S. # 610

Hardcopy 10-4 #9

also see notes in file

F. B. 23-36

C.S. 610 / F.B. # 23, Pg. 36

#c10

36 Continuation of C.S. #192

Beg. at ¾" pipe incen. of road
S. 58°10'W. 16.22 & S. 5°32'50"E. .337
from S.W. cor. of 74.2 ± of Tomlinson
in Tolbert Carter's Cl. T.10-4
Thence N

1 N 5°50'W. - 55' 15.334
+1.106 = 16.438

2 7.254

22.249
.337
22586
15332
5.034
4.400
.634
.624
.010

7.254
+ .337
.015

337
425
1685
67
13
.001765

15.332
.337
14.995

16.101
14.995
1.106

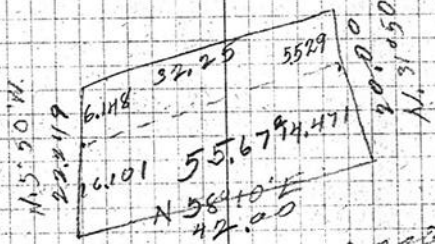

22.249
16.101
6.148

20.000
14.471
5.529