C.S. # 613

See notes in file

F.B. 23-39

C.S. 613 F/B # 23, Pg. 39

39 #613

Nov. 13, 1917.

C.S. 211 1 acre for County

At Irish Bend Ferry

Beg. at ½" pipe set for end of Road #277 Bng. taken from trees

Maple 24" S. 79° W. 166.1'

" 20" N. 74°45' W. 20.52' or 3.11
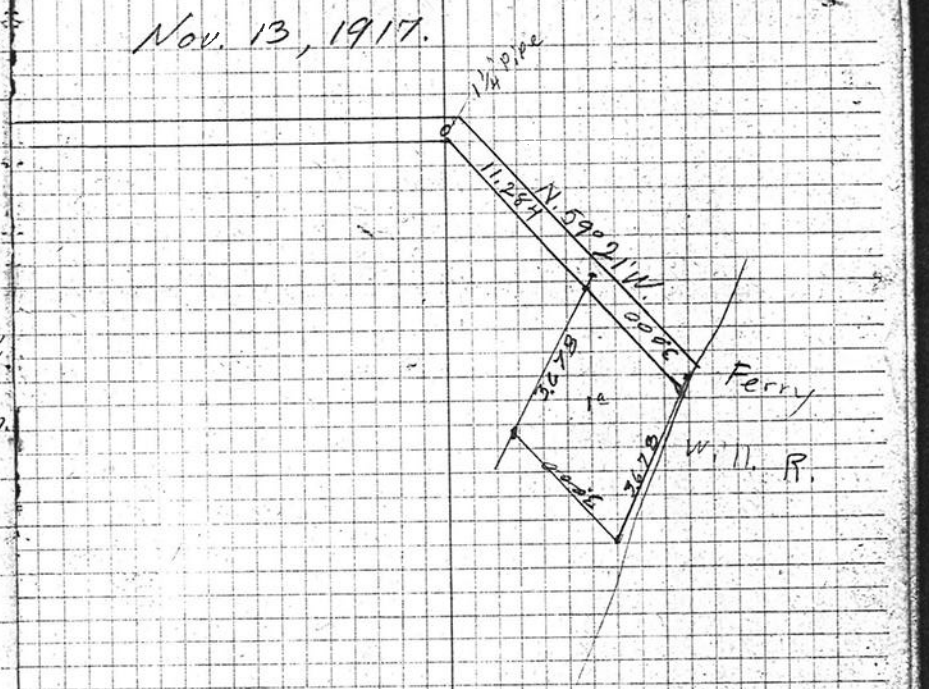
N. 8° 20' E.	2.036	A △ S. 32°04' W. .063
To a 3/4" x 26" I rod. set to be cen. of road		
N 59° 21' W. along cen of road	3.000	stake
S. 5° 39' W.	3.678	
N. 59° 21' W.	11.284	To 1¼" pipe
S. 89° 15' W.		along cen. of road