627

627

COUNTY SURVEY #~~269~~ 627

Drury R. Hodges D.L.C. 48

T.10S. R.4 W. W.M.

Scale 1" = 6 chs. March 18, 1918

W. C. Galloway

627

Made For:

R.J. Bailey & Sons
Mrs. J.H. Stewart
Gerald Stone

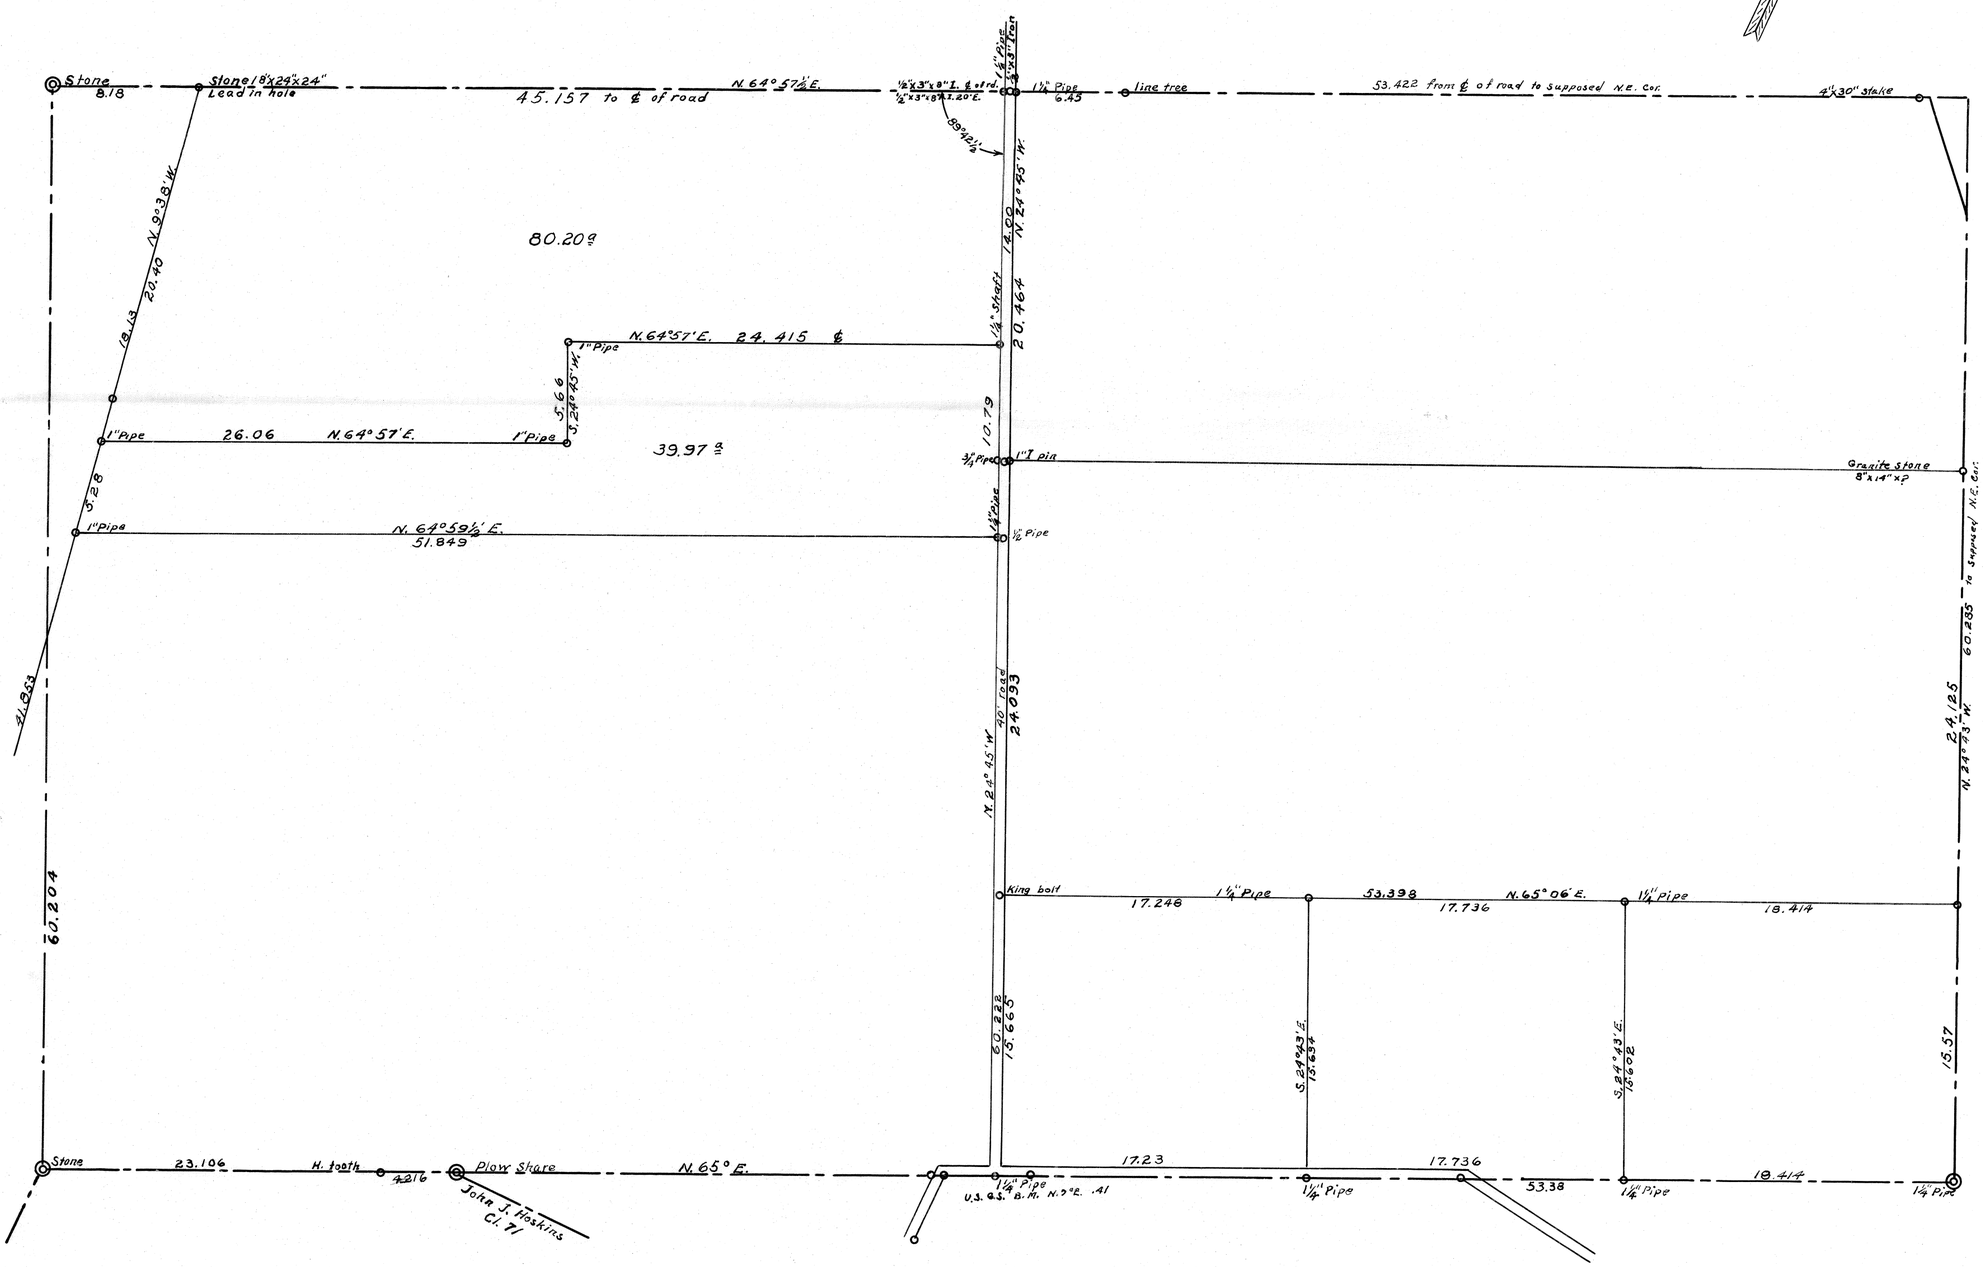

F/B 23, PG. 62-64

C.S. 627

#627 T. 10-4

62 C.S. 269 For R. J. Bailey & Sons.

Beg. at a ½"x3'x8" iron which I set in line by lining cen. of road and .2 of a link W. of a stake on N. line of D. R. Hodges Cl. #48 To ¾" I pin Ridders S.W.

1	S. 24° 45' E.		20.464	
			13.507	
		+5°15'	7.116	
2		+1°	6.488	To King bolt
		+1°15'	8.000	
3		+1°45'	7.671	To line
	U.S.G.S. B.M.			
	N. 7° E.	.040	chs.	
4 set	N. 25°08' W.		.321	
Thence	N. 65°06' E.			
	correction N. 6'-1°5'		17.134	
5	(N. 65° E.)		+.095	
			S. .292	
	Set 1¼" pipe			
		-1°40'	8.000	
			.956	
6			-.113	West .038 = 151
			.301	S. 277

Striking N. of ½" pipe

Set pipe N. W. .044

March 12, 1918.

13.507
4.099
6.487
24.093

7.994
7.667
15.665

24.093
15.665
39.758

20.464
24.093
15.665
60.222

7.718
.037
7.681

7.718
.368
7.350
.321
7.671

17.134
28999
154.206
15420
1542
137
3
17.1308

7.996
.956
8.952

17.131
8.952
26.083
.113
25.970
.038
25.932

.368
.321
.047
.718
.047
.671

53.376
.00167 = 6'-
.089000
53376
356240
320256
359840

17.226
17.131
.095

Offsets

.321 N.
.071 N.
.392 N.
.303 S.
.089 N.

.321 S.
.029
.292 S.
.015 N.
.277 S.
.015 N.
.262 S.
.071 S.
.333 S.
.010 N.
.323 S.
.020 N.
.303 S.

63

7 ∠ Left 27' −4°20' 3.449 offset .071
5.562
−.118
S. 333

8 6.147 (S. 323)
9 11.840 ∠ B. 44°22' .433
+.309
.303
18.296

Striking N. of cor.
Set 1¼" pipe

△ is N. .310
a N. .302

16 N. 24°44' W. 15.249
correction E. 3' + .019'
(N. 24°44' W.) E. .323

Set 1¼" pipe

11 15.612

12 ∠ Right 3°35½' 5.155 offset .323 E.
13 3.454
−.067

Striking W. of granit Stone 8"x14"x? .020
14 5.008
15 8.794

To △ with Tack 16 ∠ Left 26°50' +55' 6.788 offset 3.064 W.
Tall Stake ∠ Right 29°10' −15°22' .790 offset .371 E.

3435 .00785
5.562 9
9.001 .07065
8.952
17.953

433
52996
2598
389
38
.3023

433
884 17
3031
43
17
3
.3094

17.949
18.296
36.245
36.150
.095

17.131
17.953
18.296
53.380

18.414
18.296
.118

.00083 = 3'
39.695 .0330000
317560
124400

offsets
None E. line
to a stone
.310 W.
.323 E.
.013 E.
.020 E.
.033 E

.310 E.
.013 E
.323 E
.020 E
.343 E.
.343 W.

15.551
.019
15.570

.302
15.249
15.551
15.612
5.145
3.454
39.762
5.008
8.794
53.564
6.056
.665
60.285

39.762
.067
39.695
15.570
24.125

6.787
041 54
27148
3393
67
27
3.0635

6.787
23298
54296
6108
135
20
6.0560

.790
5469
71 10
474
31
1
.76

.762
53784
3048
609
53
2
1
16.371

.762
12378
6096
533
22
1
6.652

3.024
3.271
24.093
24.037
.13 Dist. from N.E. cor. W. to Tall stake △ 17

64

18 Back to △ 10 Set N. .161'
.019
.142N.
S. 65°05W.
correction N. 1'-
.001
(S 65°05'W.)

7.710
19 1.723 (S. .152
S. .140
.016
20 8.196
+.462
S. .138 S. .152
.014
.01H

Set 1/4" pipe

8.000
21 +2°10' 5.155 (S. .115
S. .136
.009
22 -50' 5.278
-.231
S. .135 .142
.135
.007

Set 1/4" pipe

S(197)
23 9.409 (S. .134
.003
24 +7°20' 2.921 (S. .133)
25 4.711
Striking N. of cor. .133 S. 2°46'E.

offsets
.142 N.
.133 S.
.009 N.

53.39 17 = 1'-
.009000
5339
36610
37303

.142 S.
.002 N.
.140 S.
.002 N.
.138 S.
.002 N.
.136 S.
.001 N.
.135
.002
.133

8.000
5.152
5.277
18.429

9.409
2.897
4.711
17.017

17.248
17.017
.231

18.414
17.952
.462

36.381
36.150
.231

2.92
28194
262 89
262 26
29
23
28969

.323
7.710
1.723
8.196
17.952
8.000
5.152
5.277
36.381
9.409
2.897
4.711
53.398