640

640

COUNTY SURVEY No ~~265~~

Section 22 T. 11 S. R. 7 W.

Benton County, Oregon.

Scale 1" = 10 chs.

W. C. Galloway C.S.

June 15, 1935.

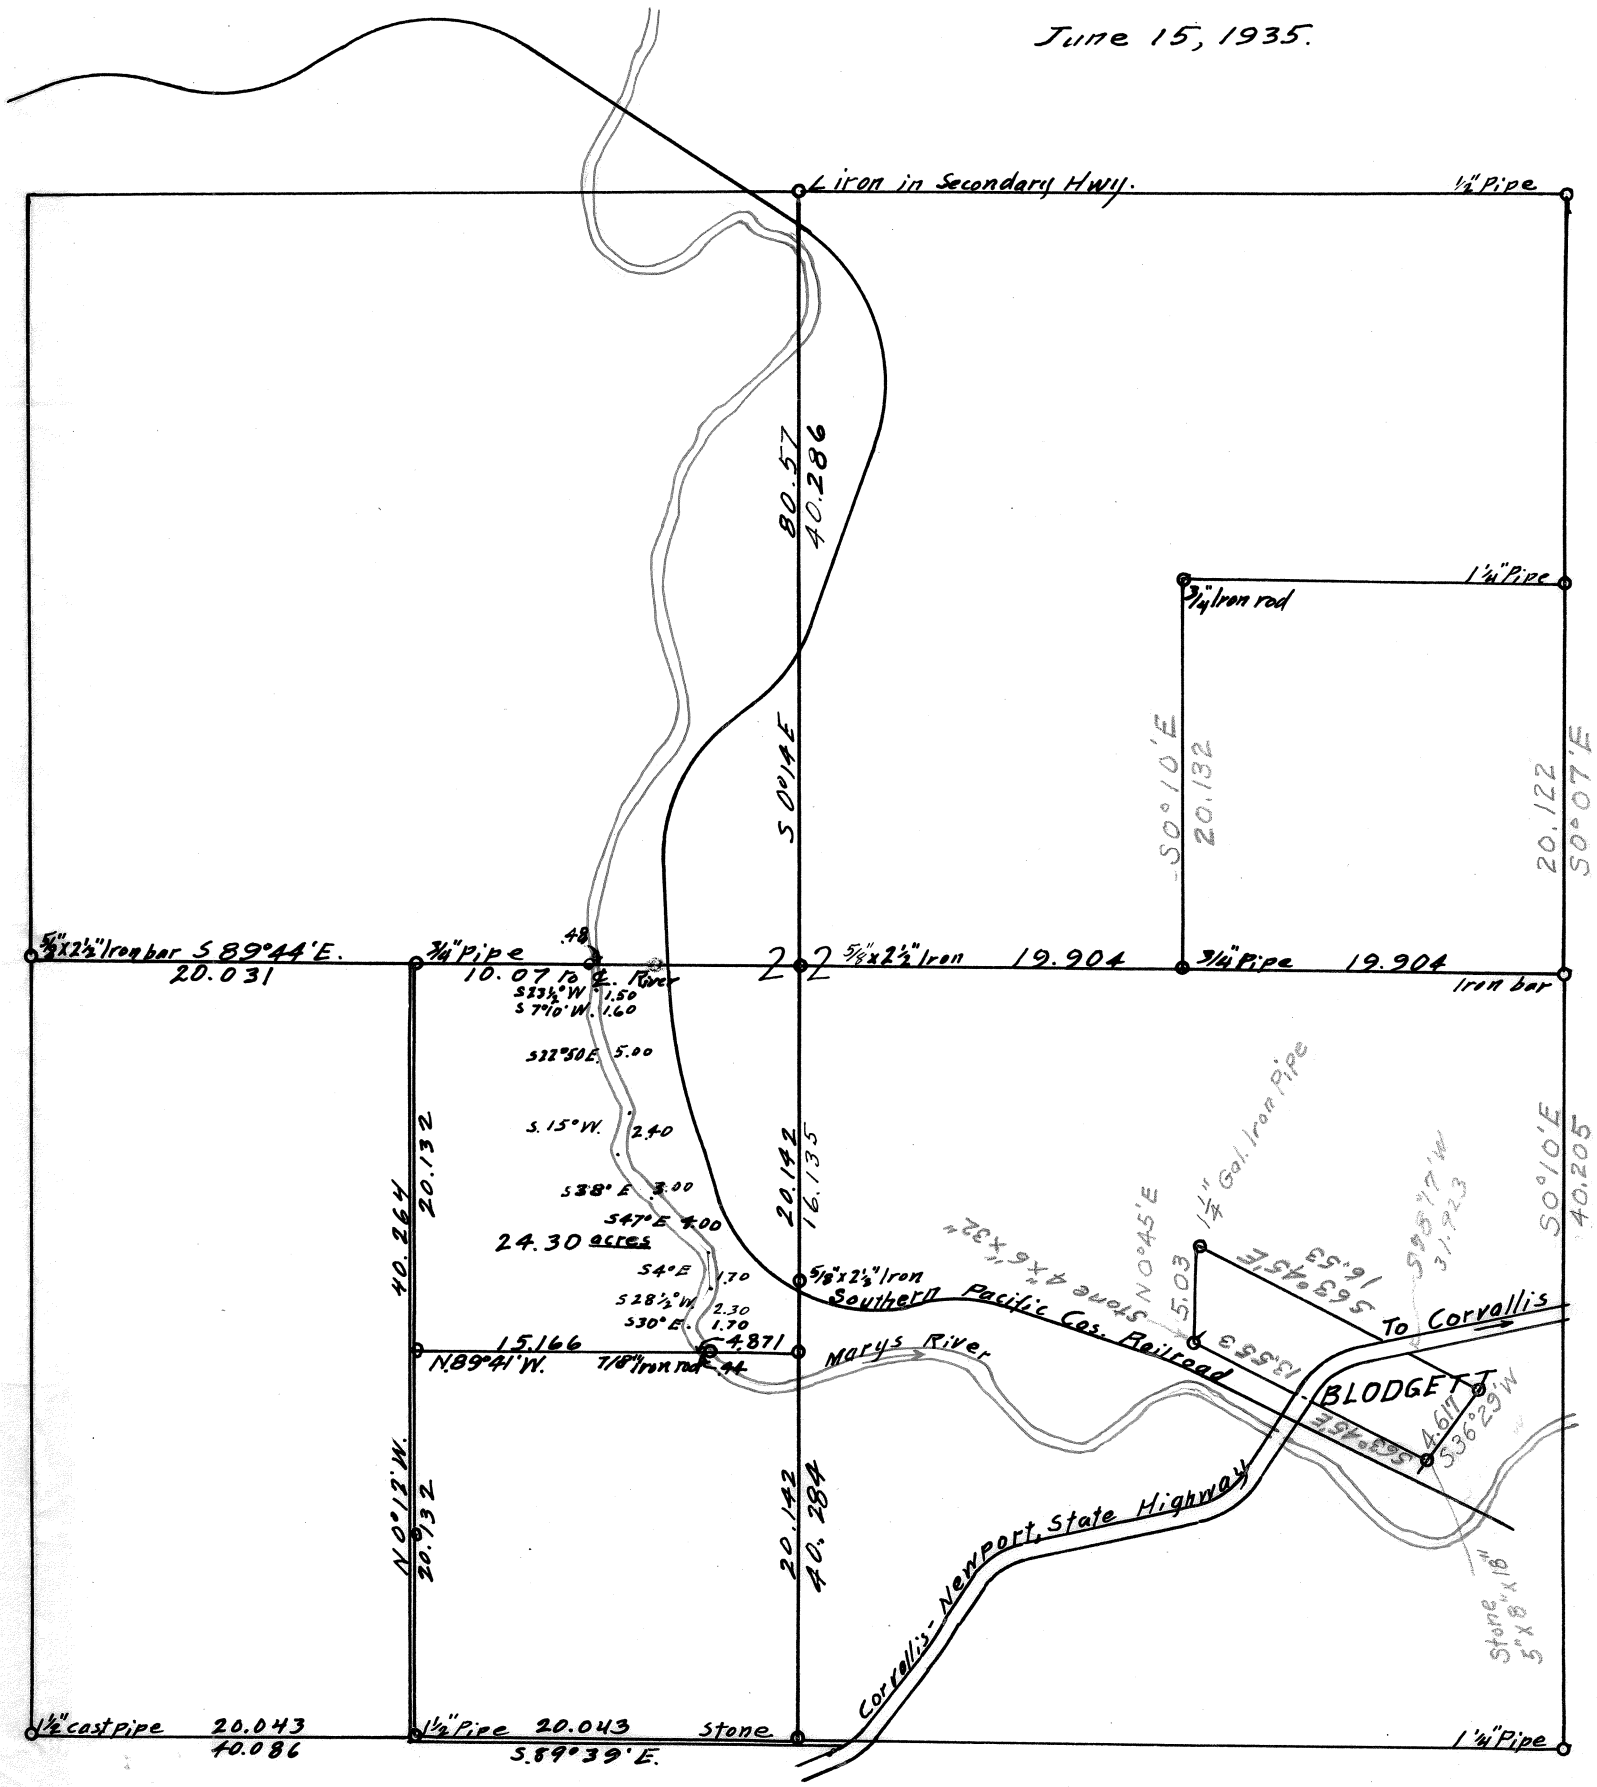

F/B # 26, Pg. 23 - 28.

23

#64.0

C. S. #265 Continued

Beginning at 15|14 / 22|23 is T 11-7

△ O is ⊕ S. .094 W. .128

N 53°40' E. .159

S. 0° 34' W. Correction E 34'

1		+1°40'	4.140	.170 E.
2		-5°40'	7.255	.242 E.
3		+3°45'	2.853	.270 E.
4			2.465	.294 E.
5		-7°5'	2.403	.318 E.
6		-8°40'	.727	.325 E.
			+.254	
			E. .327	

Set a 1¼" pipe

7		-11°23'	3.932	.364 E.
8		-2°55'	3.258	.392 E.
9		-4°55'	2.482	.422 E.
10		-7°30'	8.016	.501 E.
11		-5°40'	2.537	
			+.321	
			E. .529	

22|23 Recest.

Set 5/8" x 2½" x 24" iron bar

For Edgar Plunket Oct. 1, 1918.

159 159
8550 8295
1272 795
7 143
.1279 3
.0941

.00996 = 34'

offsets 40.244
.128 W.
.529 E.
.401 E.

.401000
362196
388040
362196
258440
241464
16976.

20.122
19.868
.254

.094
4.138
7.219
2.847
2.465
2.385
.720
19.868
3.855
3.254
2.473
7.948
2.525
39.923
.321
2|40.244
20.122

3932 7932
33089 016
353 88 7.948
31 45
11
1

38545 S. 69° 15' E

2366 2.366
92453 41539
7998 21294
1183 709
194 118
4 2
2
.8381 2.2123

8.000
3.576
2424 - 12° 31'
32679
21816
1698
145
2.3659

	Set S. .319	or	.003 W. of cor.		
12		on bug. &	W. .528		
	N 89° 30' W.				
	correction S.C.				
13	N 89° 36' W.	+5° 30'	4.768		
14			1.877		
15		-1° 15'	5.219		
16		+8° 35'	7.416		
			+.119		
			S. .039		
40th cor.					
	Set 3/4" pipe				
17		+5° 20'	2.393	S.043	
18			2.106	S.047	
19		-4° 20'	3.047	S.043	
20	Not	-14°	3.877	S.043	
21	∠ Right 5' from	A19 -5° 25'	4.775		
22			.425	offset on .008 N.	
23		-29° 08'	2.992	S.47[illegible]	
24		-7°	1.692	S.07[illegible]	
25	∠ Right 10'		2.876	offset .056 N.	
			+.146		
			S. .139		

cen. sec. 22

Set 5/8" X 2" X 20" Iron

Fir 10" N 76° 30' E .351 ft.
" 13" S 52° 15' E. .452 "
" 15" S 38° 30' W. .237 "
" 8" N 74° W. .250 "

.98880
7.5
49440
6216
741600

offsets 79.87

.003 N.
.008 N.
.056 N.
.067 N.
.212 S.
.145 S.

.00181 = 6'
14500
7987
65130
63896
12340

19.904
19.785
.119

.528
4.746
1.877
5.218
7.416
19.785
2.383
2.106
3.038
5.182
2.613
1.679
2.876
39.662
.146
2 | 39.808
19.904

4.757 2.992 2.876
.425 94378 9491
5.182 23936 2876
541 2094 2588
5182 89 115
2072 11 25
259 2 .05604
.007513 2.6132

25					
26			+ 7°50'	.687	
27			−10°5'	2.220	
28				19.899	Trianglated distance
at ∠ 28 turned			3°20'	Lt. to S.	6.416
Int. ∠ 72°9½			-2°35'		
29			+ 50'	3.689	
30			+ 3°	4.466	
31			+10°30'	6.329	
32			+11°45'	2.729	
				+.397	Left 28°07' .450
Recst.					
21/22	Striking N. of		cor.	.212	Oct 3,
Set ⅝"x 2½"x 24" Iron				found hole	
Fir	15"	S. 77° E.	1.34	obs. std.	
"	20"	S. 3° W.	4.21	"	" dead
"		S. 51° W.	.057	"	
Back to △ 25					
	North correction W. 7'				
33			-9°10'	2.167	
34				1.148	
35			-8°	7.260	
36				4.083	
			7°	8.004	
37				.210	
38			-1°30'	6.729	
39	∠ Left	5'	+1°35'	2.950	offset .012 W.
40			+24°20'	1.411	

212

2220 6.416
55489 13899
19980 57744
1776 5774
88 513
11 19
1 64050
2.185 6

19.899
6.4050
32187
3186 30
289 683
289470
257496
31 9740
28 9683
30057

.32187

.32203
.32171
2.64374
.32187

72174 99188
1800 3600
315 360
4 3
.2119 .3967

2.167
32789
19503
1733
151
4
2.1391

7.260
72099
65340
6534
1
14
5
7.1893.011522

7.947
541
7.947
3178
397

1.411
.6119
.12499
141
14
1.2855

offsets going N.
.063 E.
.012 W.
.051 E.
.218 W.
.167 W.

+130' 3.153

6.405

.681
.148
.535
2.186
19.899
22.620
20.031
2.589

6.329 2.729
52389 50979
56961 24561
5063 1910
189 245
12 1
3 26717
6.2228

3.689
4.460
6.223
2.672
.397
17.441
20.031
E. 2590-
+S. .176-

.00207 = 7'
.16700
.16114
58600

80.57

39.662
.681
2.186
19.899
3.689
4.460
6.223
2.672
79.472
.397
79.869
39.565
40.062

2.139
1.148
7.189
4.083
7.944
.210
6.727
7.947
37.387
2.286
38.673

26

41			+ 13°55'	.674	
42				.806	N. 82°15 W.
15/22	Reest.			-.027	.221
	Striking E. of cor.			.218	
	Set ∠ iron 24" long BR. just				(found both trees scribed)
	Fir 4" S. 13°20' W. .532 obs.				
	" 9" S. 82° W. .429 "				
	Back to △ 25				
Thence	South correction E. 7'				
43			+10°40'	.716	W. 115
44				1.090	W. 113
45			-1°35'	3.598	W. 136
46			-7°	1.386	W. 133
			-10°25'	7.841	W. 117
47			-9°30'	1.172	W. 115
				+.626	To RR. R.W.
				W. .114	
	Set 5/8"X2½"X20" iron bar				
48			-7°45'	4.454	W. 106 (10° cor.) +.220
49			+20°8'	4.519	W. 097
50				669	W. 096
51				4.791	W. 086
52			-3°40'	4.940	W. 076
53			-9°10'	3.084	W. 070
54			+6°30'	2.648	S 49°10' W .083
				+.054	
22/27	Striking E. of		corner	.063	

.674
5.6059
6066
337
4
6407

.716 7.841 1.172 4.454
27289 25389 92689 78099
6444 70769 10548 40084
501 6272 937 4008
14 235 70 35
5 39 2 3
1 1
6964 77316 11558 44132

3.0844
32789
27756
2467
215
6
3.0444

+.659
033
626

Set ∠ iron

40.147
139
40.286

4.519
98839
40671
1355
361
36
4
42427

15.648
139
15.509
626
16.135

15509
4413
19922

38.673
.641
.806
.027
40.147
.696
1.090
3.598
1.376
7.732
1.156
4.413
4.243
.669
4.791
4.930
3.044
2.631
.054
80.570

80.570
40.286
2 40.284
20.142
19.922
.220

27

	Back to △ 6 Tan.			Δ Lat W. 320	
	N 89° 34' W.			& N .255	
	correction N. 5°				
55	∠ Right	+4°20'	+ 8°25'	2.881	offset .214 N.
56			+3°10'	2.023	offset .153 N.
57			-1°30'	1.580	offset .119 N.
58	∠ Right	+1°54'	-11°35'	7.911	offset .257 N.
59			-9°20'	5.423	
60				.084	= .074 at P.C. to line
61	Set S. 0° 32' E.			1.026	
	Set 5/8" X 36" Iron				
	South correction E 4½				
62	∠ Right	+22'	+23°24'	3.151	offset .020 W.
63				.257	
64			+1° 15'	6.008	
65			-2°40'	3.415	
66			+ 4°	2.503	
67			-2°40'	1.377	
68			-6°45'	3.588	
				+.044	
	Striking W. of cor.			.040	
	Set ¾" pipe				
	Back to △ 12		& set S.	.006	
	S. 89° 45' E.		- 7°15'	2.688	
			-9°10'	6.800	
			-2°5'	8.000	

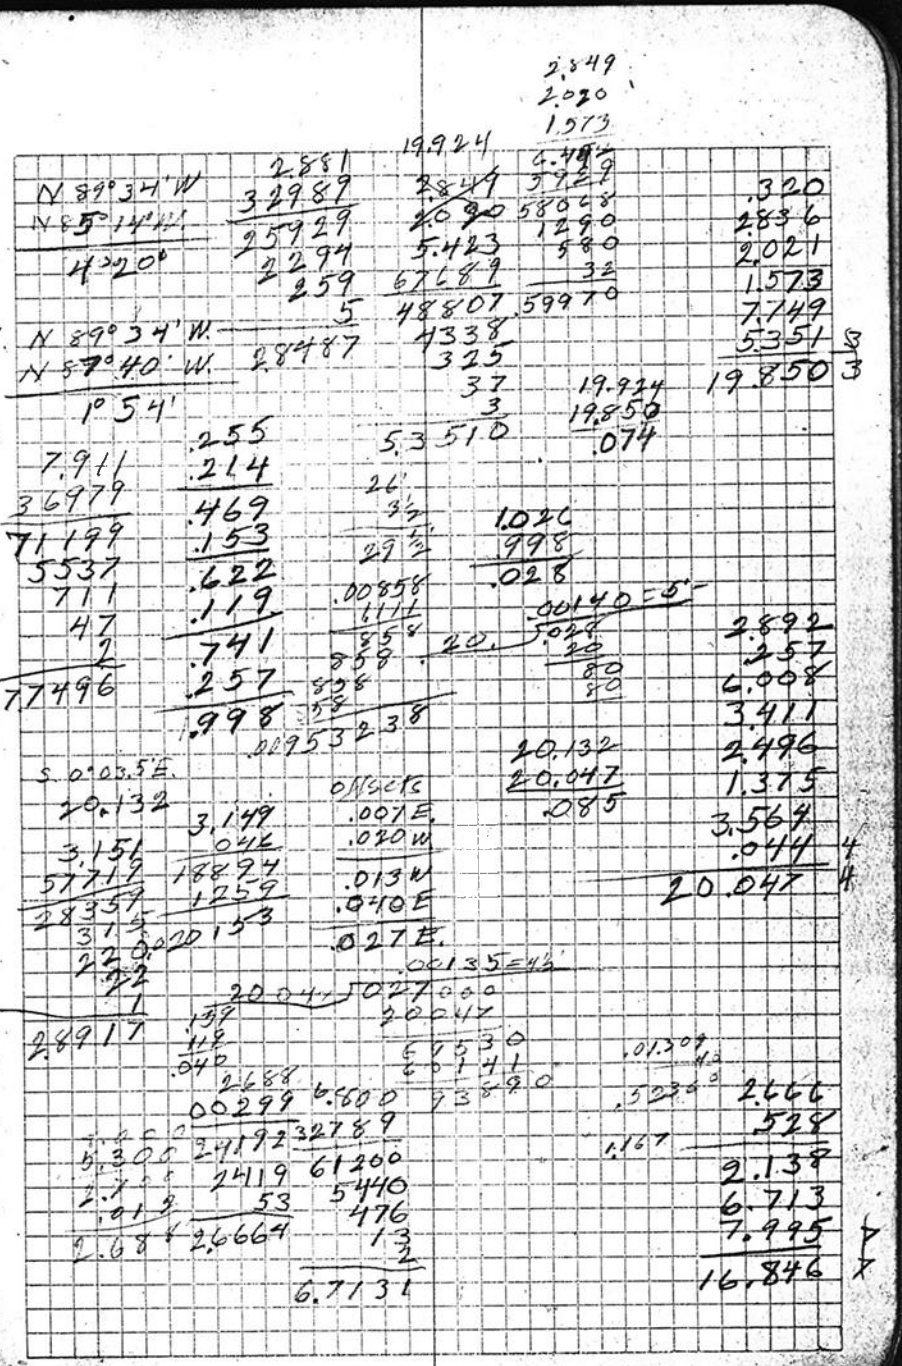

28

69		-1° 20'	3.437	3.437
			- .399	3.437
	Set a ¾" pipe			
		-1° 45'	3.558	
		-5° 50'	7.968	
			8.580	to W. line of s. cl. 40
70				0°00' E.
			- .733	7.710 N.
71		Surface		of N.E. of
	Set ¾" pipe		E. 1.26	Cl. E 38
	South		24.000	
	correction E. 11"	+ 5°	7.967	
			8.267	corr. value N 88° 50' W. 47' N89°-37'W.
72				
	Reest			
23/24	Striking W. of cor.	Surface		
	Set Q.t. bolla	12"	bolla oaks down.	
	Apple tree 10" N 49° 10'		E. 3.731	+6° 50' 3.758
	Oak " 10" S. 7° 56'		E. 5.509	+3° 10' 5.517
	Top of Thompsons house bears N 68° 36' W.			
	Back to △ 69		- .399	
73	S. 0° 07' E.	-1°	7.365	
			.190	
	Set ¾" pipe			
74	N 89° 18' W.	+2° 30'	3.219	
75		-2° 40'	4.976	

Reest.

¼ sec. cor. 23/24 S. 89° 40' E.

Set ⅝ x 2½" x 20" iron RR Bo.

Found both oaks which check NW. stump NE. tree down

Oak 10" N. 47° 50' E. .418 cks.

Fir 7" S. 79° 50' E. .403 "

North & S.E. cor. of Jas. W. Vanderpool Cl. 45

From W. line of Blodgett Cl. N 0° 47' W. line W. thru sec. 23 is S. 89° 36' W. — W. l. sec. 23 is S. 39½' E.

80.543 | .253000 = .00314 = 11'
241629
113710
80543
331670

20.284 − 19.885 = .399

16.846 + 3.438 = 20.284
20.284 − 3.586 = 7.927 + 8.580 = 40.371 − .607 = 2 | 39.770 = 19.885

.733 − .126 = .607

2318 | 143831
72099 | 25479
208417 | 34479
20846 | 3447
1 | 32
229263 | 19
3510
6.105 | 3.8098
.060
6.165 | E. 1.85
5.97
.195

W. line of sec. 23 from ¼ cor. S. 0° 03' E.

N. 68° 36' W. at N. window of Thompsons house

24.000
7.937
8.267
.294
40.298

40.298
40.245
80.543

7.364
.190
7.554

3.216
4.971
8.187