C.S. # 641

Hardcopy 15-4 #2

also see notes in file

F. B. 26-29

REEL 15 FRAME 226

29 #641 F/B # 26, Pg. 29-32

C.S. #52 Continued. Oct. 11, 1918. For Claude R. Ritter.

W. Sohlman

Beg. Δ 29 Book 23 Page 77 which is a

T. 14 & 15 S. R 4 W.

Thence N. 89° ~~33'~~ W. correction S. 31'

(S. 89° 56' W.)

1		9.525	S.052
2	∠ Right 35'	4.255	offset .043 N.
3	∠ Right 17°	3.893	offset .019 N.
	Set 1¼" x 44" pipe	S. .188	
4		2.965	S.215
5		1.536	S.229
6	∠ Right 45°	5.676	offset .074 S.354
7	-1° 30'	4.822	+1.60 ∠ to S.394
8		3.545	S.403
9		2.671	S.454
10		2.014	
		-.002	

Tp. 14 S. R 5 W. | Tp. 14 S. R 4 W.
36 | 31
1 | 6
Tp. 15 S.

Striking N. of cor. .472

Re-Set sand stone 18" x 8" x 6"

Maple 30" N. 17° E. .23 cks. std.

" 5" S. 40° E. .53+ " "

Ash 24" S. 60° W. .17 " "

" 20" N. 50° W. .20 " "

11 South " E. .002 of cor. ~~.043~~ +2.0 N bnk. S14.909

12 correction E. .19' 6.659 - 4.40 stake - .25 bnk. .060 E.

I backsighted on Δ 42 as S. 89° 33' E.

4.255
8.101
4.255
.04330

3.893
5
.019465

7.782
1.543
9.525

- 2.60 coll. slough

3.893 99996 | 40.969
2.600 | 40.9670
1.293 | 39.9984
9.68600
8.99964
6.86360
5.49976
8.63840

offsets
.035 S.
.043 N.
.008 N.
.019 N.
.074 N

5.676
.9031
5.676
1702
50
.07428

.101 N
.472 | .00905 = 31'
40967 | .371000
368723
227700
204835

offset
.002 E.
.222 E.
.224 E.

401 | .00558 = 19'
.2240
2005
2350
2005
3450

442
75
40
220
34

060
002
.035 E.

.224 E.

17.742
2.600
15.142

	.069
	9.525
	4.255
	3.893
	17.742
	2.965
	1.536
	5.676
	4.820
	3.545
	2.671
	2.014
	40.969
	.002
	40.967

4.909
.472
4.437
6.659
11.096

6659
44
2.26

11096
4.650
6.446

30

13		5.264	E. .284
14		3.562	E. .164
		+.127	
		E. 110	
Set 1¼" x 44" pipe			
15		7.996	
16		7.983	
17		5.099	∠ from transit line N 13°49' E. −.929
1½ Reset	Striking W. of cor.	.222	
	Set a Qt. bottle Surface 12"		
	Oak 20" N 35° W. 2.99 cks.		stk. remarked
	Back to .002 E. of Tp. cor.		
Thence	S. 89° 32' W.		
	correction N. 37' (N. 89° 51' W.)		
18		7.675	North
19		7.990	N. 177
20	∠ Right 4'	4.505	offset .005 N.
		−.117	
		N. .215	
Set ¾" bolt			
21		2.019	N. 237
22		5.847	N. 204
23	∠ Right 8'	4.164	offset N. 332 .010 N.
24		7.869	offset .018 N.
		+.035	
Striking S. of cor.		.404	

9.04

3.72

.929	.929	
28832	60171	
1858	8361	
278	650	
274	9	
7		
.2217	.9020	

N. 13°50' E. .929 to 1+6
S. 21½' W. 10.062 to stone

4.505	4.164	
611	332	
4505	8328	
4150	1249	
270	124	
.005222	.009701	.01090 = 37½'
	401	437
		401
		3600
		3208
		3920
		3609
		311

offsets
.005 N.
.010 N.
.018 N.
.404 N.
.437 N.
3 c

Re-Set 1"x23" I. rod
Pine 20' N 10° E. 2.67 2.692
" 24" S. 14° E. 3.38 3.39

20.049	19.922	
19.922	7.996	
.127	7.983	
	35.901	
	5.099	
	41.000	
	.902	
	2 | 40.098	
	20.049	

20.168	7.675	
20.051	002	
.117	7.673	
	7.990	
	4.505	
	20.168	
	2.019	
	5.847	
	4.164	
	7.869	
	40.067	
	.035	
	2 | 40.102	
	20.051	

31

S. 0° 15' E. correction W. 15' (South)

25

26

27 L Left 11'

28

29

+ cen. sec. 1

Set Stone 6"x12"x13"

Pine 36" N. 51°20' E. 1.614 cks. Trees already mkd.

Fir 32" N. 77°30' W. 1.256 "

30

31

32

1

12 striking E. of cor.

Stone mkd. C.S.

Oak 12" N. 13° E. .47 cks. std.

" 14 S. 11° E. 1.017 " "

Back to Δ 29

S. 89° 44' W. correction N. 20'+

33 L Left 47'

34 (N 89° 56' W.)

35

36

37

38 L Right 2°78'+

39 L Right 4° 38' - .10

21 Sand stone set

E. .036
S. .404 from cor. (W.088)
11.668 (W.715)
6.154
6.915 offset .022 E. (W.200)
7.425
7.694
- 104 at .234 W.
W. .234
10.039 (W.217)
15.038 (W.342)
14.9711
+ .057 S81°58' W. 80.410
.406

4.915
023
20745
1383
.022128 80.37

.00433 = 15'
.348 00
321 48
26520
24111
24090

offsets
.036 E.
.022 E.
.058 E
.406 W
.348 W.

40.260
.104
40.156

7.590
7.425
15.015
14.250
.765

.404
11.668
6.154
6.915
7.425
7.694
40.260
10.039
15.038
14.977
.057
80.368

410 410
57931 91099
410 3690
123 369
36 4059
2
.0571

N. 89° 47' W. 13'
S 89° 26' W. 34'
47'

5.865 3534 3595
7.131 3104 8708
5865 14136 28760
1759 33 251
351 10 28
41
.14181 .29039
80.3

.08016
offsets going E.
.290 S.
.142 S.
.432 S.
.080 N.
.352 S.

.3573
.095 S.
.025 S.
.004 S.
.476 S.

offset .142 N.
offset to Co. .290 N.

.00593 = 20'+
.4760
4013
7450
7237
2230

5.865
7.974
7.997
3.284
7.985
3.531
3.583
40.219

32

Back to △ 29

~~40~~ N. 89° 44' E. correction 20' S.

40 ∠ Right 1° 3' 5.219 offset .095 S.

41 (S. 89° 56' E.) 7.978

42 6.370

+.358

N. .093

Set 3/4" x 22" I rod

43 ∠ Right 11' 7.945 offset .025 S.

44 7.380

45 5.202

-.010

.084

Striking N of 1/4 cor.

Back to △ 42

N. 0° 17' W. correction 9½' E.

46 ∠ Right 25' 7.984 offset .058 E.

47 5.217 offset .067 E.

48 ∠ Right 34' 6.767

+.153

E. .288

Set 1¼" x 44" pipe

N. 89° 36' E. correction N 24' E.

49 ∠ Right 13' 6.918 offset .026 S.

50 5.420

51 ∠ Left 16' 8.052 offset .037 N.

52 Back To cor. cor. near △ 42, S. 10¾ W. 6.521 offset .186 W.

53 ∠ Right 47' 3.722

7.250

+.007
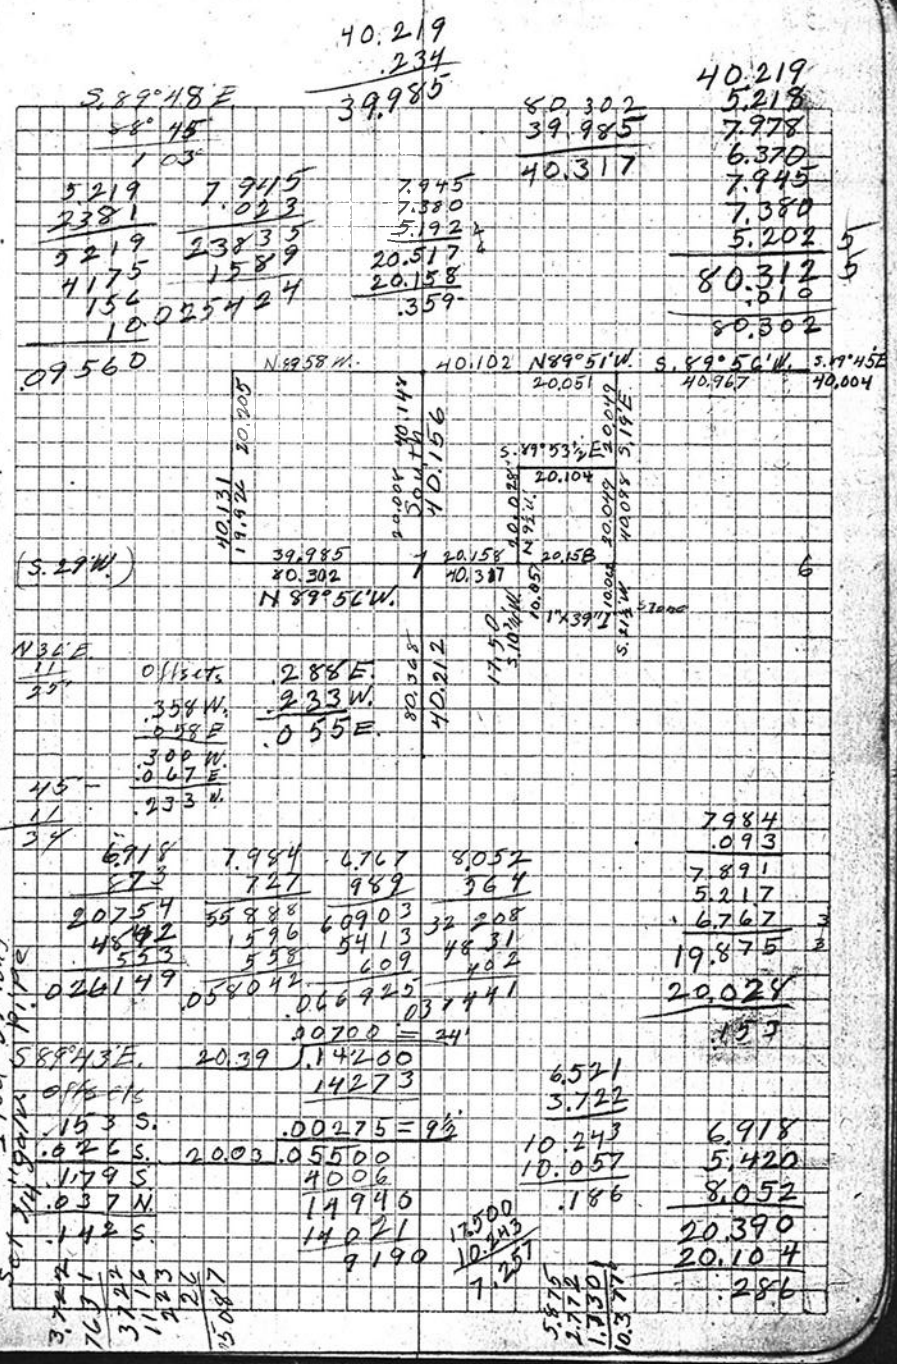
Set 3/4" x 3/4" I rod 36" N 89° 56' W. 3.528