C.S. # 653

Hardcopy 12-5 #17

also see notes in file

F. B. 26-63

FB#26 Pg. 63

63

#653

Platted on CS 264 Vert File

In NE¼ Sec 9-12-5

C.S. #61 Continued

	Westerly West line W. cor.			
	N89°59'E.	+2°50'	1.898	on S. 01 5a
		2°15'	5.284	
			3.698	
	Thence S.89°59'W.		2.980	
	from N.W. cor. of 5 acre tract.			
	Thence North			
1		-4°5'	5.781	
2		+1°35'	5.386	
3			2.838	set W.P38
4		-4°	5.050	9+ Lts to +1.39 will be +.478 S 89°59'W. +1.13
			.596	
			+.033	
			20.326	N72°33E.
			-.014	from
			20.312	O.I.W. 1½"
			+4.137	at corner road
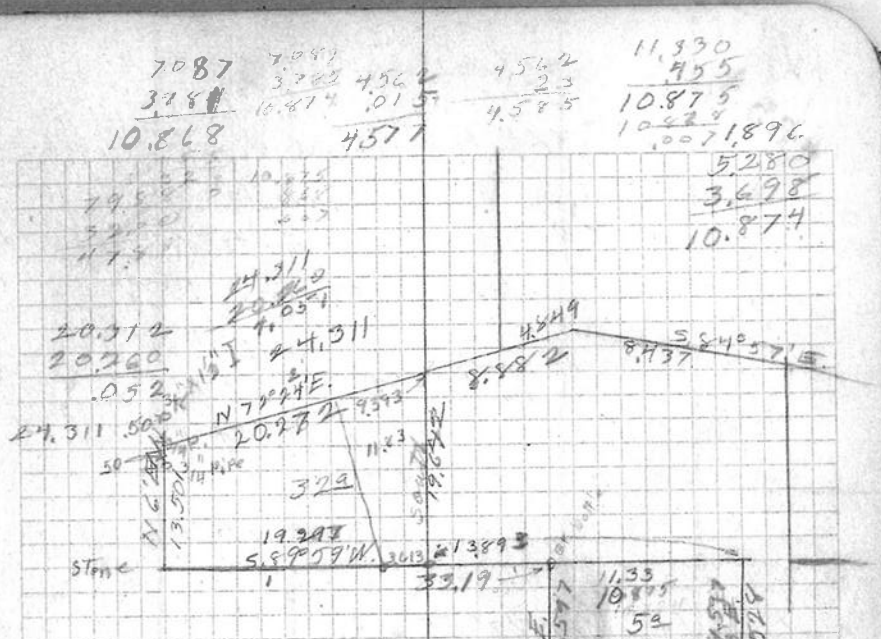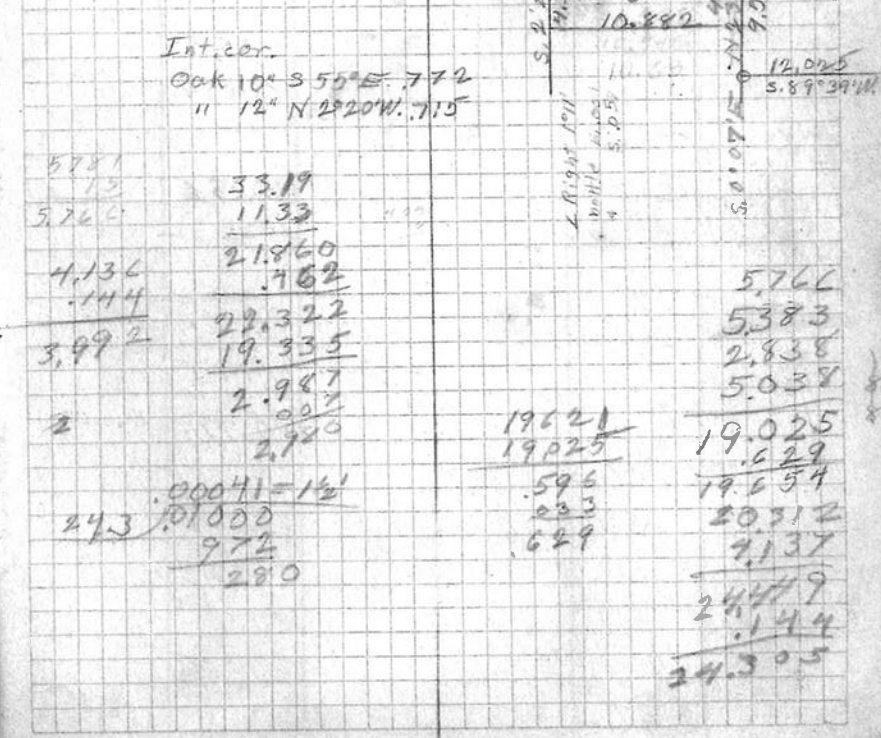
To Y.S.L. to 1½" pipe check brg. S. 12½ W.