C.S. # 660

Hardcopy 11-4 #17

also see notes in file

F. B. 27-2

C.S. 660

F/B #27, Pg. 2

2

#66 Miscellaneous in Sec. 19 & 30/11/4

Beg. at N.W. cor. of this piece

James H. Stewart Cl. #49 T. 11-4
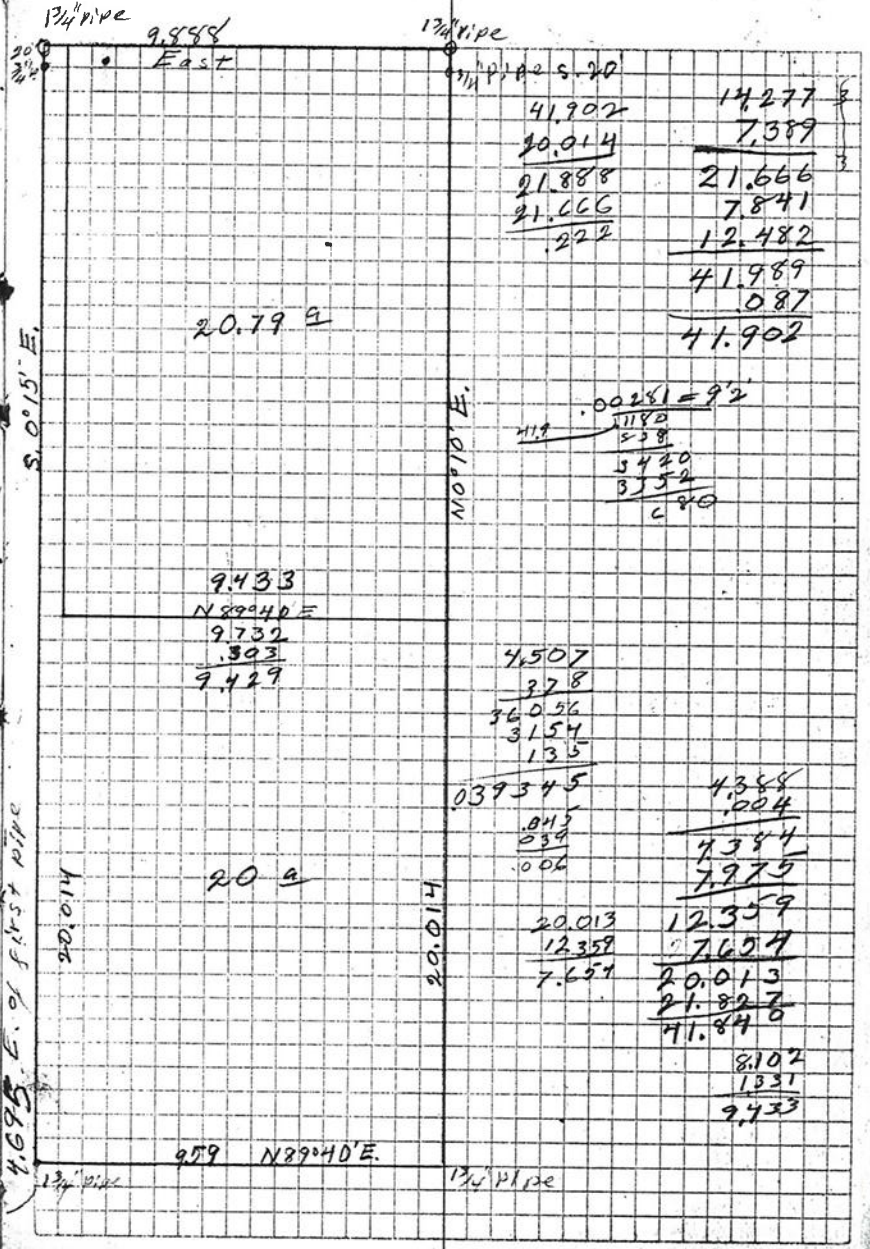
Thence	S. 0° 05' E. correction E. 10'	sighted East 9.888	
1	S	14.277	4.240
2		7.389	
		+.222	
		E. 061	
3		7.841	East
4		12.482	
		-.087	
	Striking W. of cor.	.118	
5	On S. line from pipe N. 89° 41' E. correction N. 1'	3.928	
6		5.662	
	Set 1 3/4" pipe		
	offset North	.046	offset
to cor.	∠ Right 30'	4.507	.039
From	Δ 6		
7	N. 0° 10' E.	4.388	∠ rt. W. .096
8		7.975	
9		7.654	
10		21.927	
	Striking West of cor.	.108	8.102