662

Subdivission of the EAST HALF OF BLOCK 4. COLLEGE HILL ADD. TO CORVALLIS, ORE.

Scale 1" = 50 ft.

Nov. 1, 1913, by F. Marion Wilkes.

C S 662

SEE ALSO
662-A
662-B
662-C

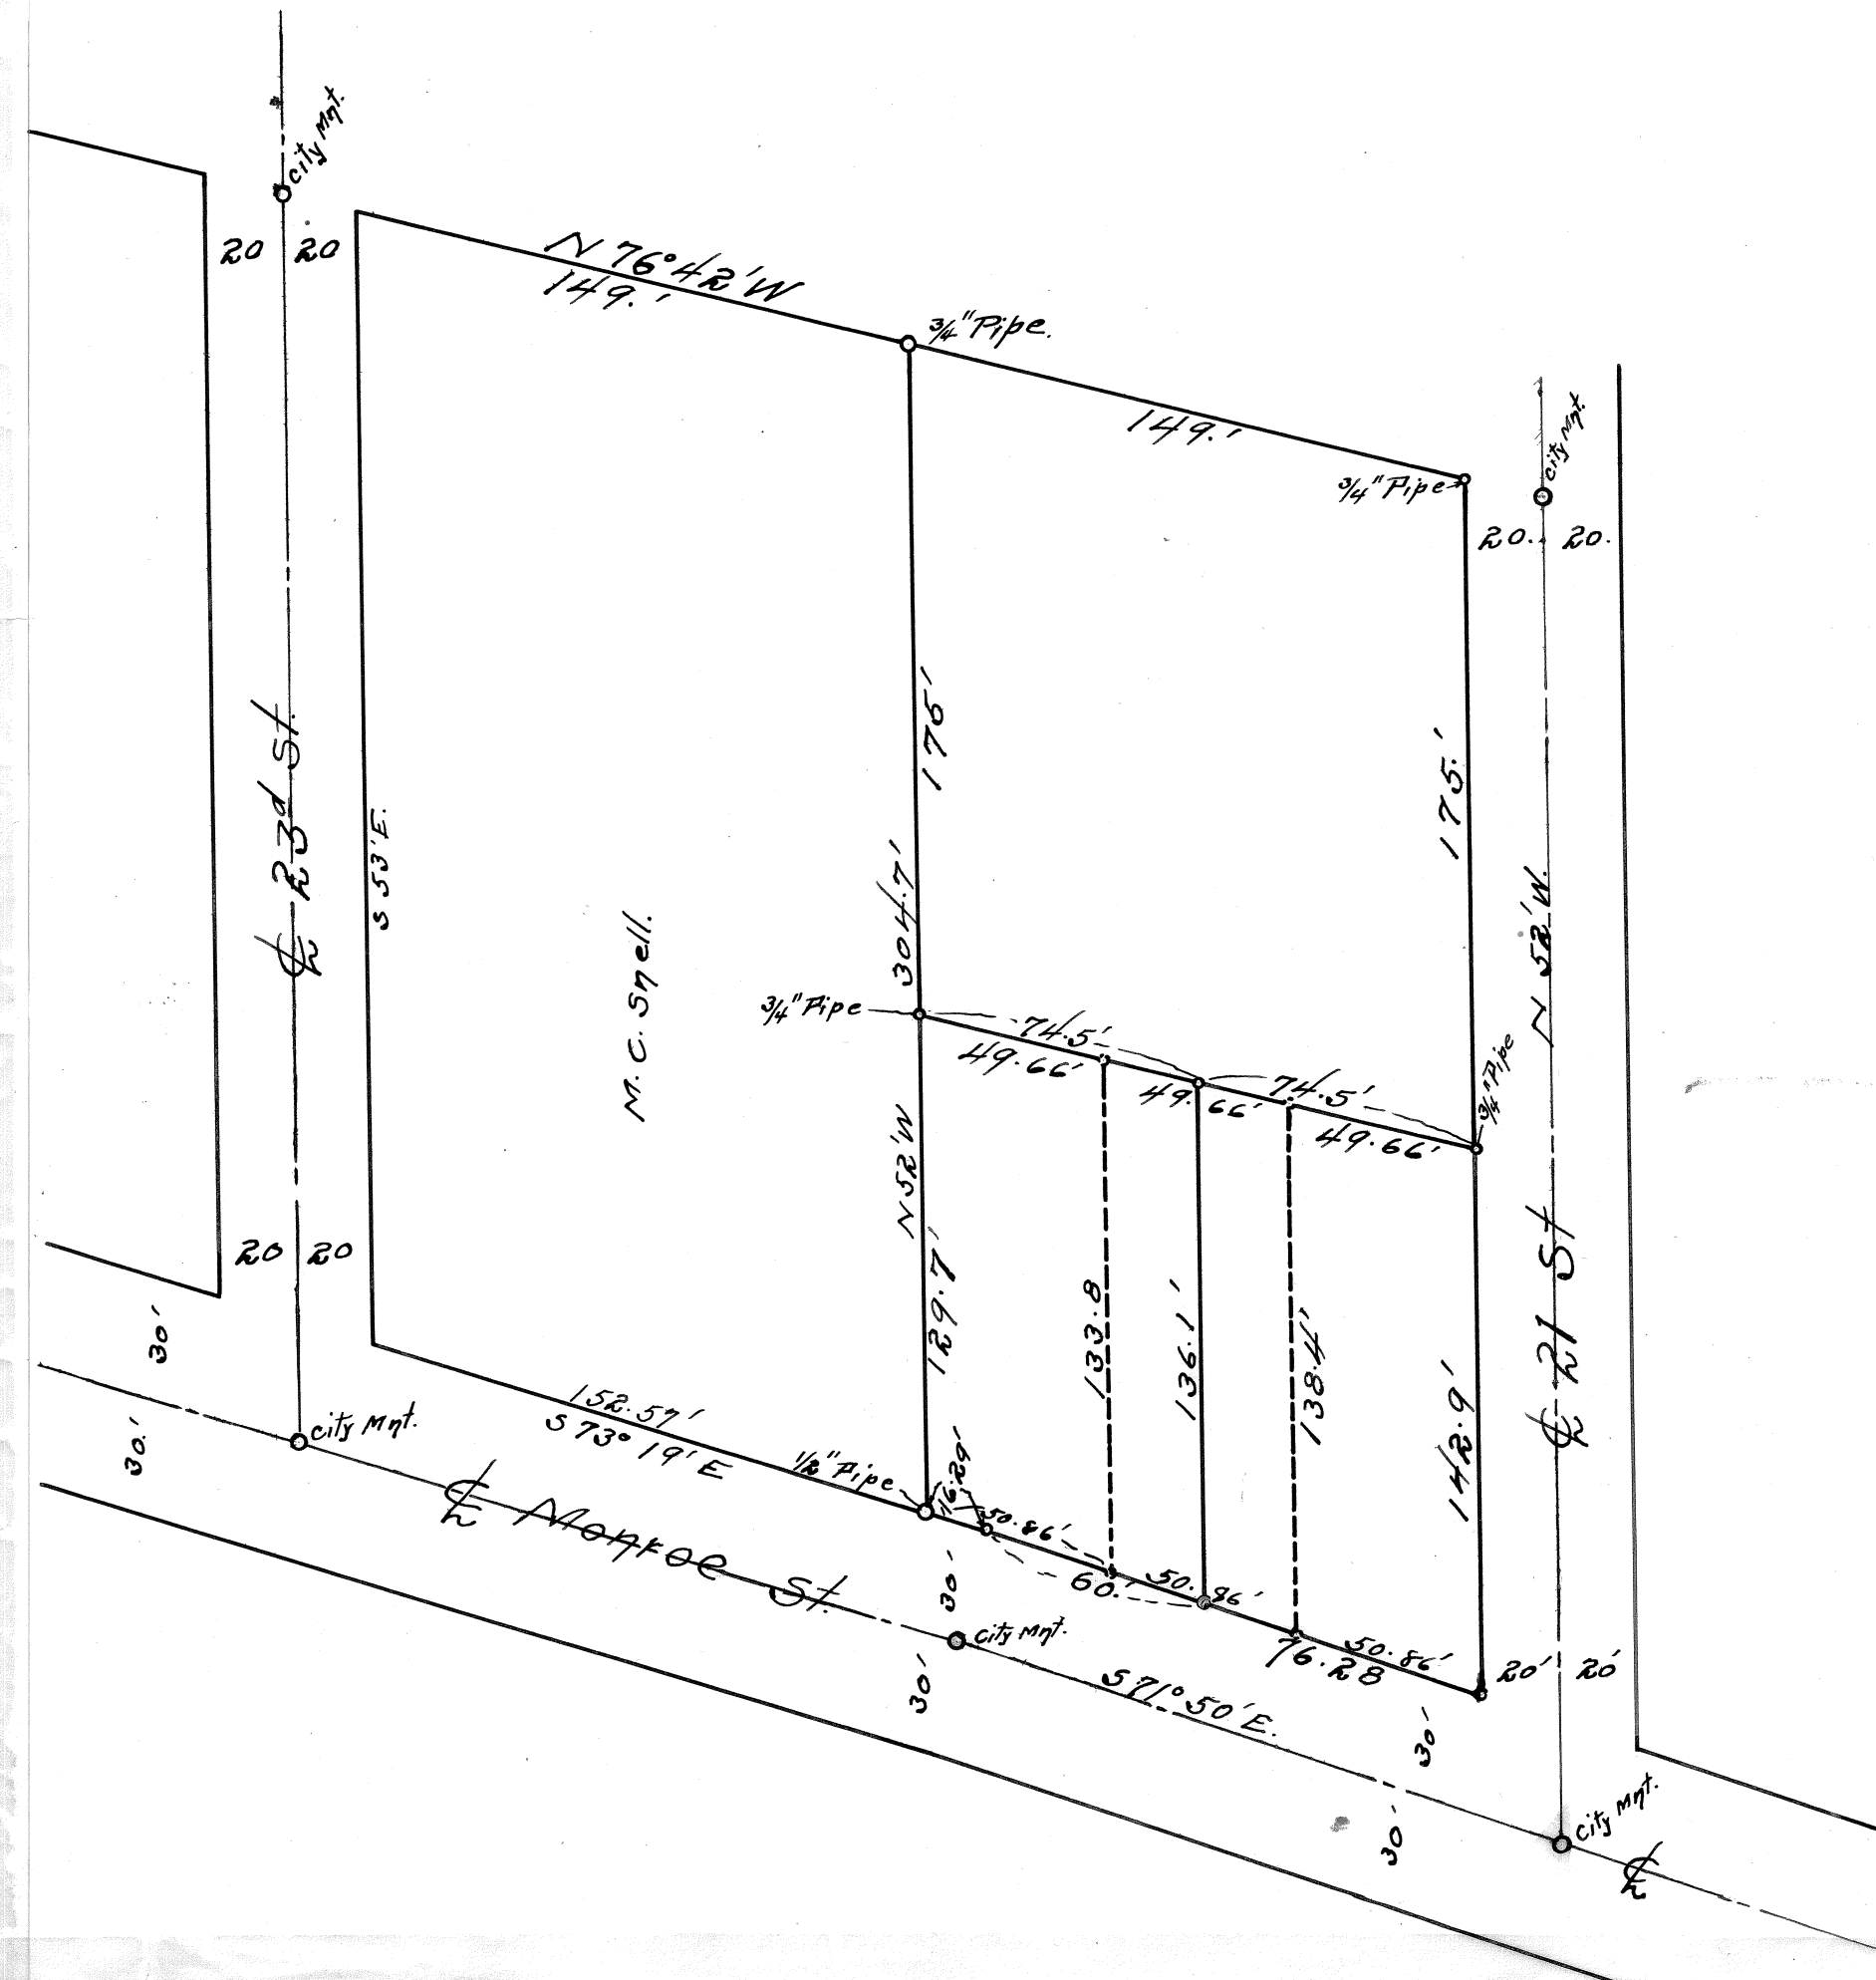

662

SEE ALSO
662, 662-B, 662-C

662-A

JOHN HEESZEL TRACTS

SCALE 1"=40' - JUNE 30, '19.

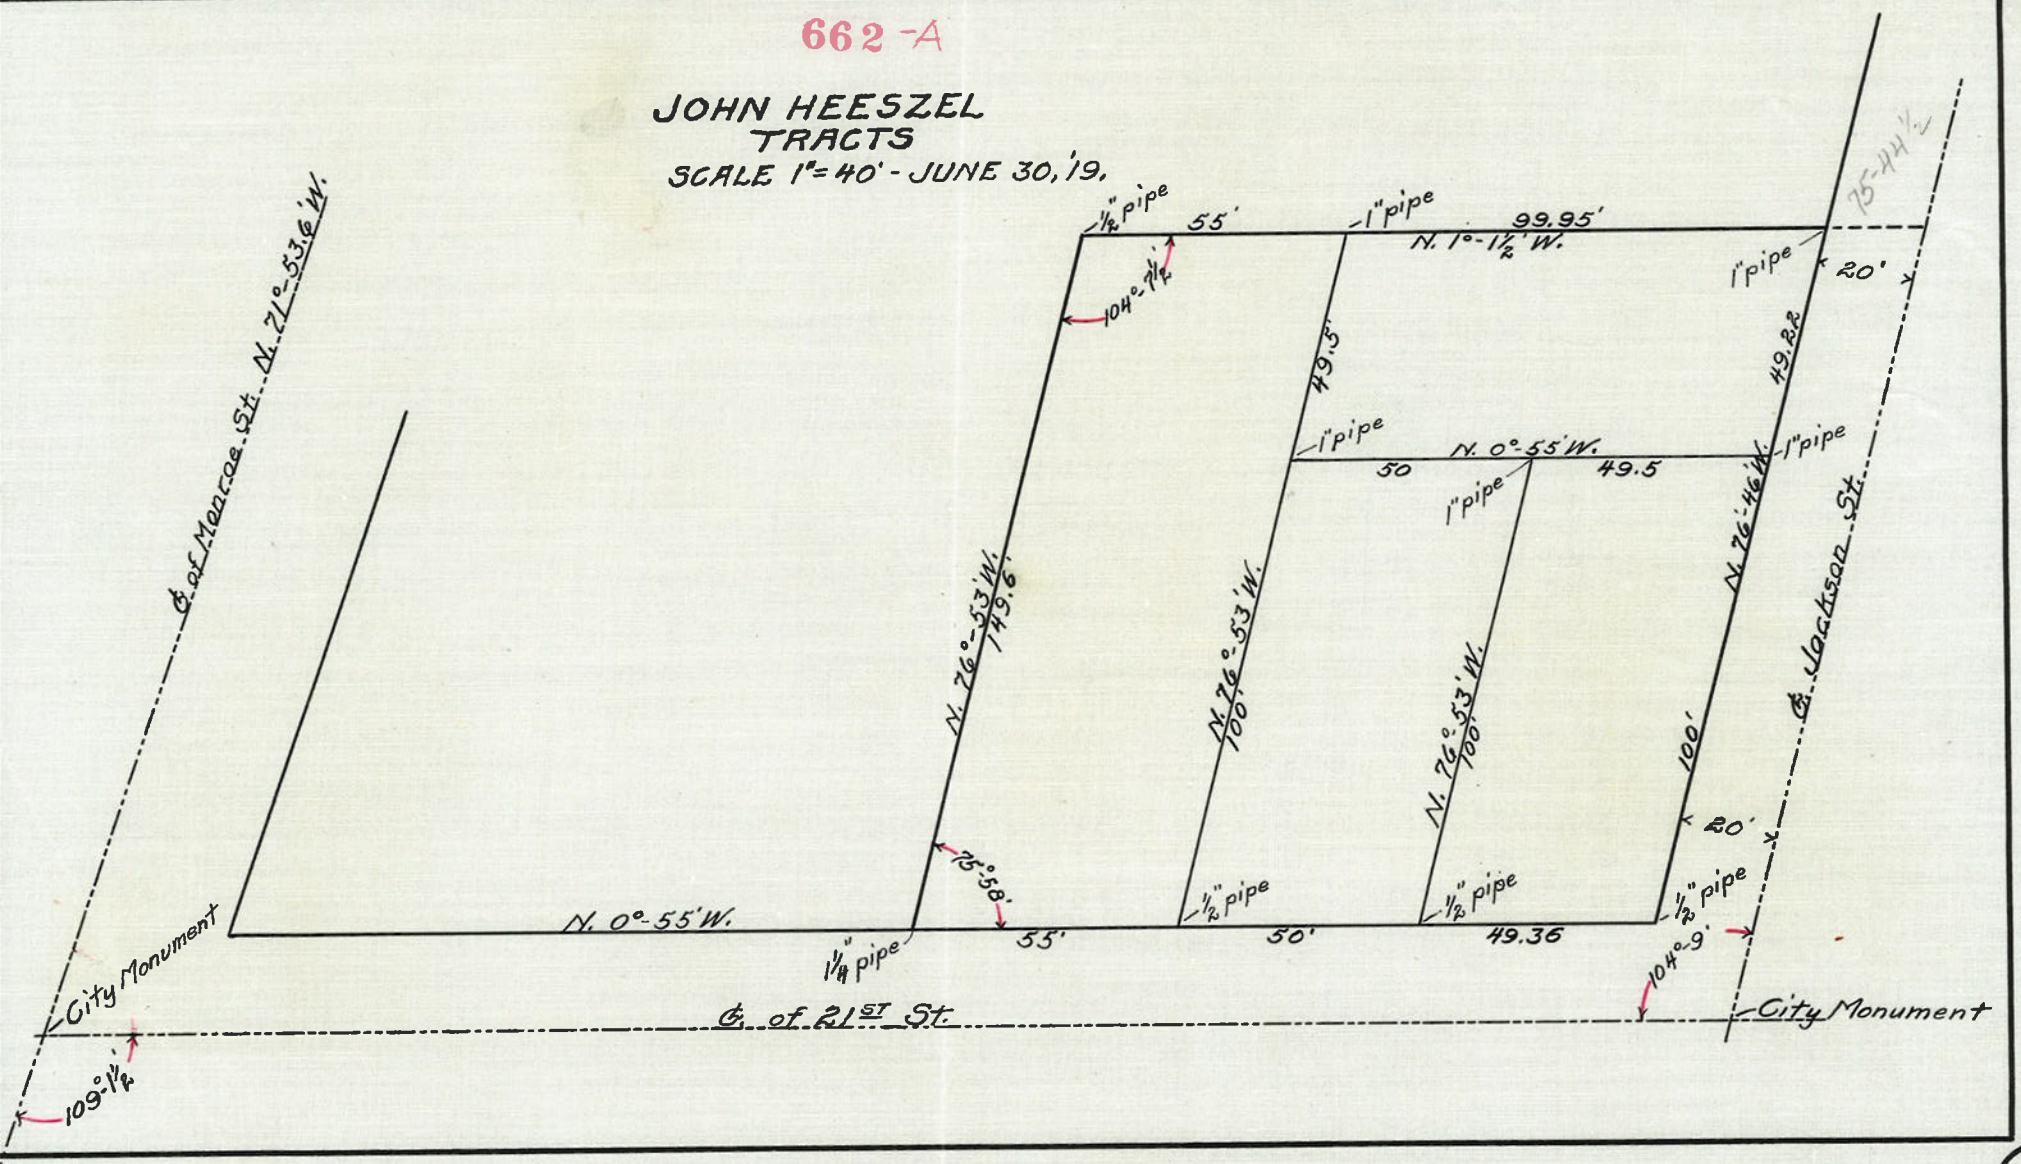

6

John Heeszel
851 - Macadam St.
Portland, Ore.

SEE ALSO 662, 662-A, 662-C

BLOCK 4 CS662-B
COLLEGE HILL ADDITION
TO
CORVALLIS, ORE.

Scale:- 1 inch = 50 feet.

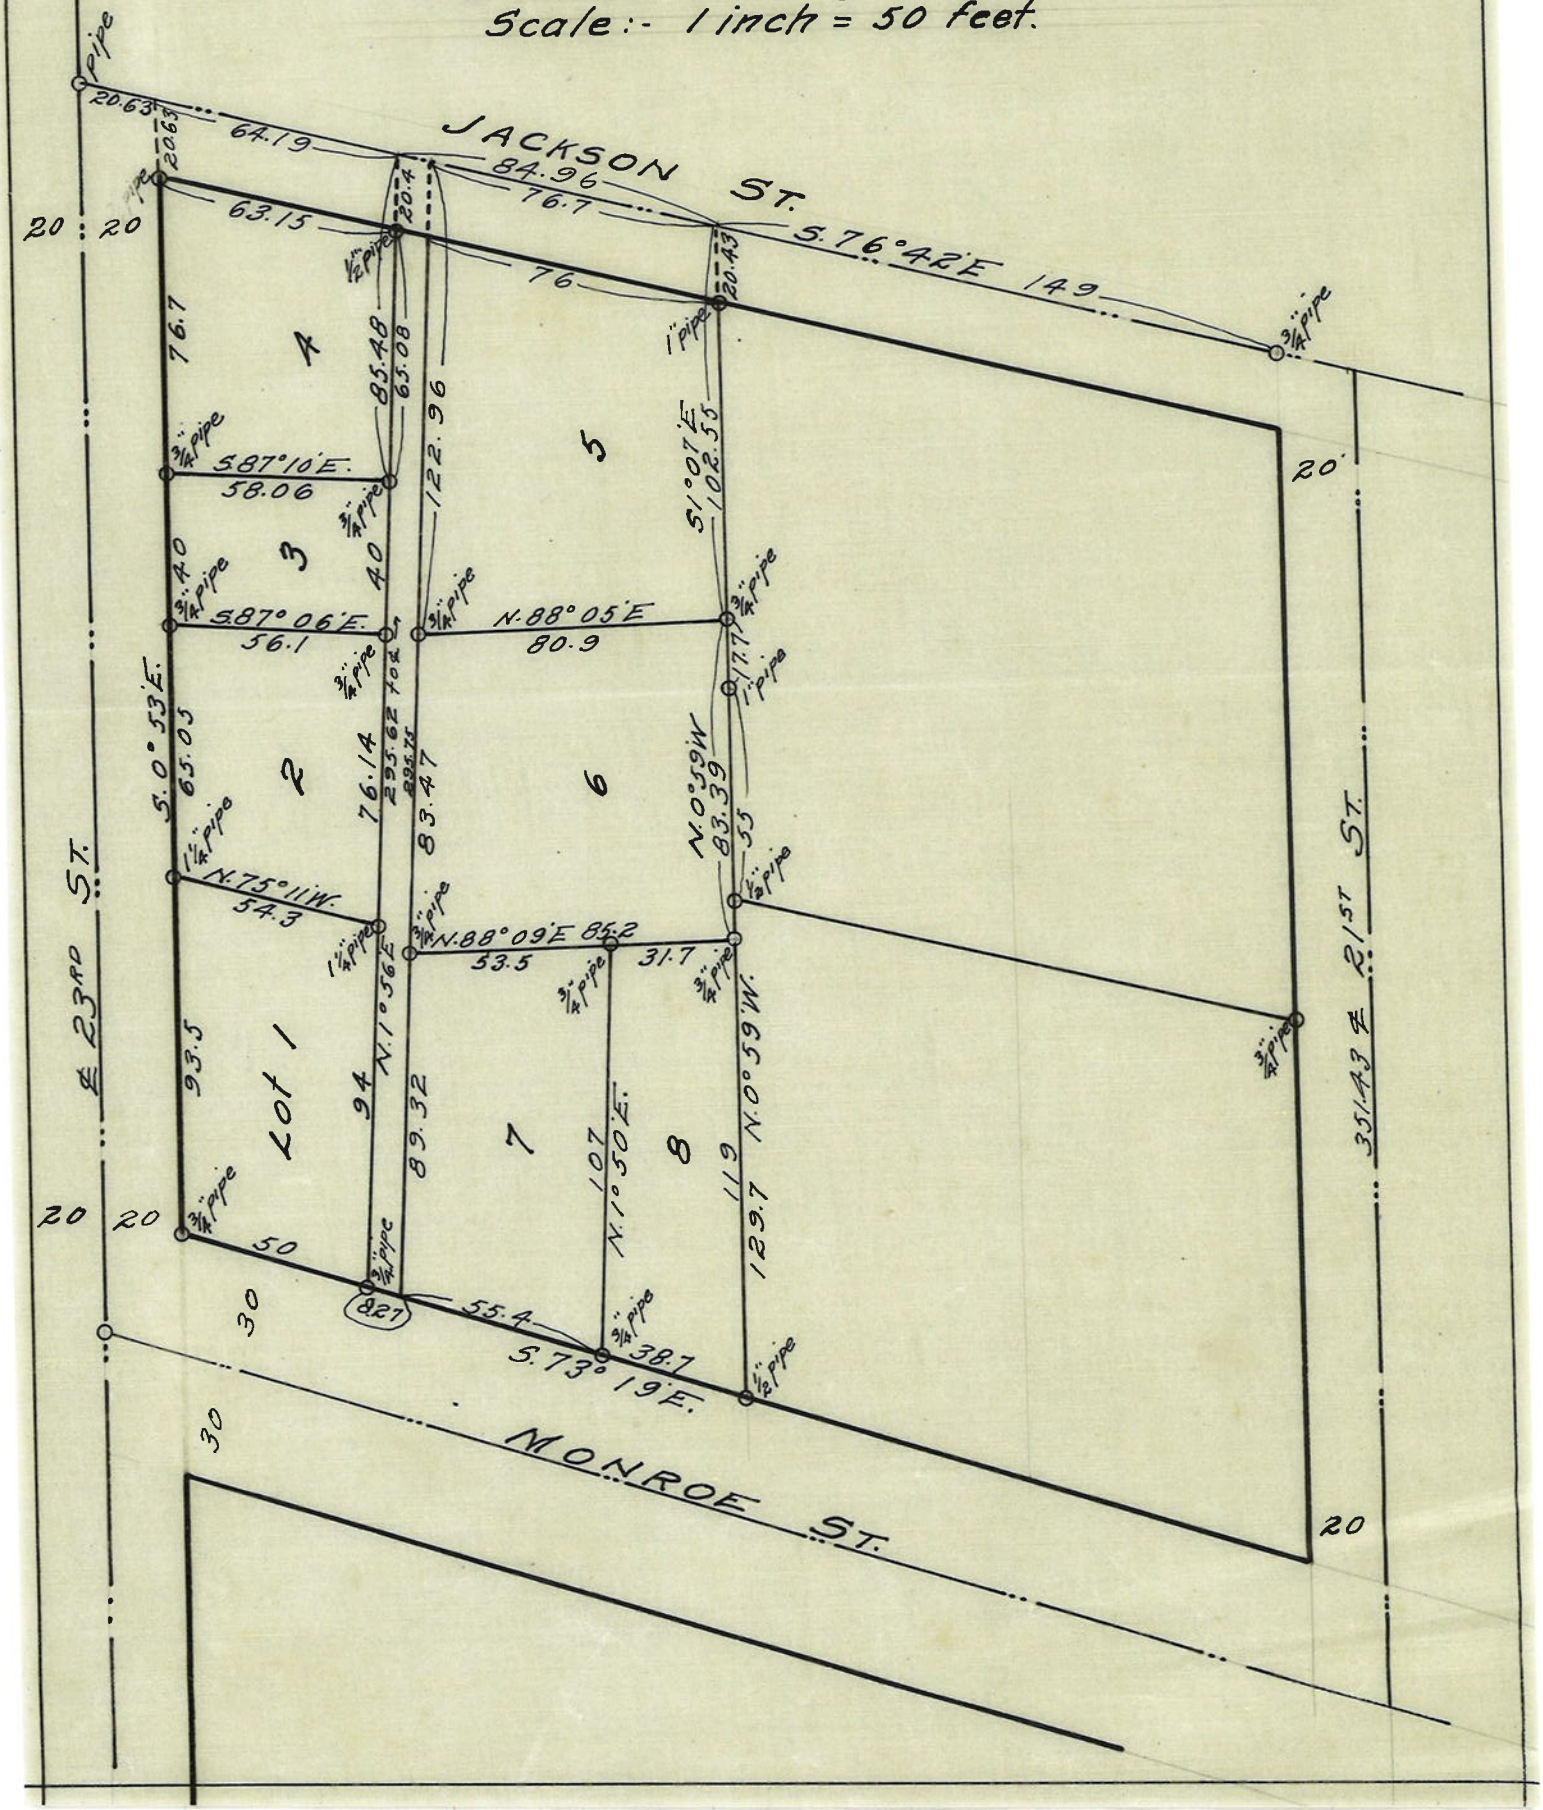

C.S. 662-C

BLOCK NO. 4.

College Hill Addition to Corvallis

SEE ALSO
662
662-A
662-B
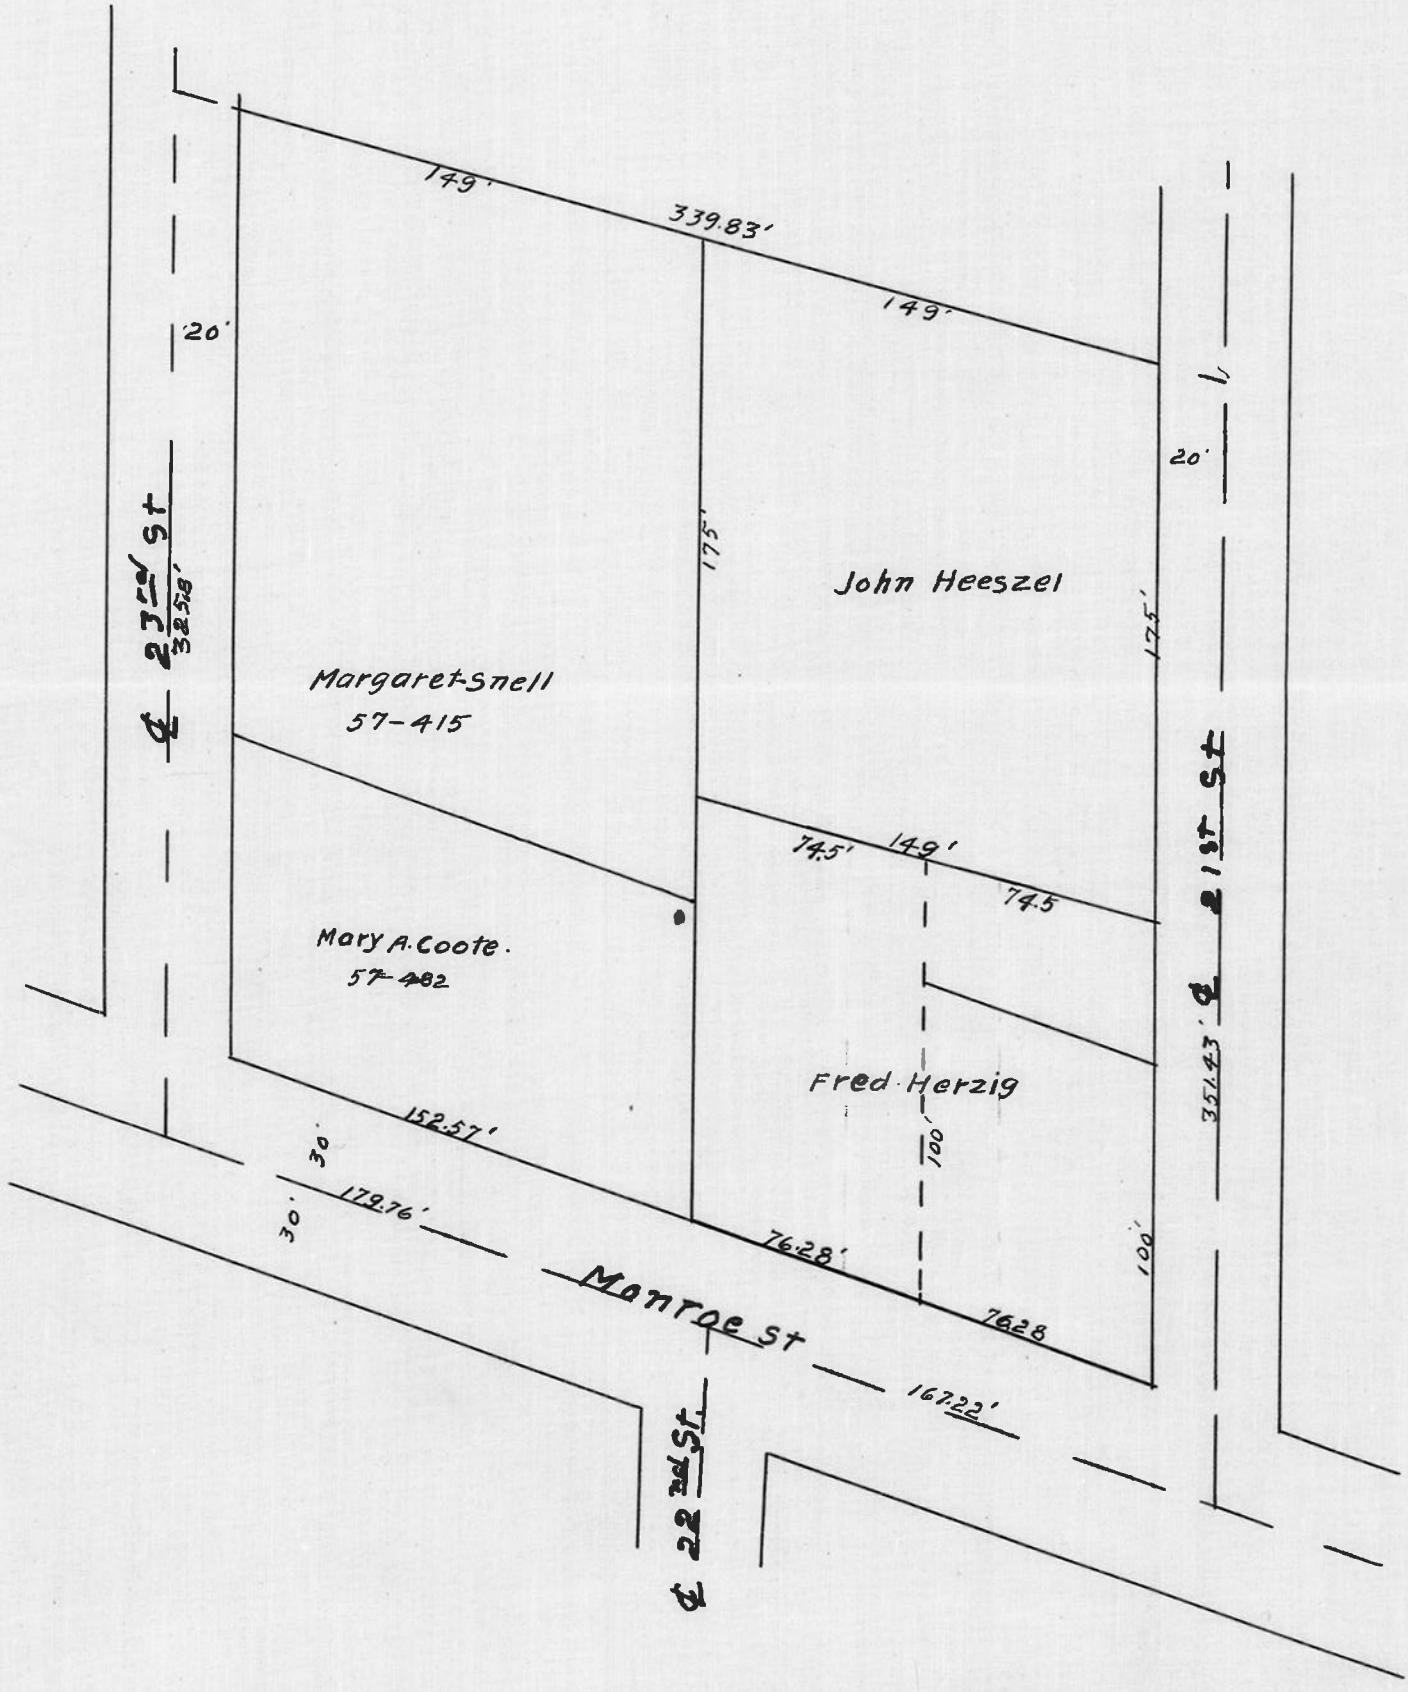
Scale 1" = 60'