665

Bl. 13 County Ad

Jackson St.

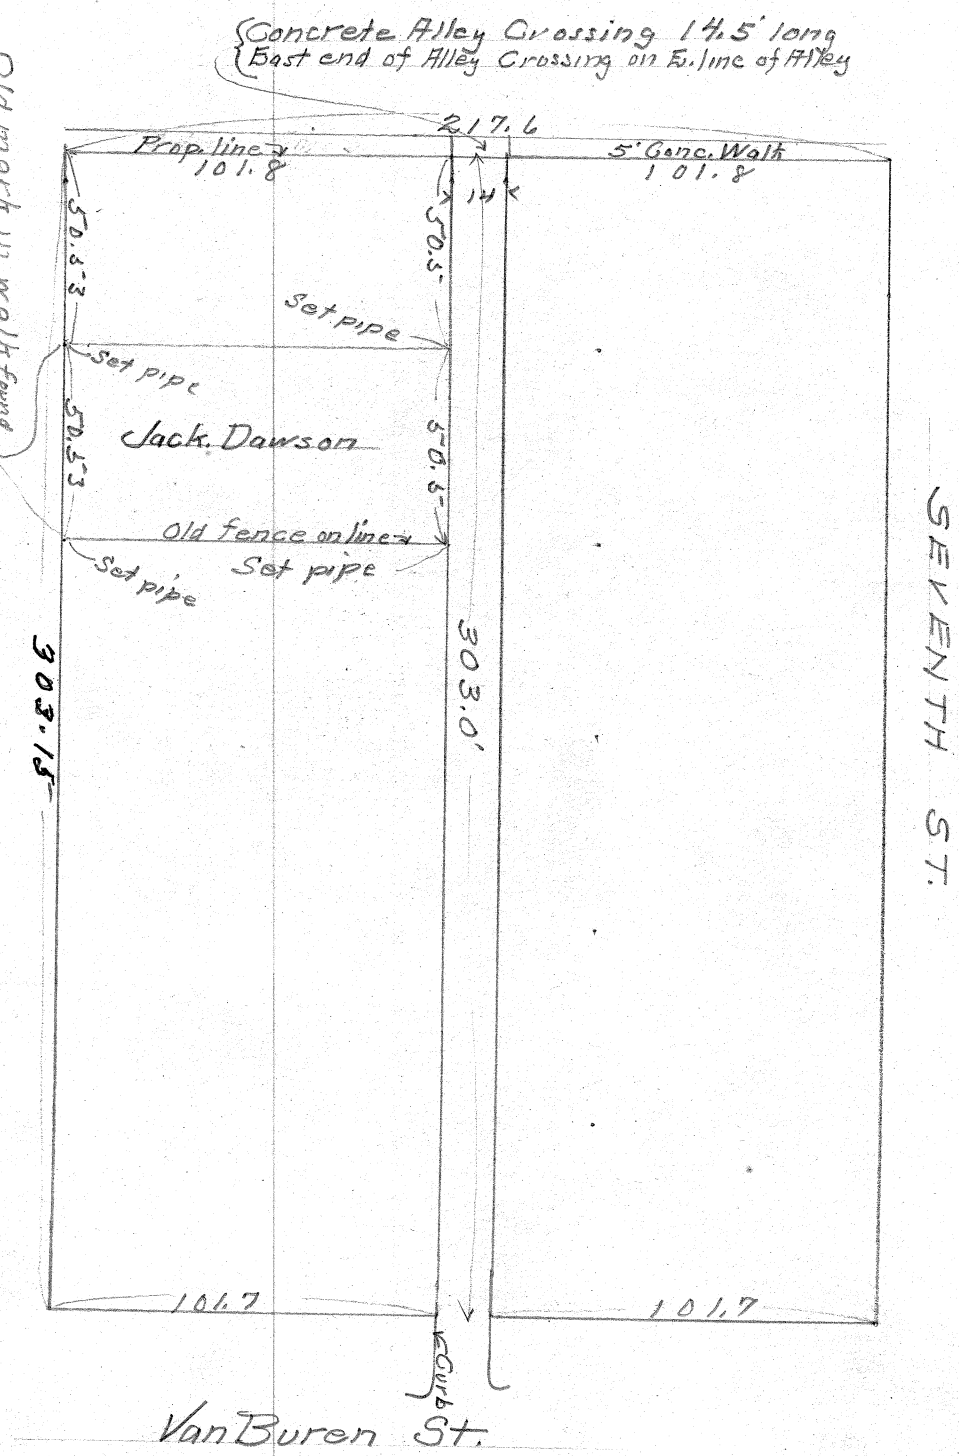

Aug. 12-1919

7