C.S. # 669

Hardcopy 11-5 #6

also see notes in file

F. B. 27-11

11

C.S. 669 F/B 27, PG. 11

C.S. #280

Beginning at ¼sec. cor. on S. of Sec. 10 T. 11S. R5W.

S 89° 47' W.

#869

	+1°30'	8.000 = 7.997
	+16°57'	6.222 = 5.952
	+7°20'	1.094 = 1.085
∠ Left + 49'	+ 6°	3.067 = 3.050
Left off running transit line and just measured	+2°45'	7.279 = 7.270
	+5°30'	2.822 = 2.809
	+12°45'	5662 = 5.521
	+ [illegible]	2.070 2,055
	+ [illegible]	4.200 4.198
		1.006 .006
Stone about right for cor. N.		39.943
	+1°40'	2.400 = 2.378
		.850 .850
	-10°5'	2.663 2.622
	-16°30'	2.223 2.128
	-21°54'	3.473 3.194
	-27°50'	2.233 1.975
		6.120 6.120
	+12°30'	8.000 7.815
	+19°48'	7.689 7.234
	+34°14'	1.224 = 1.012
	+22°33'	1.415 = 1.307
		1.442
		2.122
		40.199

Harper Mecklin Sept. 30, 1919.

11

	+12°30'	1.477
	+ 5°	2.130
East	+6°40'	3.613
	-6°15'	6.410
	-1°20'	2.287
	Short measure	1.500
	-31°58'	3.064
	-2°0°	2.652
	-9°	6.425
	-6°45'	3.373
	-15°30'	1.950
	27°41'	2.001
	-11°30'	4.902
	-5°30'	3.348
		.830
		.555 To line

stone 8"X8"X about 10" loose stones around

	3.589
	6.451
	2.237
	1.500
	2.613
	2.492
	6.346
	3.350
	.915
	1.846
	4.803
	3.333
	.275
	39.850

Fence Striking 1.61 S. of Wagon scene.

6.195
2.75
3.443

830
555
.275

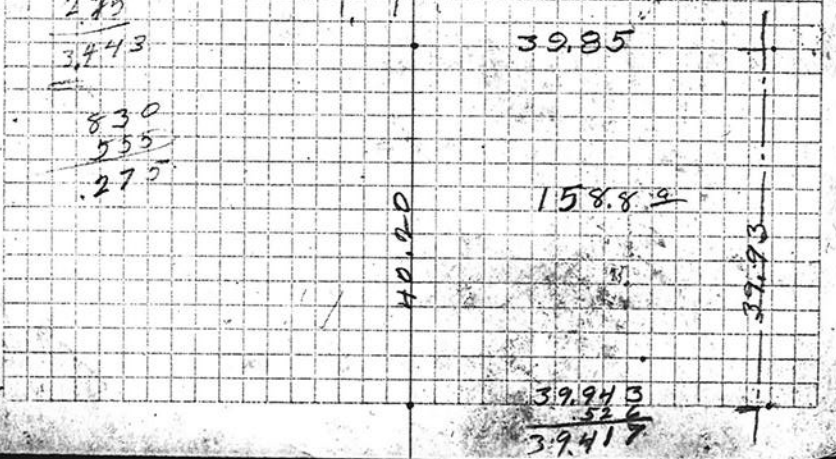

39.943
.526
39.417