C.S. # 674

Hardcopy 12-5 # 25

also see notes in file

F. B. 27-24

F/B 27, PG 24-26
CS 674

24 #674

C.S. #281

Beg. at S.W. cor. of Sec. 1 Seneca
31.2 ft. W. of SE. cor. (Cedar Knoll) on S. line
Grounds of Silas Newcomb Cl. 50 8/12/5
Δ O is North .116
E .002 Set ½" Pipe
+.143
8,859 S.113
1 Thence S 89° 59' W. 19.028 S.107
Correction N 1'
2 +4°40' 8.005 S.105
.140
3 +.053 to corner
4 N.393 to NE corner
+4°40' H.235
4
5 +12°15' 2.744
-.033
9 N.396
-.033
N.W. cor. of Ch. .104
Striking N. of cor.
6 S. 89° 59' W. +45' 6.472
Correction N 9' +.351
Striking N. of cor. .086
Small stone S. line cor. of Cl. 50
Back to Δ 1 Set W.143
7 North 8.158 From cor.
Correction E 12' +.842
E.031
Set ½" Pipe

111 .107

offsets.
.116 N.
.104 S.
.012 N. 42.29 | .012000 .00028 = 1'
85 58
34420
34232
1880
.00252
.00263 = 9'
6856 | .018000
13712
42880
41134
1746

Offsets
.104 N.
.086 S.
.018 N.
.002
.016

6856
82
137112
54845
.0019197

9.000
8.857
.143

8.857
19.028
7.978
.140
36.003
4.221
2.742
42.966
.033
42.933

42.933
9.000
33.933
.033
6.402
.351
40.784 6.856

4.221
2.742
6.963
.033
6.930
.053
6.877

25

8				16.018	
9				16.108	Cen. Road
	Striking E. of Stone			5.560	
	Should be 5.70				
10	S 89° 59' W.			5.560	Granite Stone
11				3.289	
Stone S.E. cor. of					Stone has been turned over S.E.
To ¾" pipe				.303	
From .012 N. of granite stone, N.E. of					Neutral
12	S. 3° 23' E.	correction 35' E. (3.3° 58' E.)		16.877	
13	S. 5° 09' E			8.222	To Stone
14	S. 29° 46' E.	correction 10' 30" N.E. = S. 31° 16' E.		7.326	-.096 ½" Pipe N.W. .084 N.E. .042
	N. 59° 40' E.			.236	To cor.
Back to Δ 7					
15	North			7.092	
16	West	correction N. 2'		3.815	
				-.045	
	Set ½" Pipe			16.000	
17			+1° 30'	7.688	
				N.018	
18	South			1.250	
	Set 12 9. gun bbl.			-.018	

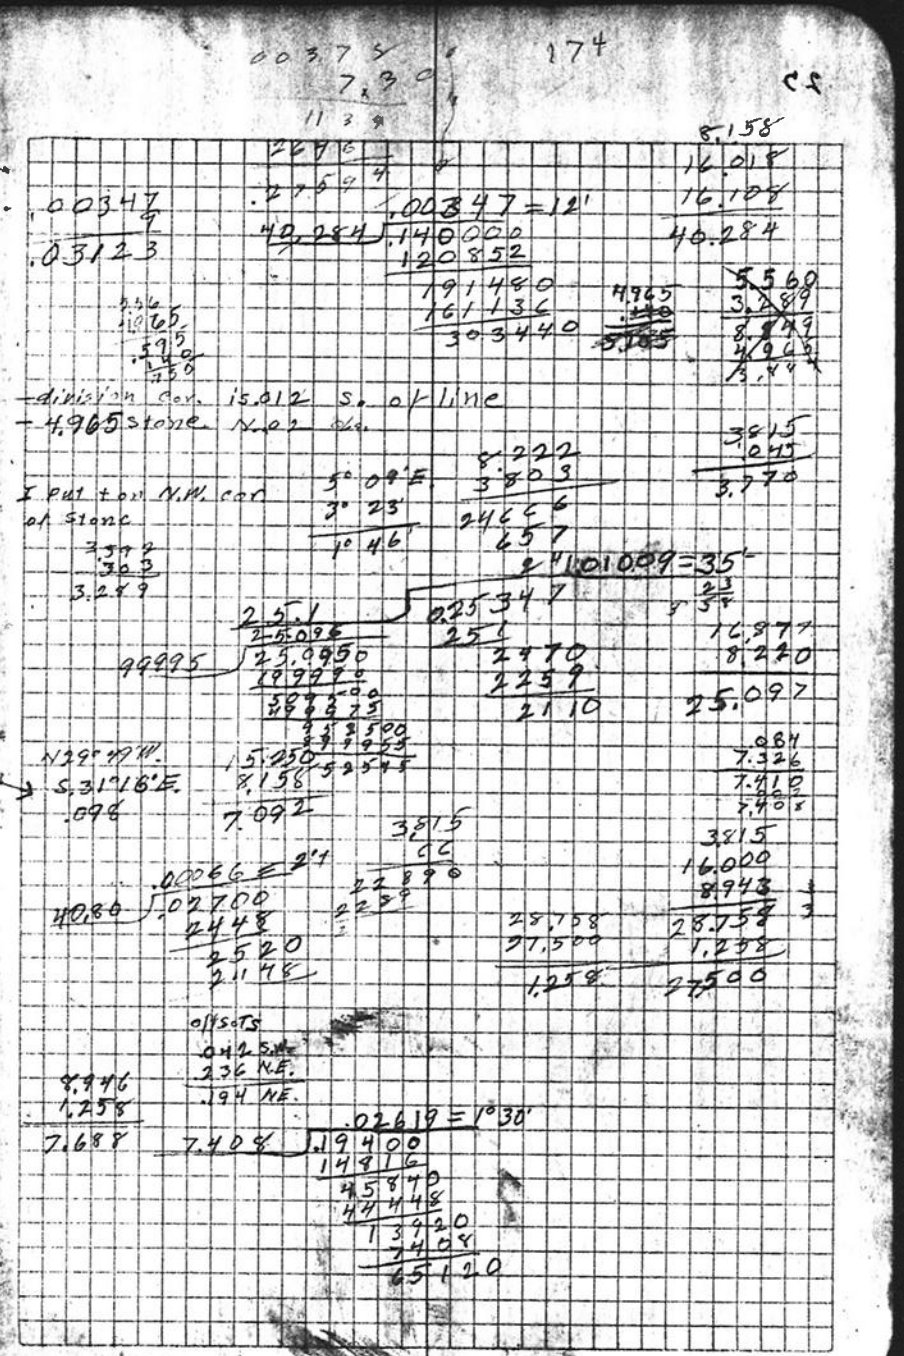
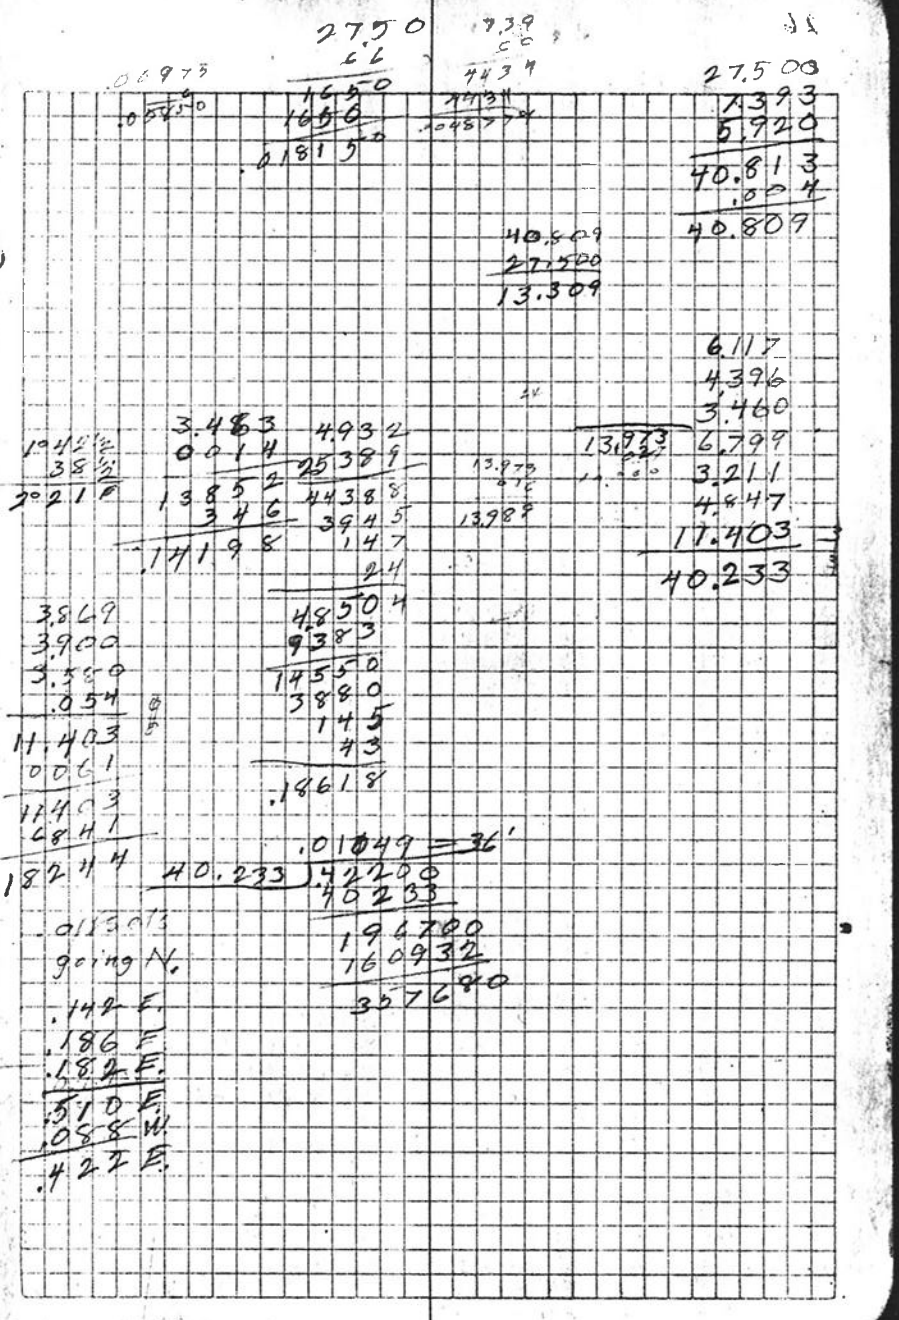
	West				
19		+2°45'	7.401	N.043	
20		+ 8'	5.978		
			+.004		
			N.047		
	Set 5/8" x 18" iron pipe.				
21	S. 0° 38 1/2' E.	+15'	6.120		
22	[illegible] N. 36'	-9°30'	4.400		
	∠ Right 2°21'	-6°15'	3.484	offset .142 W.	
	To S.W. cor. of [illegible]				
	∠ S. 1° 11' E.	N 89° 59' E	on bng.		
	Back to △ 20				
	N 0° 38 1/2' W.				
23	[illegible] E. 36'	+1'	6.800		
24		-0°30'	3.232		
25	∠ Right 2°21'	-10°35'	4.932	offset .186 E.	
	∠ Right 55'	-3°35'	3.877		
		-1°	3.900	offset .182 E.	
26		-2°10'	3.583		
			+.054		
	Bearing E. of [illegible]		.058		
	To S.W. cor. of [illegible]