#14

683

2.50
2
$5.00
$2.50 per lot

Jan. 23-1920

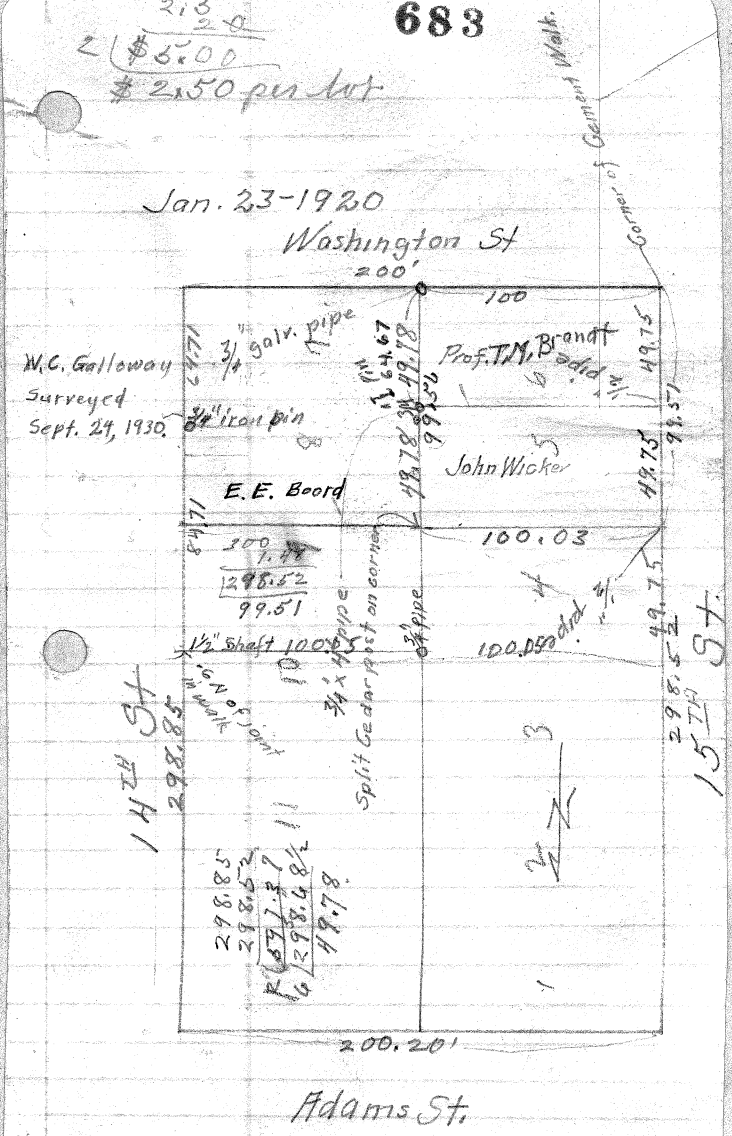

4975
24.87
74.62