Bl. 17 - MARKSVILLE

684

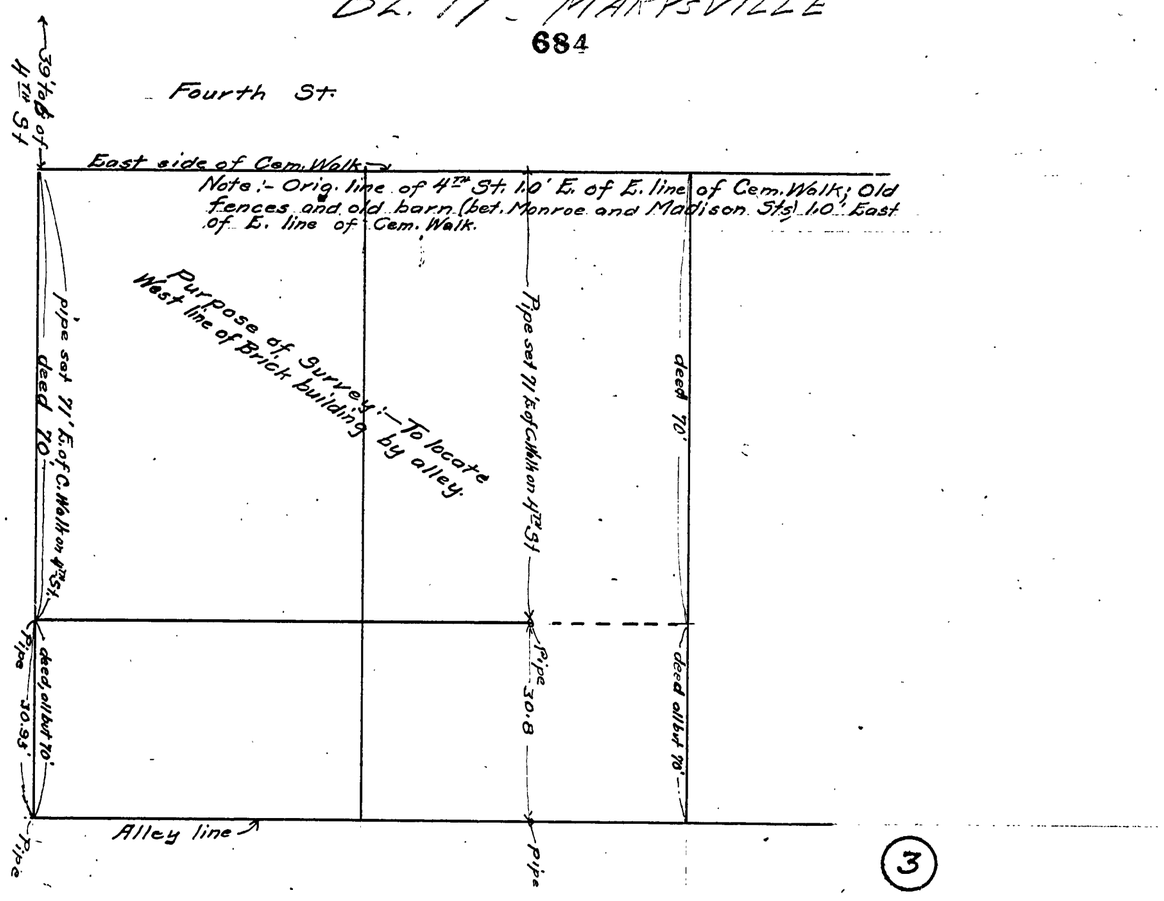

Block 17
Marksville

3